

Roo 059 Kampung Asin

Datum Daripada 328 5315 > 328 7873 / 4 29.13/ 11/5/09 29.13/

PA 21507

M- 7321

PL

2-3	162 5109	}	M- 7'32"	2	162 7832	3	4	11.133	pt-L	11.133
2-4	320 5128			2	162 7856	4	4	9.986	pt-L	9.986
2-5	47 5290			2	47 7808	5	4	37.290	pt-L	37.290

1 328 5315 198 5315 59 7825 > 59 7153 6 4 75.880 75.880

2

M- 7'32"

6 59 7825 289 7825

pt-B

2 289 7825 59 7825 186 1903 6 186 1931 7 4 47.729 47.729

6

M- 7'32"

Aj At.

7 186 1903 378 1903

Aj M4

pt-B

2 Segments Di Atas 187 2501 6 187 2829 8 4 15.879 15.879

6

M- 7'32"

8 187 2501 > 2501

pt-L

2 Segments Di Atas 325 7223 6 325 7251 9 4 37.956 37.956

6

M- 7'32"

9 325 7223 185 7223


pt-B


Demarcation.

5-A	152 2138	12.989	pk.B
5-B	176 5928	7.961	pk.B
5-C	130 2255	5.320	AB
5-D	350 7718	7.638	pk.B
5-E	52 0902	71.697	pk.B
5-F	79 5746	42.372	AB
5-G	97 5513	23.930	AB

$$\begin{array}{r}
 282 \ 08 \ 23 \\
 5-7 \ 750 \ 22 \ 05 \\
 282 \ 09 \ 71 \quad 37.998 \ 00 \\
 \hline
 -1.18' \quad -0.05
 \end{array}$$

$$\begin{array}{r}
 53 \ 218 \ 16 \ 21 \quad 73.137 \ 7 \\
 218 \ 18 \ 31 \quad 73.150 \ 00 \\
 \hline
 -2' \ 10'' \quad -0.023
 \end{array}$$

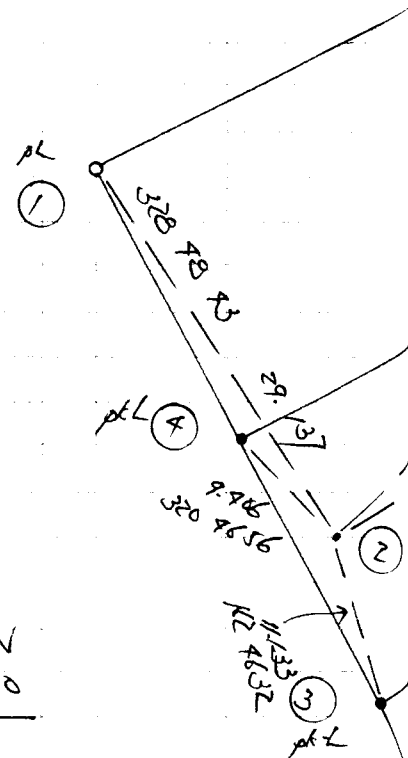

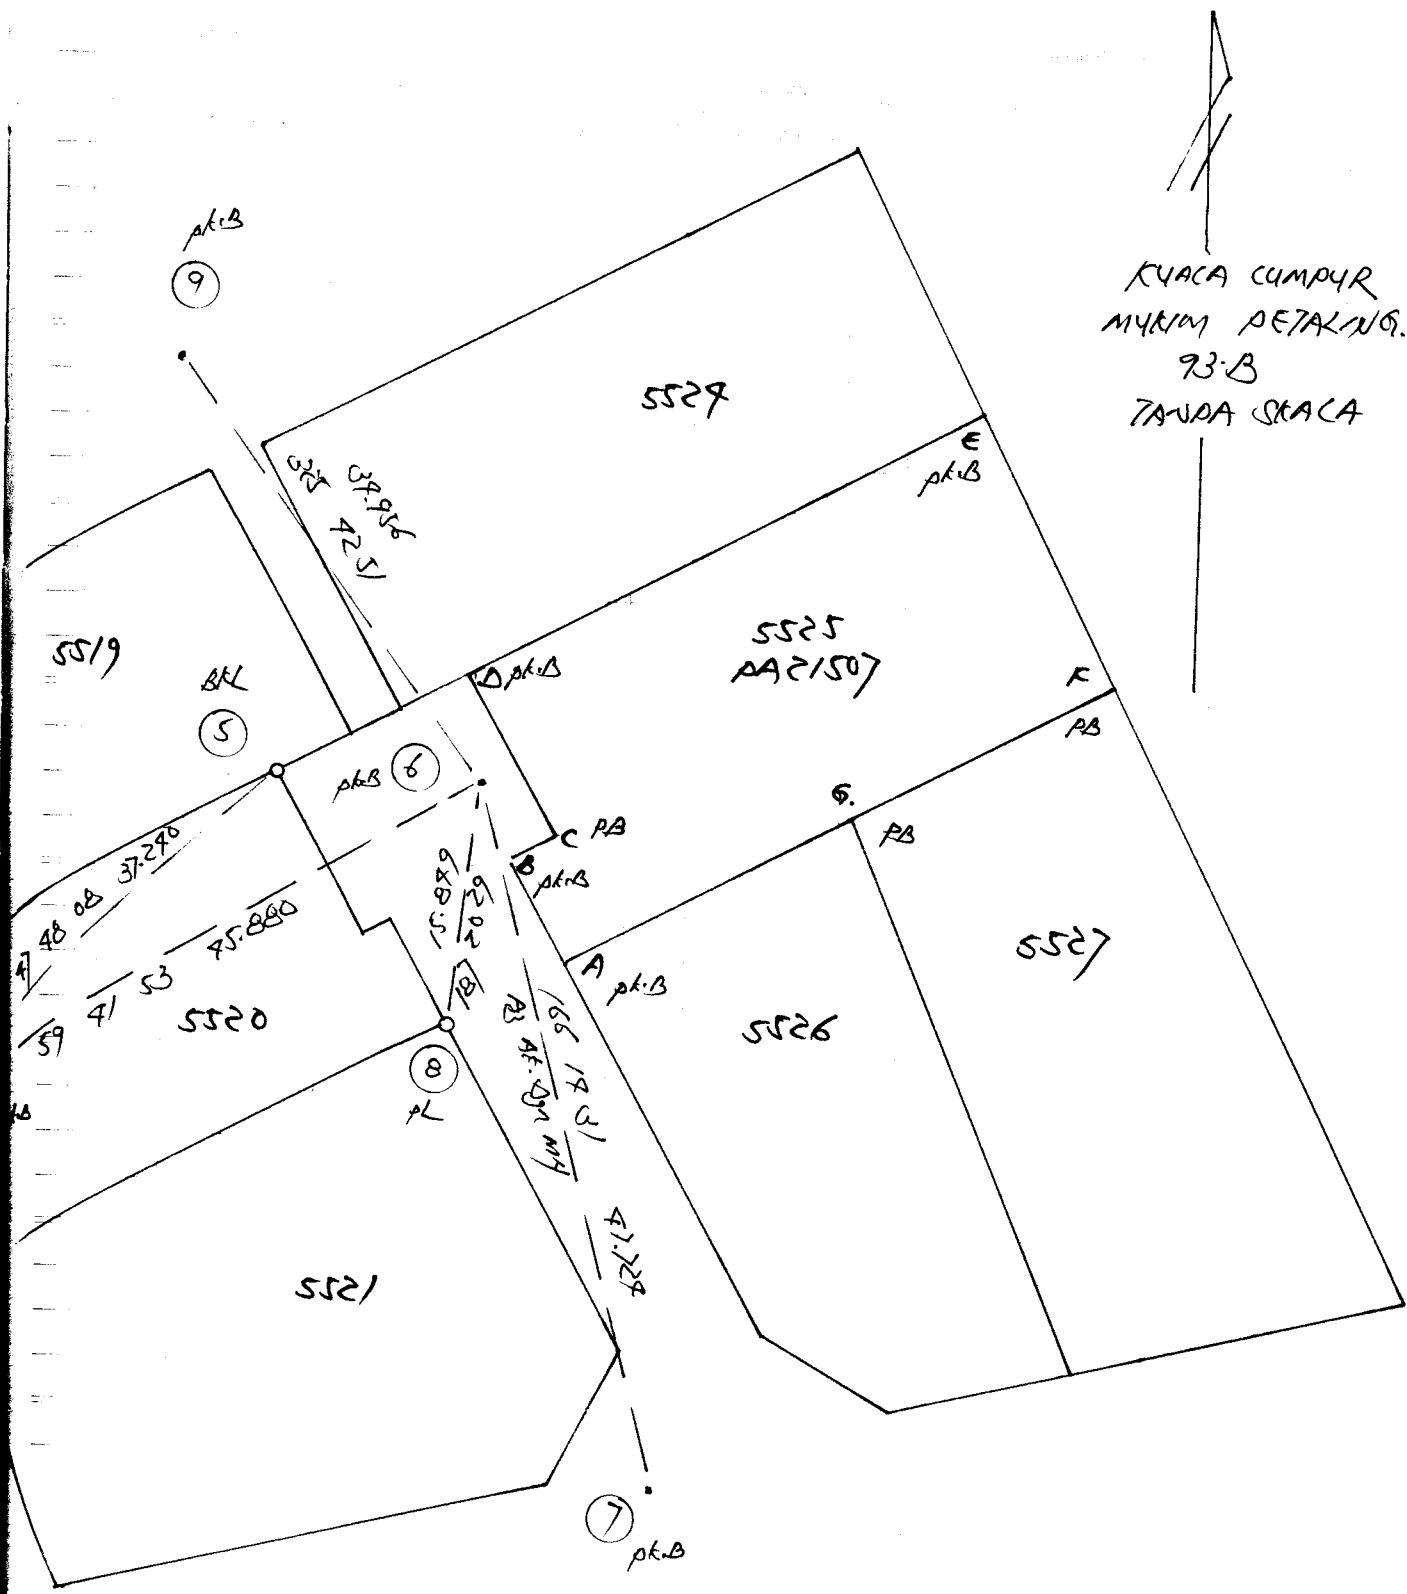

KUACA CUMPHR
MYKIM PETAKING.
93.B
TANDA SKACA