



SCALE : 1 : 750
STD SHEET : 93-D & 101-B
CONTOUR INTERVAL : 1 METRE

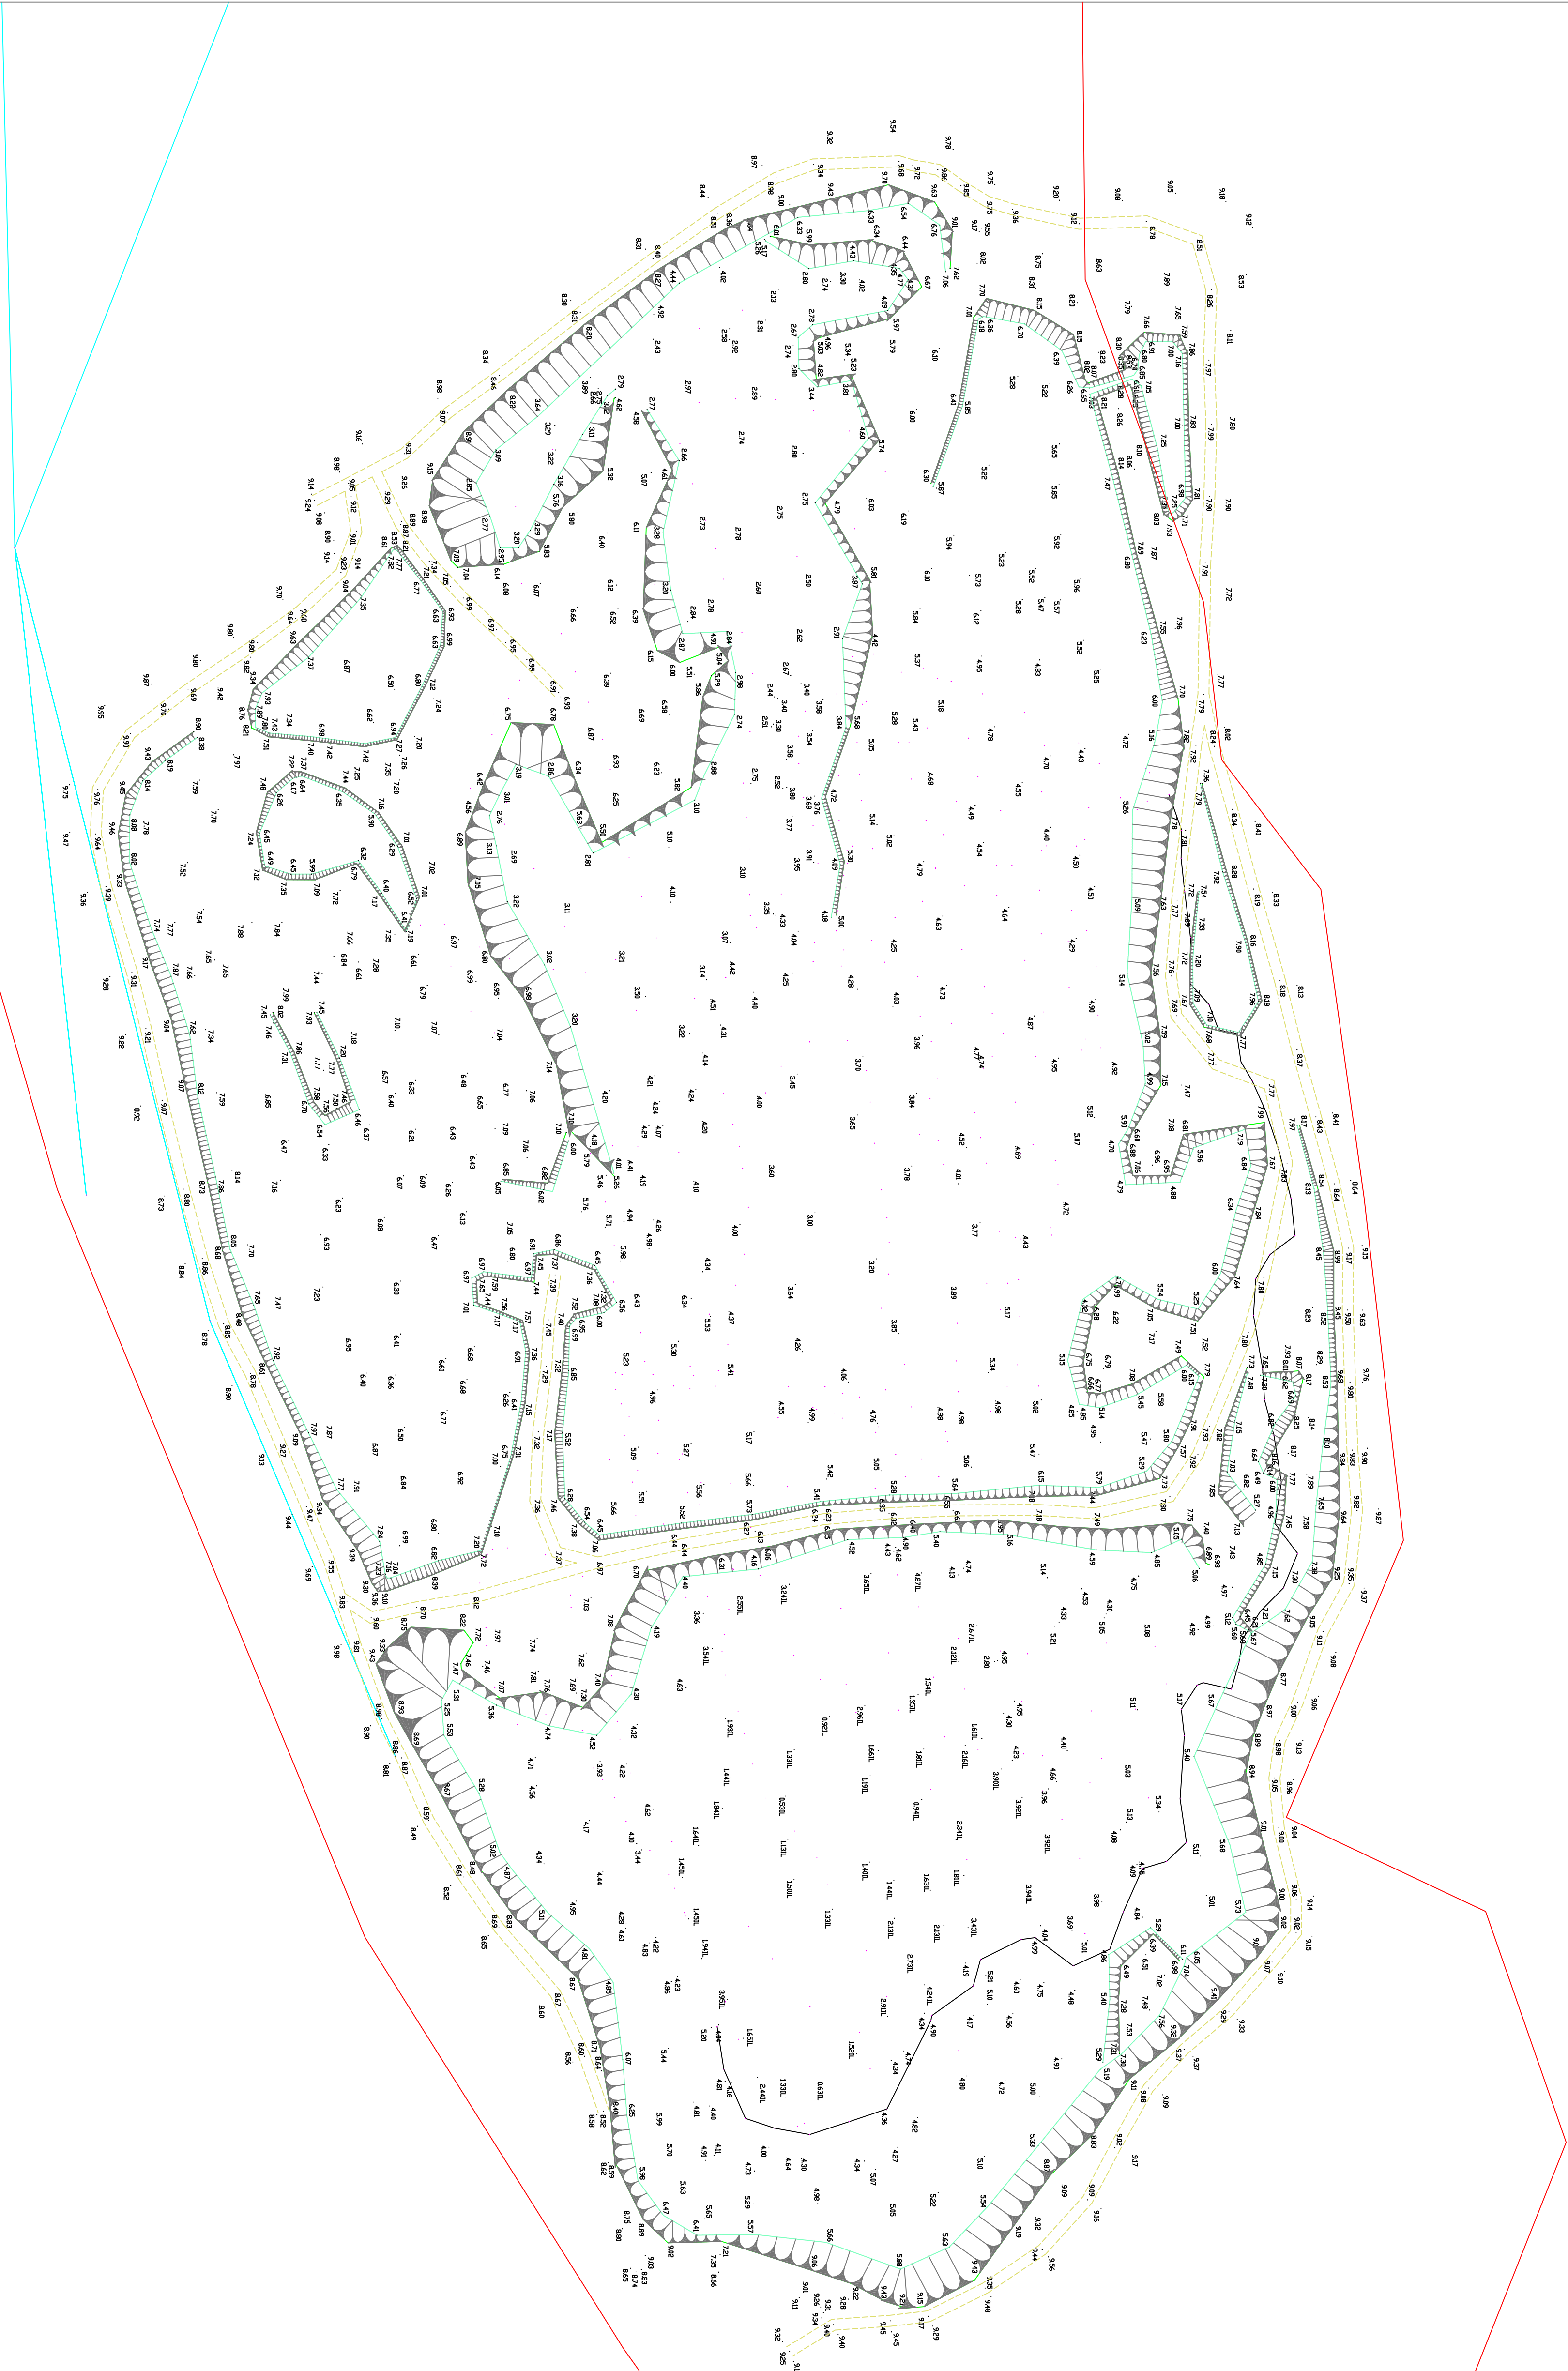

PELAN LOKASI

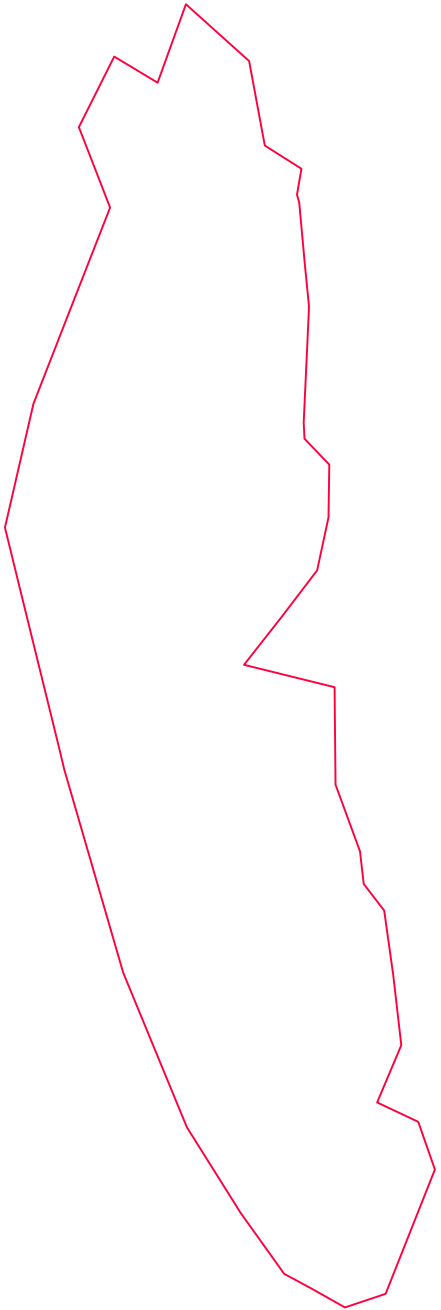

SURVEYED BY : FOO (012-2819844) 27-10-2017

DRAWN BY : ERNA

CHECKED BY : FOO

SURVEY DATA :

LICENSED LAND SURVEYOR

PLAN NO : KSN / SEL