


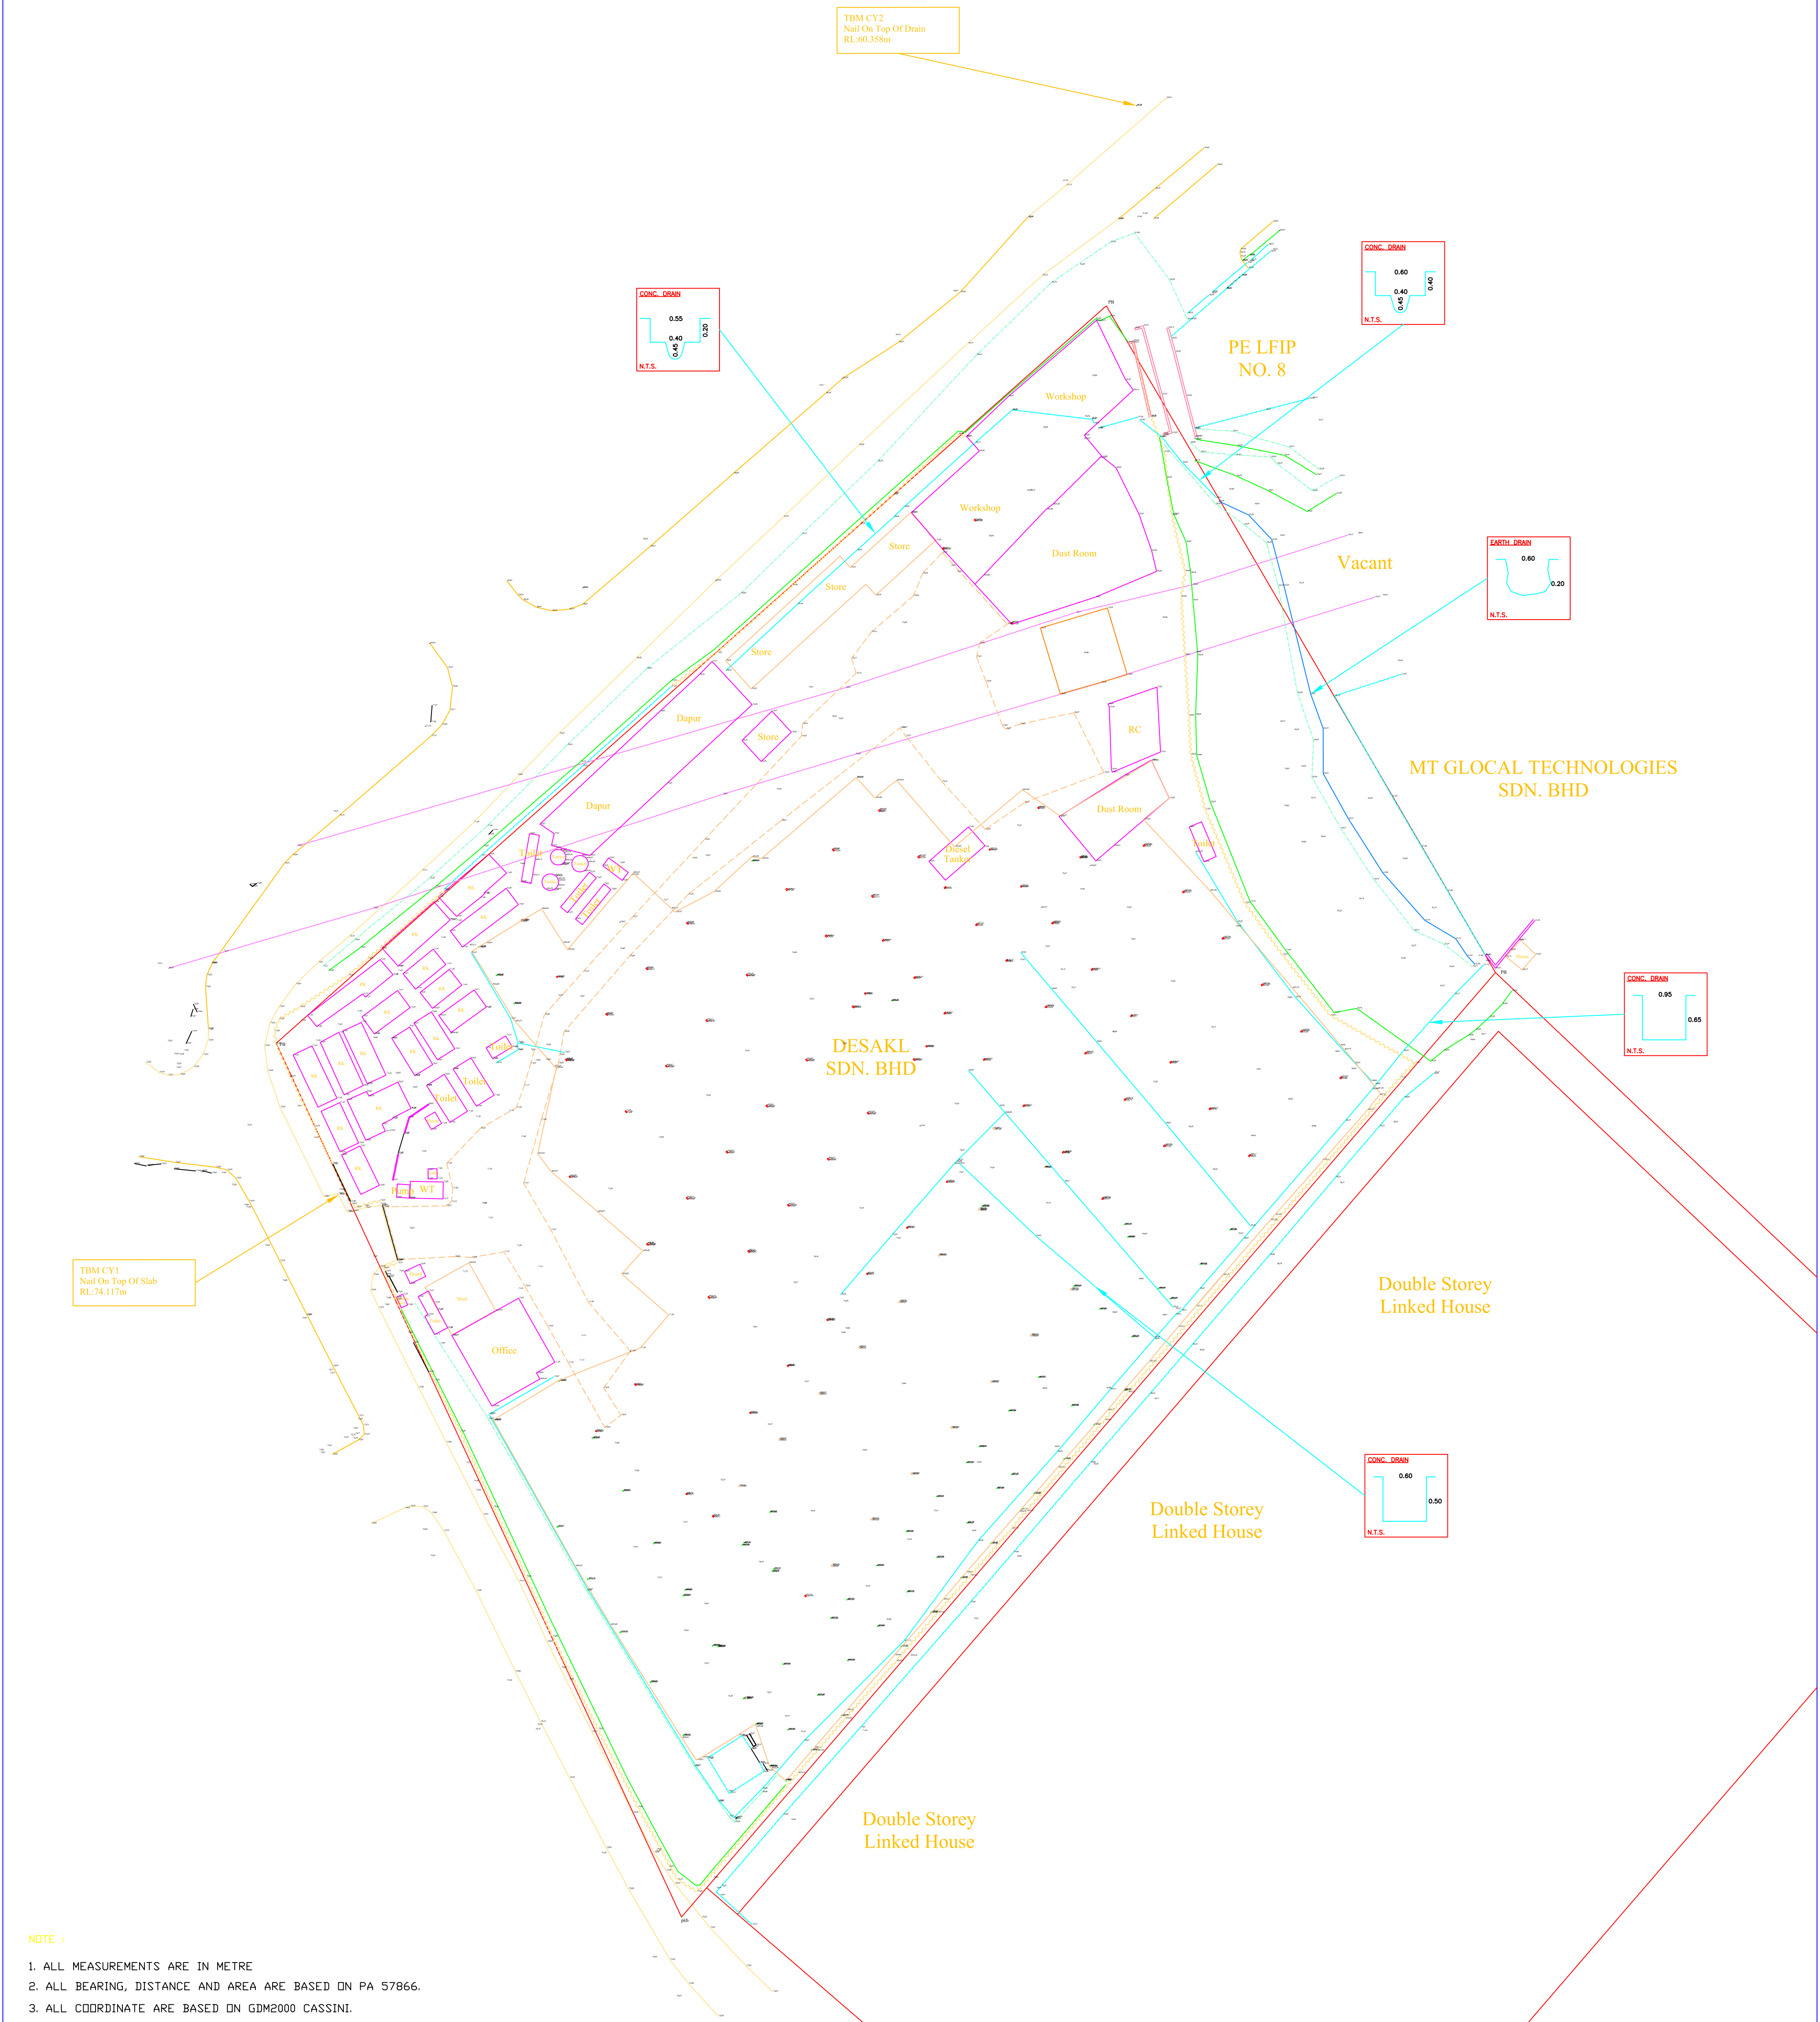

- NOTE :
1. ALL MEASUREMENTS ARE IN METRE
 2. ALL BEARING, DISTANCE AND AREA ARE BASED ON PA 57866.
 3. ALL COORDINATE ARE BASED ON GDM2000 CASSINI.
 4. ALL LEVELS ARE BASED ON BM B1091 (RL=13.407m). ON THE LEFT OF JALAN PUCHONG - FEDERAL HIGHWAY. IN FRONT OF ELEXTRDLUX FACTORY 100m TO THE JUNCTION THAT CROSSES THE FEDERAL HIGHWAY.

PLAN TITLE :

DETAIL AND SPOT LEVEL SURVEY
ON LOT 59, SEKSYEN 15
BANDAR SHAH ALAM
DAERAH PETALING
SELANGOR DARUL EHSAN

- LEGEND :
- | | |
|---------------------------|------------------------------|
| ○ RS : ROAD SIGN | □ MHST : MANHOLE SEPTIC TANK |
| ○ LP : LAMP POST | □ MH : MANHOLE |
| ○ TV : CCTV | △ BV : BOMB VALVE |
| ○ BKL : OLD CONCRETE MARK | △ HY : HYDRANT |
| ○ PKB : NEW NAIL | △ GM : GAS MARKER |
| □ SB : SIGNBOARD | △ TNBM : TNB MARK |
| □ EB : ELECTRIC BOX | △ TBM : TEMPORARY BENCH MARK |
| □ TB : TELEPHONE BOX | ○ GATE |
| □ MHN : MANHOLE TNB | — IRON RAILING |
| □ MHTM : MANHOLE TM | — CHAIN LINK FENCE |
| □ MHJ : MANHOLE JBA | — FOOTPATH |
| | — METTALED ROAD |

PROJECT TITLE :

JURUKUR TANAH BERLESEN

Sr. LIM THEAN SEANG
Jurukur Tanah Yang Dilesen
Dibawah Akta 458 (Disemak 1991)
METRO SURVEY CONSULTANTS
No. B4-12, Block 8, PJ Industrial Park,
Lot 2, Jalan Kemajuan, Sect. 13,
46200 Petaling Jaya, Selangor Darul Ehsan
Tel.: 03-7954 3315/6 Fax.: 03-7954 3318
Email: mcsur@ymt.com

SCALE 1 : 500

SURVEYED BY	FOO	22 JUNE 2020
DRAWN BY	ERNA	23 JUNE 2020
CHECKED BY	FOO	23 JUNE 2020
DATE	JUNE 2020	
PLAN NO : CY/910/SEL-2020		