

TDC ENGINEERING CONSULTANTS SDN BHD 200001003772 (506377-M)**Civil, Structural & Geotechnical Consultants**

6B Jalan Anggerik Vanilla M 31/M, Kota Kemuning, Seksyen 31, 40460 Shah Alam, Selangor Darul Ehsan, Malaysia
Tel: 603-51240869 (Hunting Line) Fax: 603-51240864 E-mail: general@tdceng.com.my

ENGINEER INSTRUCTION NO: (02)

To	: NSK Construction & Engineering S/B	Date	: 11 th January 2022
Attention	: Mr Ng Chong Hoe / Teo Peng Hua	By email	: enquiry@nskce.com
From	: Ir. Cheah Chee Fong	Our Ref	: TDC/H/7463/EI(02)
Project	CADANGAN TAMBAHAN DAN PINDAAN KEPADA SEBUAH GEREJA DUA TINGKAT SEDIA ADA DAN SATU UNIT TEMPAT PEMBUANGAN SAMPAH DI NO. 7, PERSIARAN ANGERIK VANILLA, SEKSYEN 31, 40460 SHAH ALAM, SELANGOR DARUL EHSAN UNTUK TETUAN: THE SECRETARY OF THE TRUSTEES OF THE METHODIST CHURCH IN MALAYSIA		
Subject	~ <i>Footing Details for Temporary Toilet</i>		

MESSAGE

(No. Of Pages: 1+drawing)

We refer to the site inspection today.

Due to the existing cable, we forward herewith the revised construction drawing for your further action.

Thank you.

The above instruction does not constitute any variation in cost and time. Otherwise, the contractor shall give notice within fourteen (14) days of this instruction. The cost variation shall be verified by the Quantity Surveyor.

For TDC Engineering Consultants Sdn Bhd

Received by NSK Construction & Engineering Sdn Bhd



Ir. Cheah Chee Fong

Name : _____

Date : _____

Copy : SACMC


Design Collective Architects
Perunding JC Yeo
TL Associates
Foo Comp (surveyor)

: Mr Chang Loo Hin / Mr Gan Oh Lai / Mr Alan Boey
: Mr Alex / Mr Tony Tan / Mr Low Xun Ji
: Ms Joe Ng / Mr Ho Ji Wei
: Mr Jimmy
: Mr Yong Boon Xiong
: Mr Foo Chee Yong


By email
By email
✓
✓
Directors: **Ir. Dr. Kem Yah** BSc. (Eng) PhD MBA MIEM P. Eng MICE C. Eng FGS **Ir Cheah Chee Fong** B.Eng MSc (Eng) MIES MIEM P.Eng

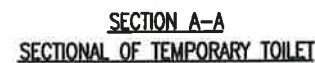


COLUMN SCHEDULE		
ROOF LEVEL TO GROUND FLOOR CONCRETE GRADE 30		
SIZE		300 x 125
BARS		6T12
LINKS		T10-125
COLUMN MARKING		

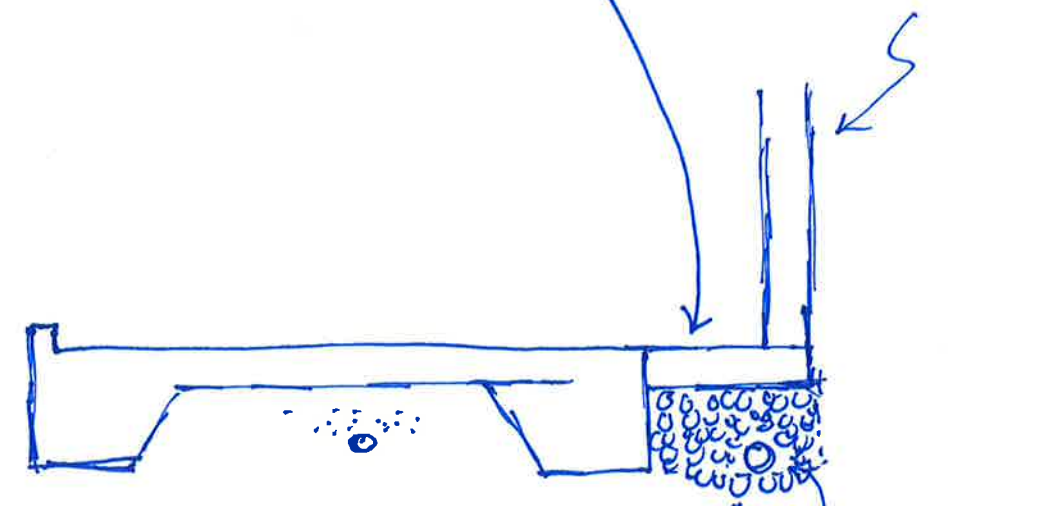

Section B-C

Backfill with
well-compacted
crusher run

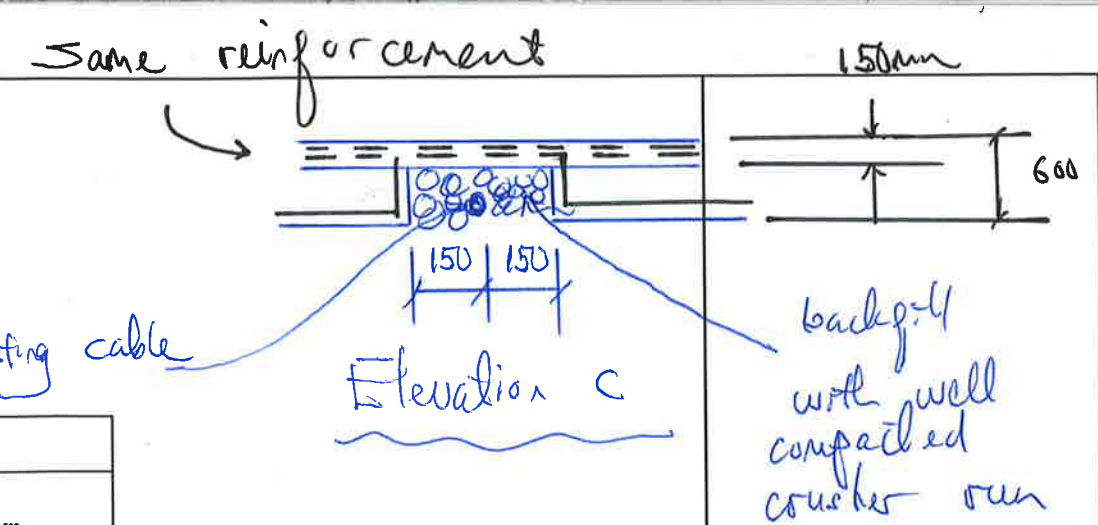

2022	1		check
DATE	REV.	DESCRIPTION	BY

PEMILIK	
---------	--

**THE SECRETARY OF THE TRUSTEES
OF THE METHODIST CHURCH IN MALAYSIA**
*No. 69 Jalan 5/31 46000 Petaling Jaya
Selangor Darul Ehsan*

ARKITEK

design collective architects d.c.a
67, jalan es 22/16, damansara jaya, 47400 petaling jaya, selangor, malaysia
tel: +603 7727 0199 fax: +603 7723 3199 www.dca.com.my

TANDATANGAN JURUTERA

CONSULTANTS
TDC **TDC ENGINEERING CONSULTANTS SDN. BHD**
(Civil, Structural And Geotechnical Consultants)

6B, JALAN ANGGERIK VANILLA M 31/M
KOTA KEMUNING, SEKSYEN 31,
40460 SHAH ALAM, SELANGOR DARUL EHSAN
TEL: 03-51240862/0863/0869 FAX : 03-51240864

Tajuk Cadangan :

**CADANGAN TAMBAHAN DAN PINDAAN KEPADA
SEBUAH GEREJA DUA TINGKAT SEDIA ADA DAN
SATU UNIT TEMPAT PEMBUANGAN SAMPAH
DI NO. 7, PERSIARAN ANGERIK VANILLA,
SEKSYEN 31, 40460 SHAH ALAM
SELANGOR DARUL EHSAN**

UNTUK TETUAN:-
THE SECRETARY OF THE TRUSTEES
OF THE METHODIST CHURCH IN MALAYSIA

TAJUK LUKISAN

TEMPORARY TOILET KEY PLAN AND SECTIONAL OF TEMPORARY TOILET

DRAWN BY	GS TAN
DESIGN BY	MURUL
CHECKED BY	CF CHEAH
SCALE	AS SHOWN
DATE	DEC 2021

DRAWING NO.
TDC/H/7463/TEM/01/REV.0

DRAWING STATUS
CONSTRUCTION DRAWING