
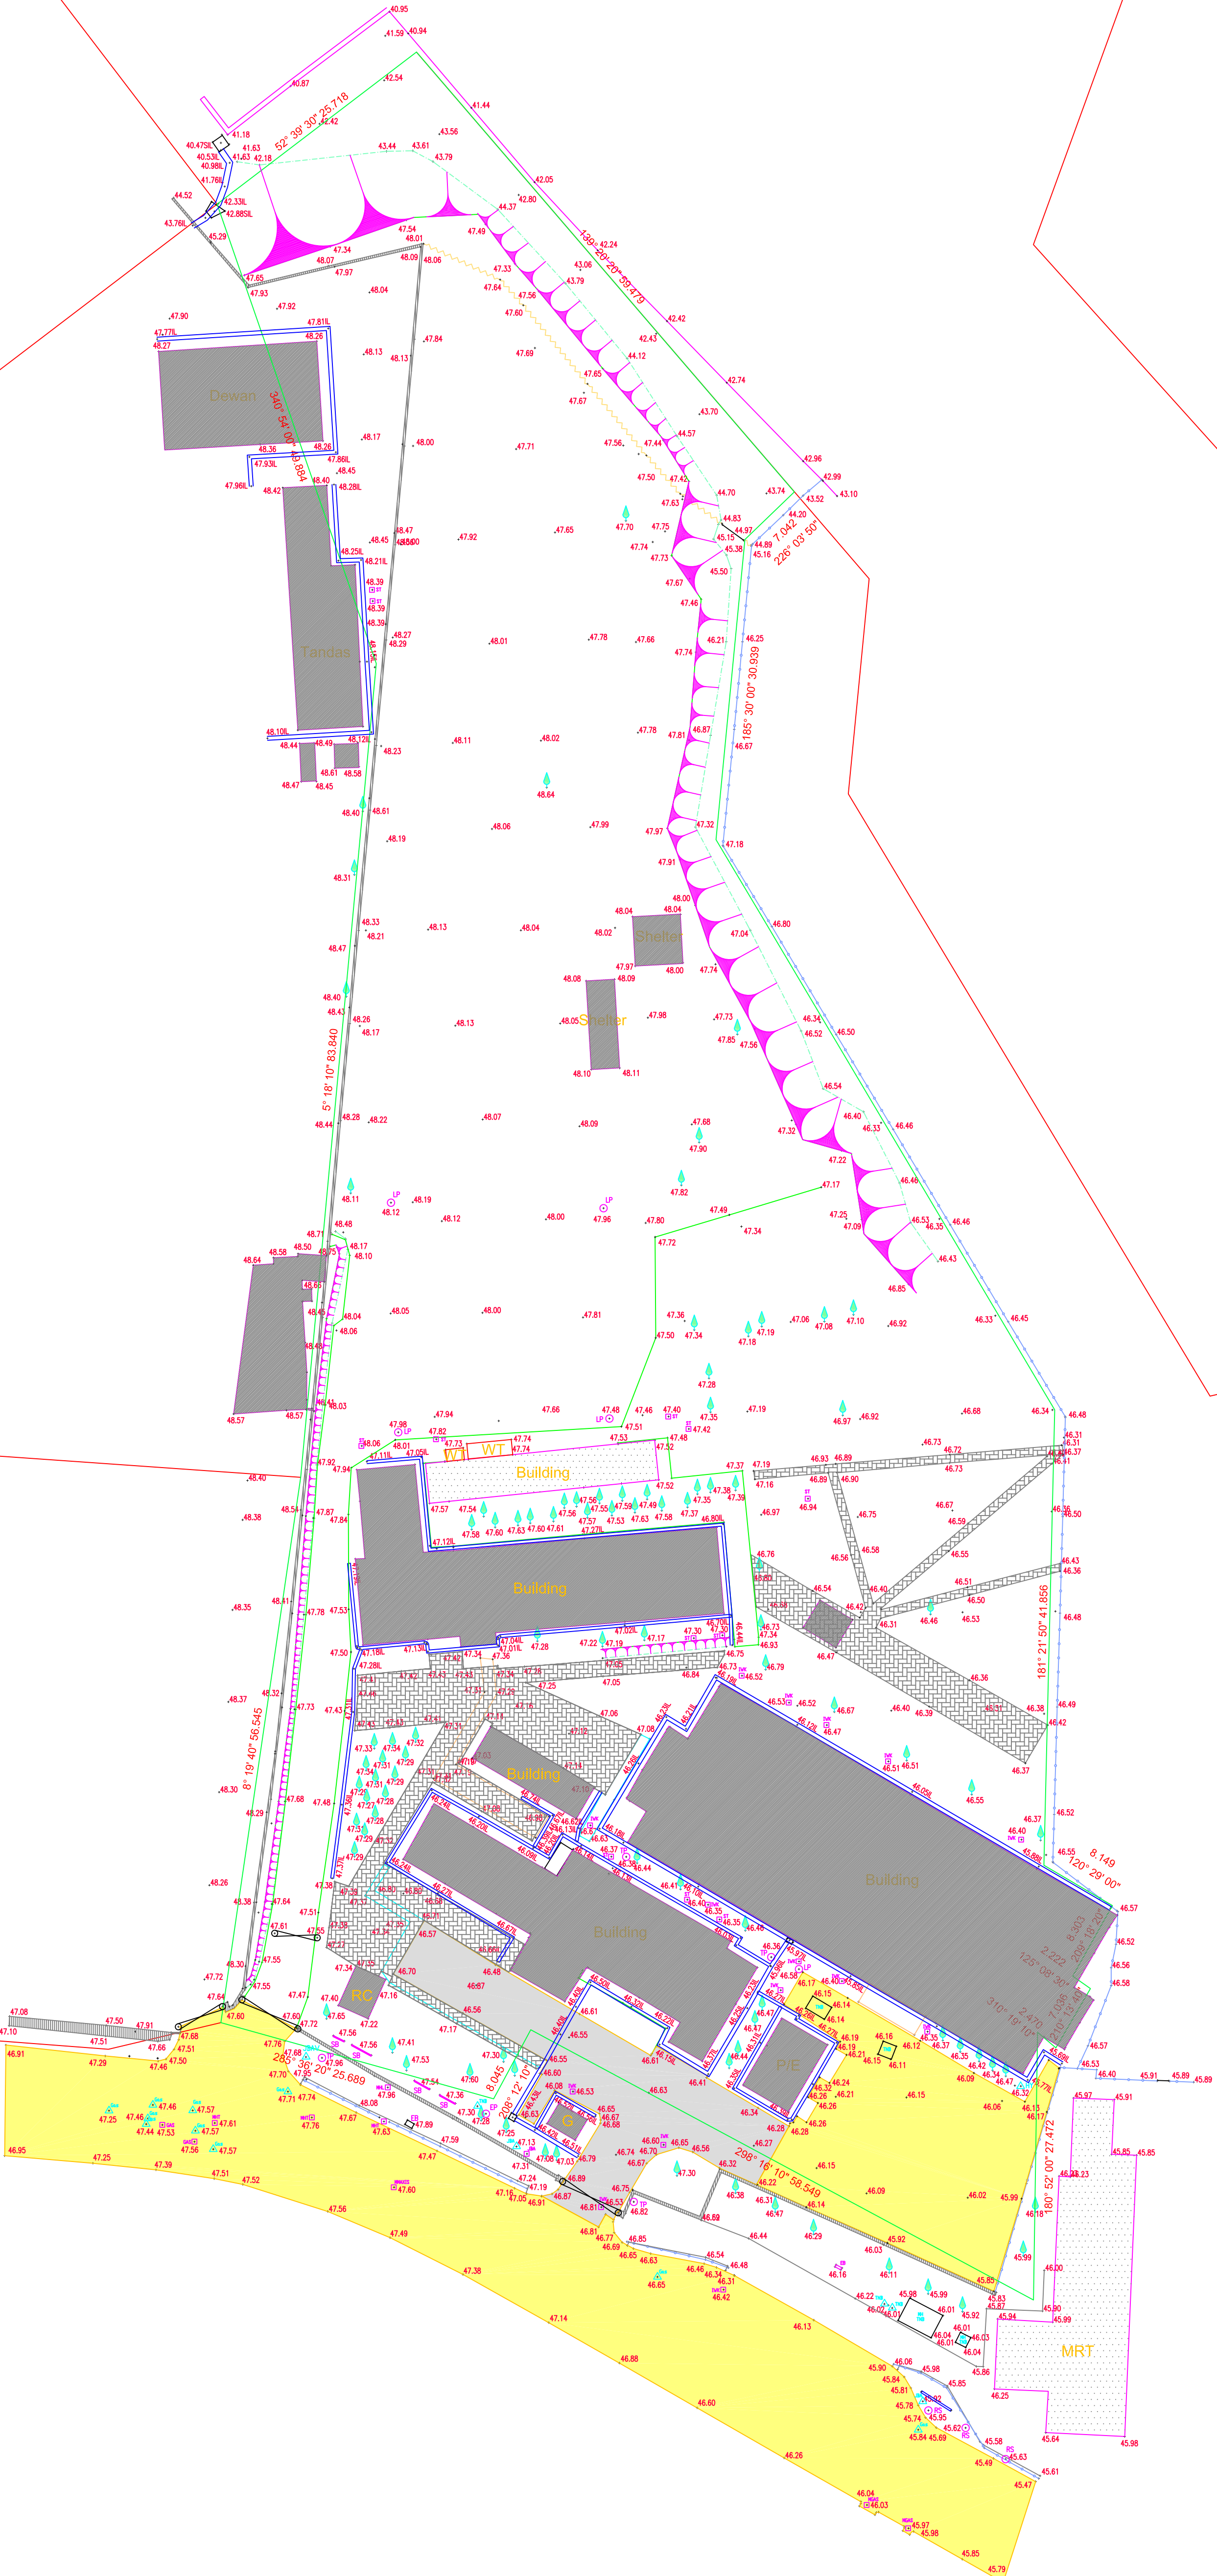


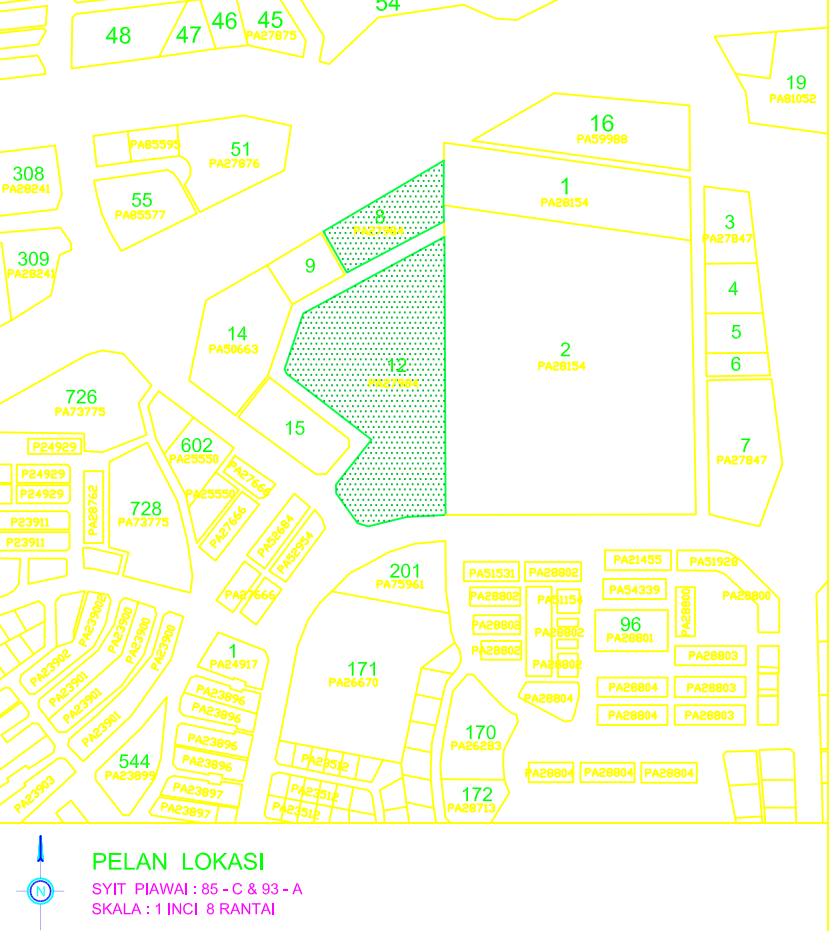

TAJUK PELAN :
UKURAN BUTIRAN DAN TOPOGRAFI
DI ATAS PT 11 (DAHULUNYA LOT 8) DAN 12
JALAN BARAT, SEKSYEN 26
BANDAR PETALING JAYA, DAERAH PETALING
SELANGOR DARUL EHSAN

- NOTA :
1. SEMUA UKURAN ADALAH DALAM UNIT METER.
 2. SEMUA BERONG, JARAK DAN KELUASAN YANG DITUNJUKKAN ADALAH BERDASARKAN KEPADA PA 27984.
 3. ARAS LARAS ADALAH BERDASARKAN BM 80505 (RL=27.865M) DIKIRI LEBUHRAYA PERSEKUTUAN OKLUMPUR-KLANG. BERNAMPUKAN DENGAN PENAMPAK 100 M DARI ALAM.

- PETUNJUK :
- | | | | |
|----------------------------|------------------------------|-----------------------|-------------------|
| WPL : WATER PIPELINE | Δ JBAV JBA VALVE | □ MHX : MANHOLE MAXIS | 🌳 : TREE |
| CPL : CABLE PIPELINE | Δ JBAH JBA MARKER | □ MHB : MANHOLE TNB | 🌳 : PINANG TREE |
| EP : ELECTRIC POST | Δ TBH : TEMPORARY BENCH MARK | □ MHPB : MANHOLE PB | 🚦 : TRAFFIC LIGHT |
| LP : LAMP POST | □ HP : METER PARKING | □ MHPJ : MANHOLE MBPJ | 🚰 : GUARD HOUSE |
| RS : ROAD SIGN | □ EB : ELECTRIC BOX | — : CHAIN LINK FENCE | |
| TP : TELEPHONE POLE | □ SB : SIGN BOARD | — : WOODEN FENCE | |
| PP : PUBLIC PHONE | □ HP : METER PARKING | — : FENCE WALL | |
| HY : HYDRANT | □ MH : MANHOLE | — : FOOTPATH | |
| VL : VALVE | □ MHT : MANHOLE TELEKOM | — : ROAD | |
| LVM : LARGE VOLTAGE MARKER | □ MHL : MANHOLE JBA | — : GATE | |
| | □ MHP : MANHOLE JPP | | |

JURUKUR TANAH BERLESEN
DILUKUR OLEH : FOD 27 NOV 2012
DILUKUIS OLEH : ENWA 03 BIS 2012 / TED 26-09-13
DISEMAK OLEH : LDH

Sp. LDH SDW KAM
DIBAWAH AKTA 458 (DISEMAK 1991 :
B. SURV. LAND C HENS) UTM, MSM, MAAS



JURUKUR BANDARDESA
NO. 17-3, JALAN USJ 9/50
SUBANG BUSINESS CENTRE
47600 SUBANG JAYA,
SELANGOR DARUL EHSAN
TEL : 603-8023 0963
FAX : 603-8023 0968
email : bbandaridesa@yahoo.com

NO. PELAN : JBD / SEL / 285 / A / TP3A