



SKALA
1:600(A3)

188
PA79495

189
PA79495

190
PA79495

191

JALAN TPP 5/1

pkB 53°46'40" pkB
8.215

101°24'50"
39.622

S 15804.8
B 11403.3
pkB

42.672
191°24'50"

195
PA79495

194

196
(PT 9)
3529 mp

6°08'30"
73.517

42.672
191°24'50"

197
PA79495

198



pkB 53°46'40" pkB
9.008

31.747
281°24'50"

pkB

JALAN TPP 5/1

201
PA79495

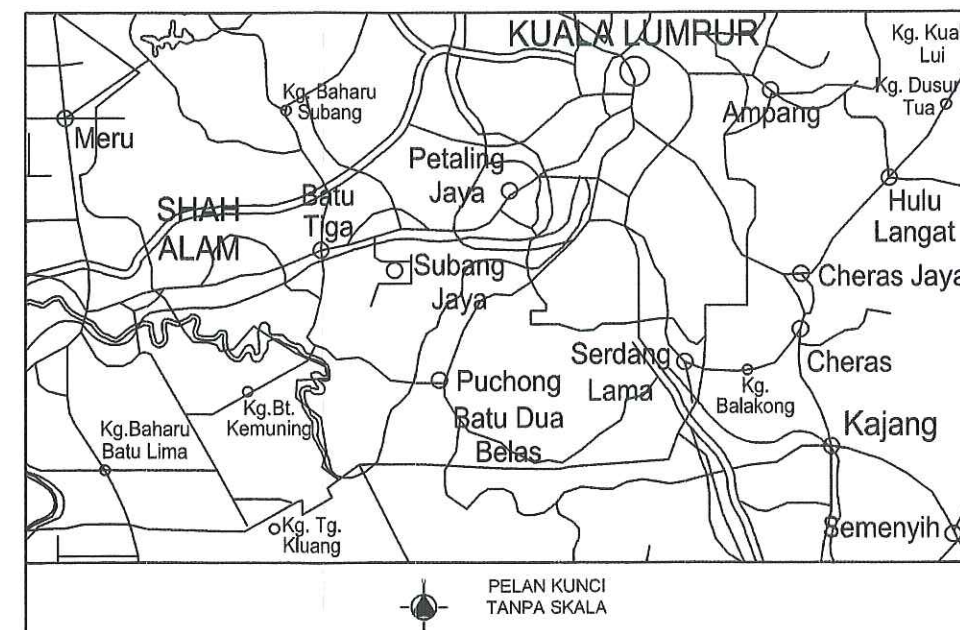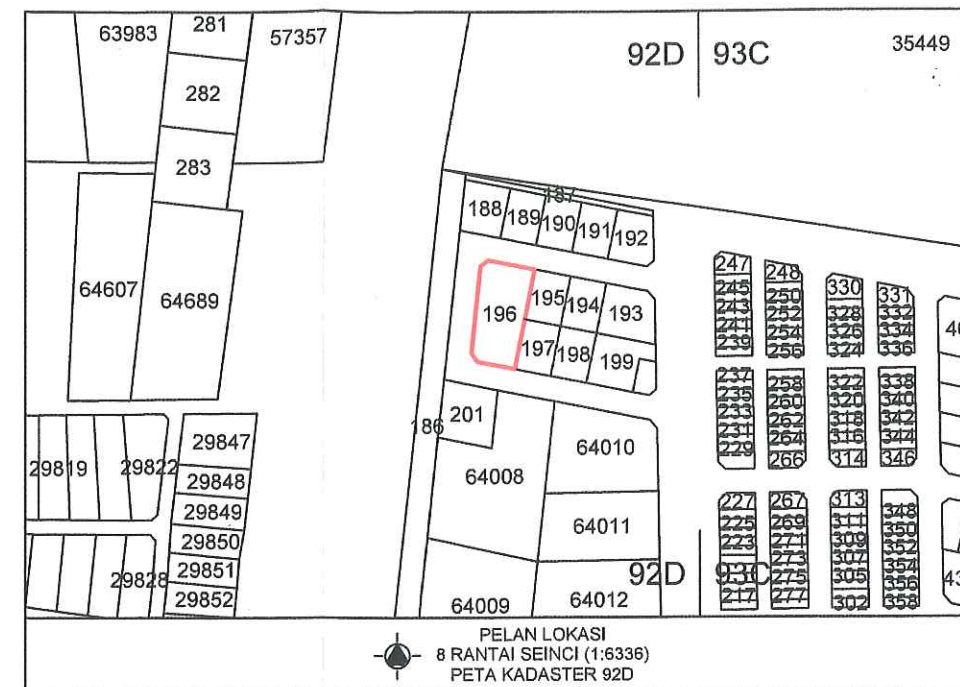

TAJUK UKURAN DEMARKASI SEMPADAN DI ATAS LOT 196 (PT 9) JALAN TPP 5/1 TAMAN PERINDUSTRIAN PUCHONG PEKAN DESA PUCHONG DAERAH PETALING SELANGOR DARUL EHSAN		JURUKUR TANAH BERLESEN AJM UKUR RUNDING Jurukur Tanah Berlesen No. 21-2, Jalan Opus D, USJ/D Taman TTDI Jaya, 47150 Shah Alam Selangor Darul Ehsan Tel: 03-7645 8872 Email: ajm_ukurunding@yahoo.com	
PETUNJUK pkB PAKU BARU		DIUKUR : HAFIDZ	DISEMAK : MHZ
		DILUKIS : ZAID	TARIKH : 30-10-23
		No. FAIL : AJM/S/27/2023(A)	
		No. PELAN : AJM/S/27/2023(A) LOT 196	