


S. 24 000
W. 13200

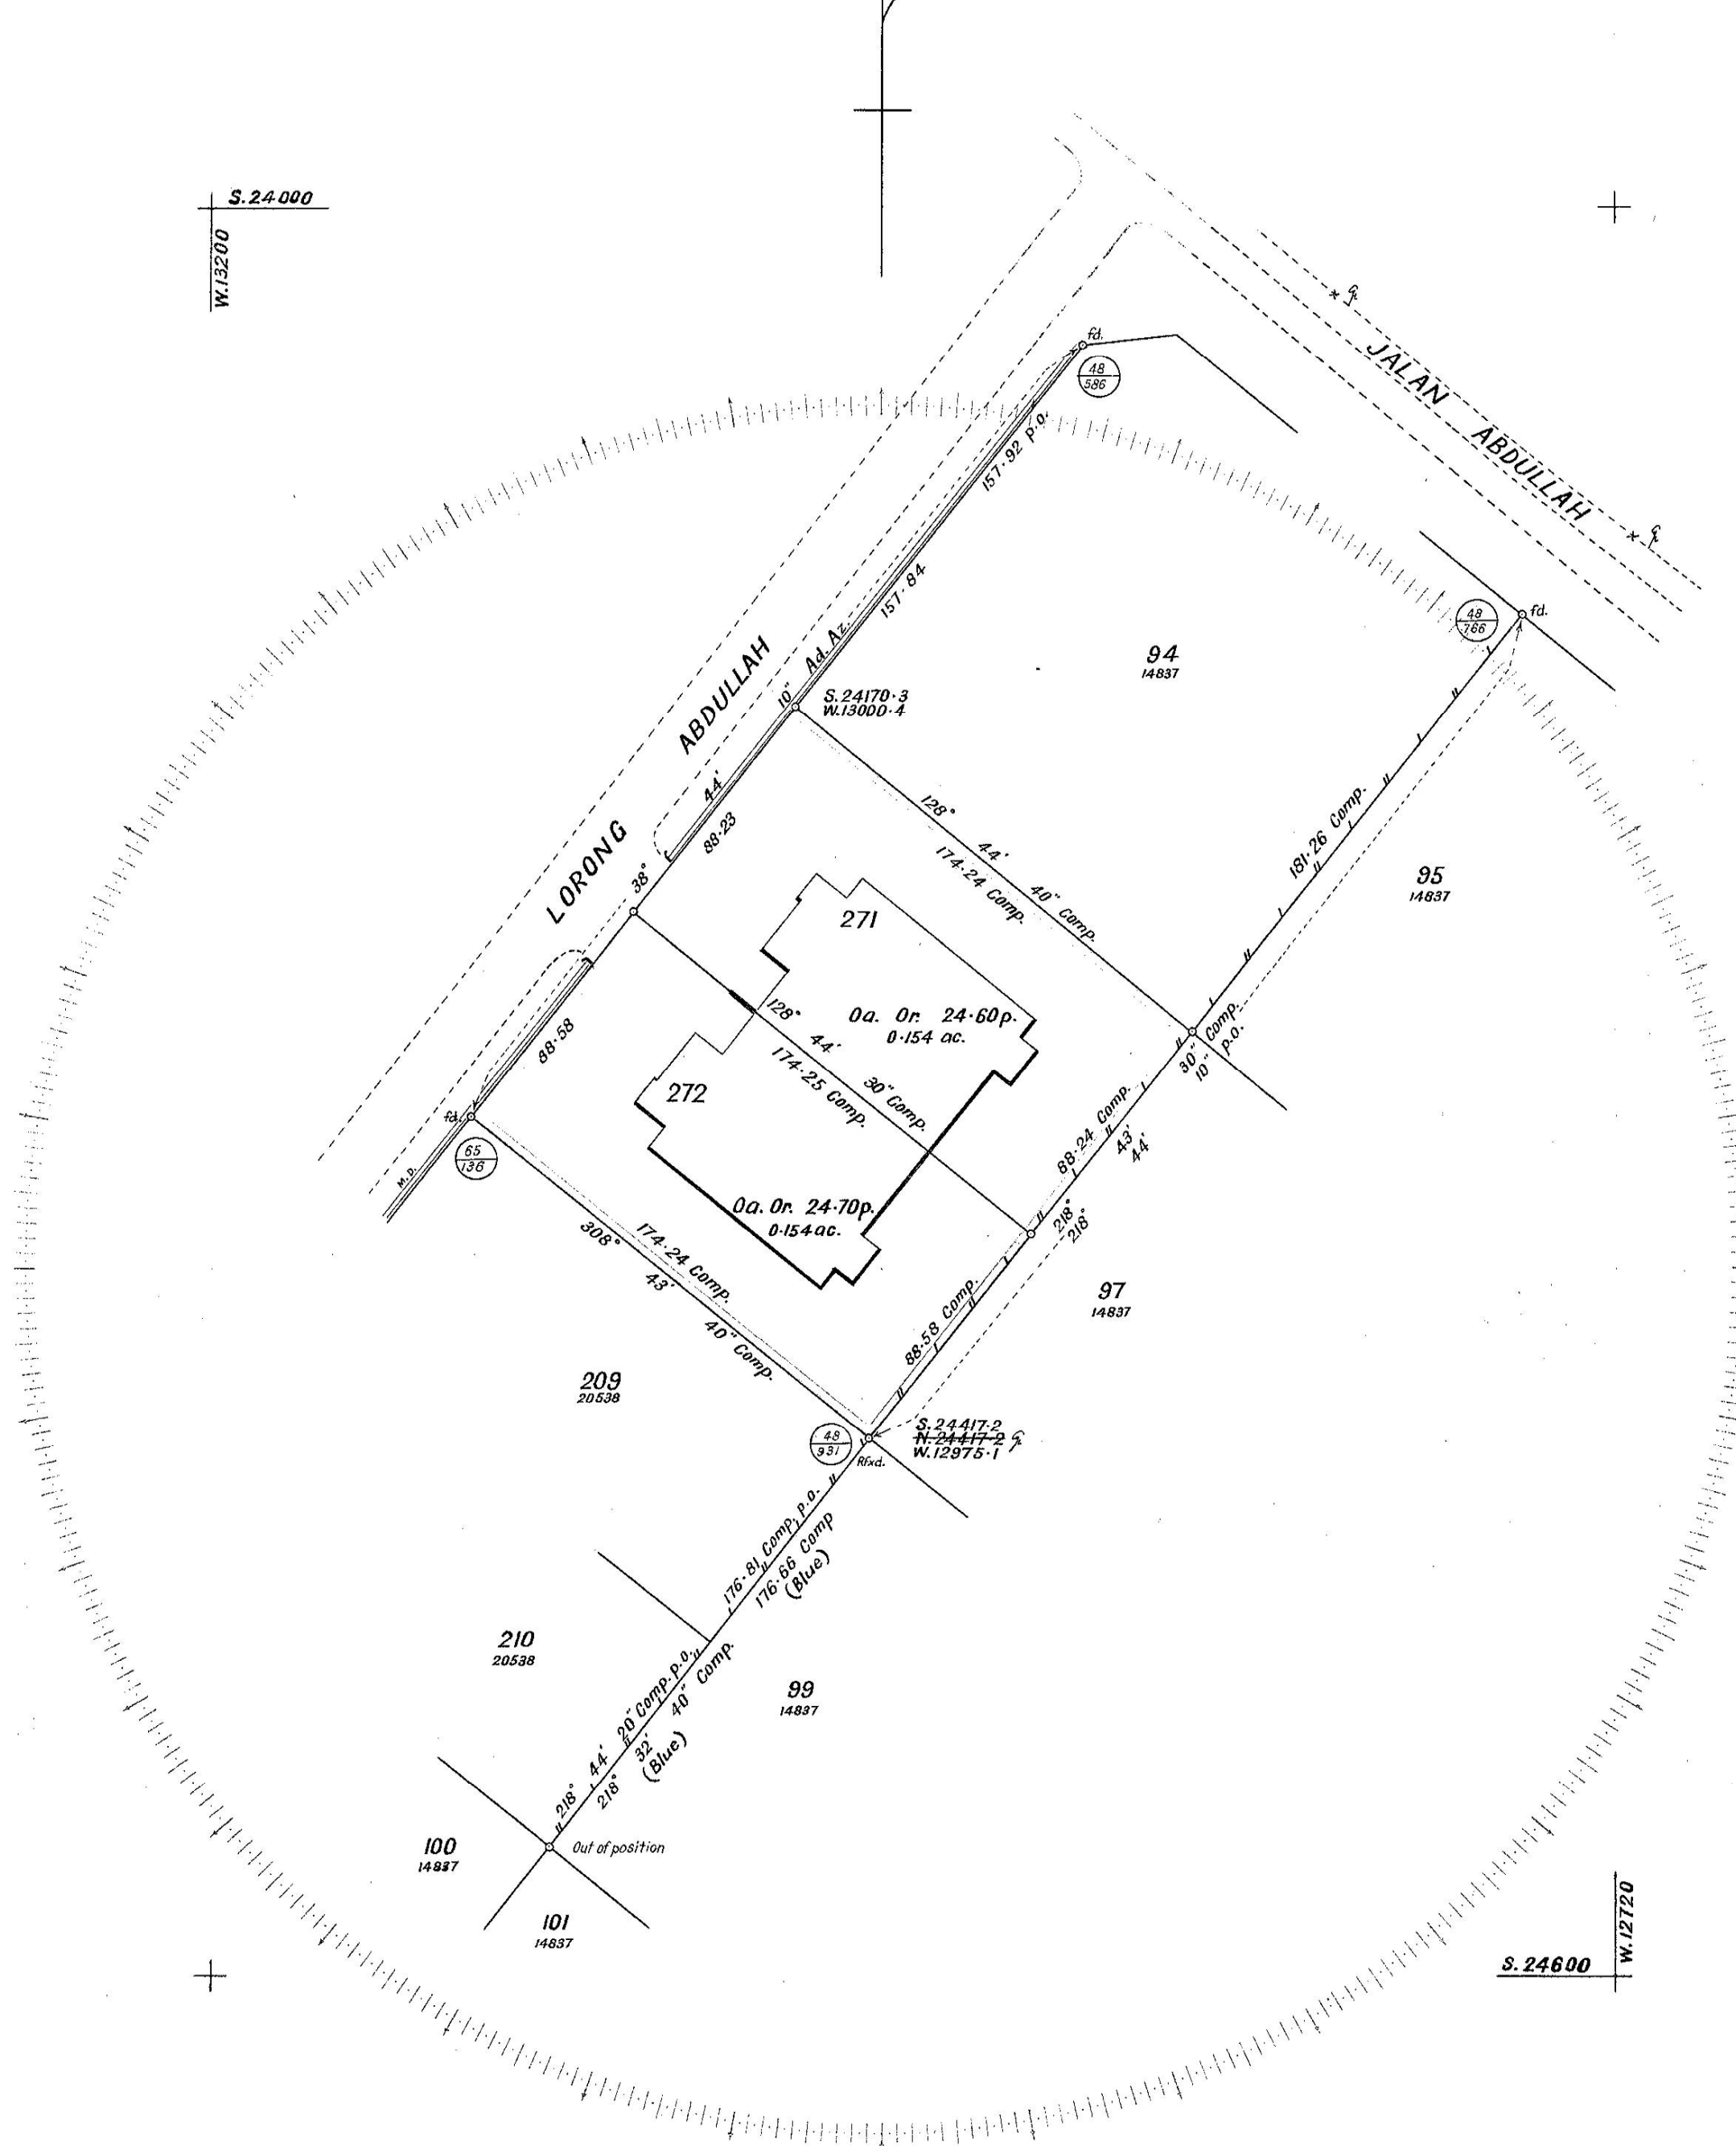

S. 24600
W. 12720

LOTS 271 & 272 SECTION 96
BEING SUBDIVISION OF LOT 96 (PLAN 14837)
TOWN OF KUALA LUMPUR
DISTRICT OF KUALA LUMPUR

Svy. Ref. R.S.S. 601-59
L. O. Ref. C.L.R.K.L. 6-151-59
Cal. Vol. 331 p. 197
Surveyed by Ahmad bin H.A. Majid
Completed on 6-4-60
Field Book 13099 pp. 15-22

First Class Survey
Drawn & Charted by M. Nasir Phad
Examined by M. Nasir Phad
Approved by M. Nasir Phad

Scale Fifty Links to an Inch

Std. Sheet 85-D-11-5

Plan No. 22974