

SEK500 KUASA JAMANSARA

No. Fail


Rajah di muka

Stesen	BEARING / SUDUT			Dari Stn.	GARISAN		Ke Stn.	Sudut Pukak (±)	Jarak	Suhu	Jarak Antara	Jarak Muktamat
	Penyilang Kiri	Penyilang Kanan	Purata		Bearing Muktamat							
	Datim Daripada			50	3005830	51	H	67.891			67.891	
				plt	A3 Ak.	plt						
					Agg m/s							
51	3005830	1205830	33 2642	50	33 2642	52	H	81.286			81.286	
(50)												
52	33 2642	213 2642										
	plt											
50-53	374757			50	374757	53	H	101.066			BKL	101.066
50-57	3005322			50	3005322	57	H	88.990			BKL	88.990
51-57	3004029	(checking)		51	3004029	57	H	23.598			BKL	23.598
50	1205830	3005830	31/5949	51	31/5949	55	H	52.931				52.931
(51)												
55	31/5949	21/5949										
	plt											
51	21/5949	31/5949	981229	55	981229	52	H	23.095				23.095
(55)												
52	981229	2181229										
55-56	574641			55	574641	56	H	26.206			BKL	26.206
52-57	03650			52	03650	57	H	20.901			BKL	20.901
52-53	400928	(checking)		52	400928	53	H	19.888			BKL	19.888
55	2181229	981229	2132642	52	2132642	50	Silva Lihat m/s > R 2					
(52)					Bering							
50	2132642	33 2642			Tertutup							

No. Fail

Rajah di muka

[illegible]

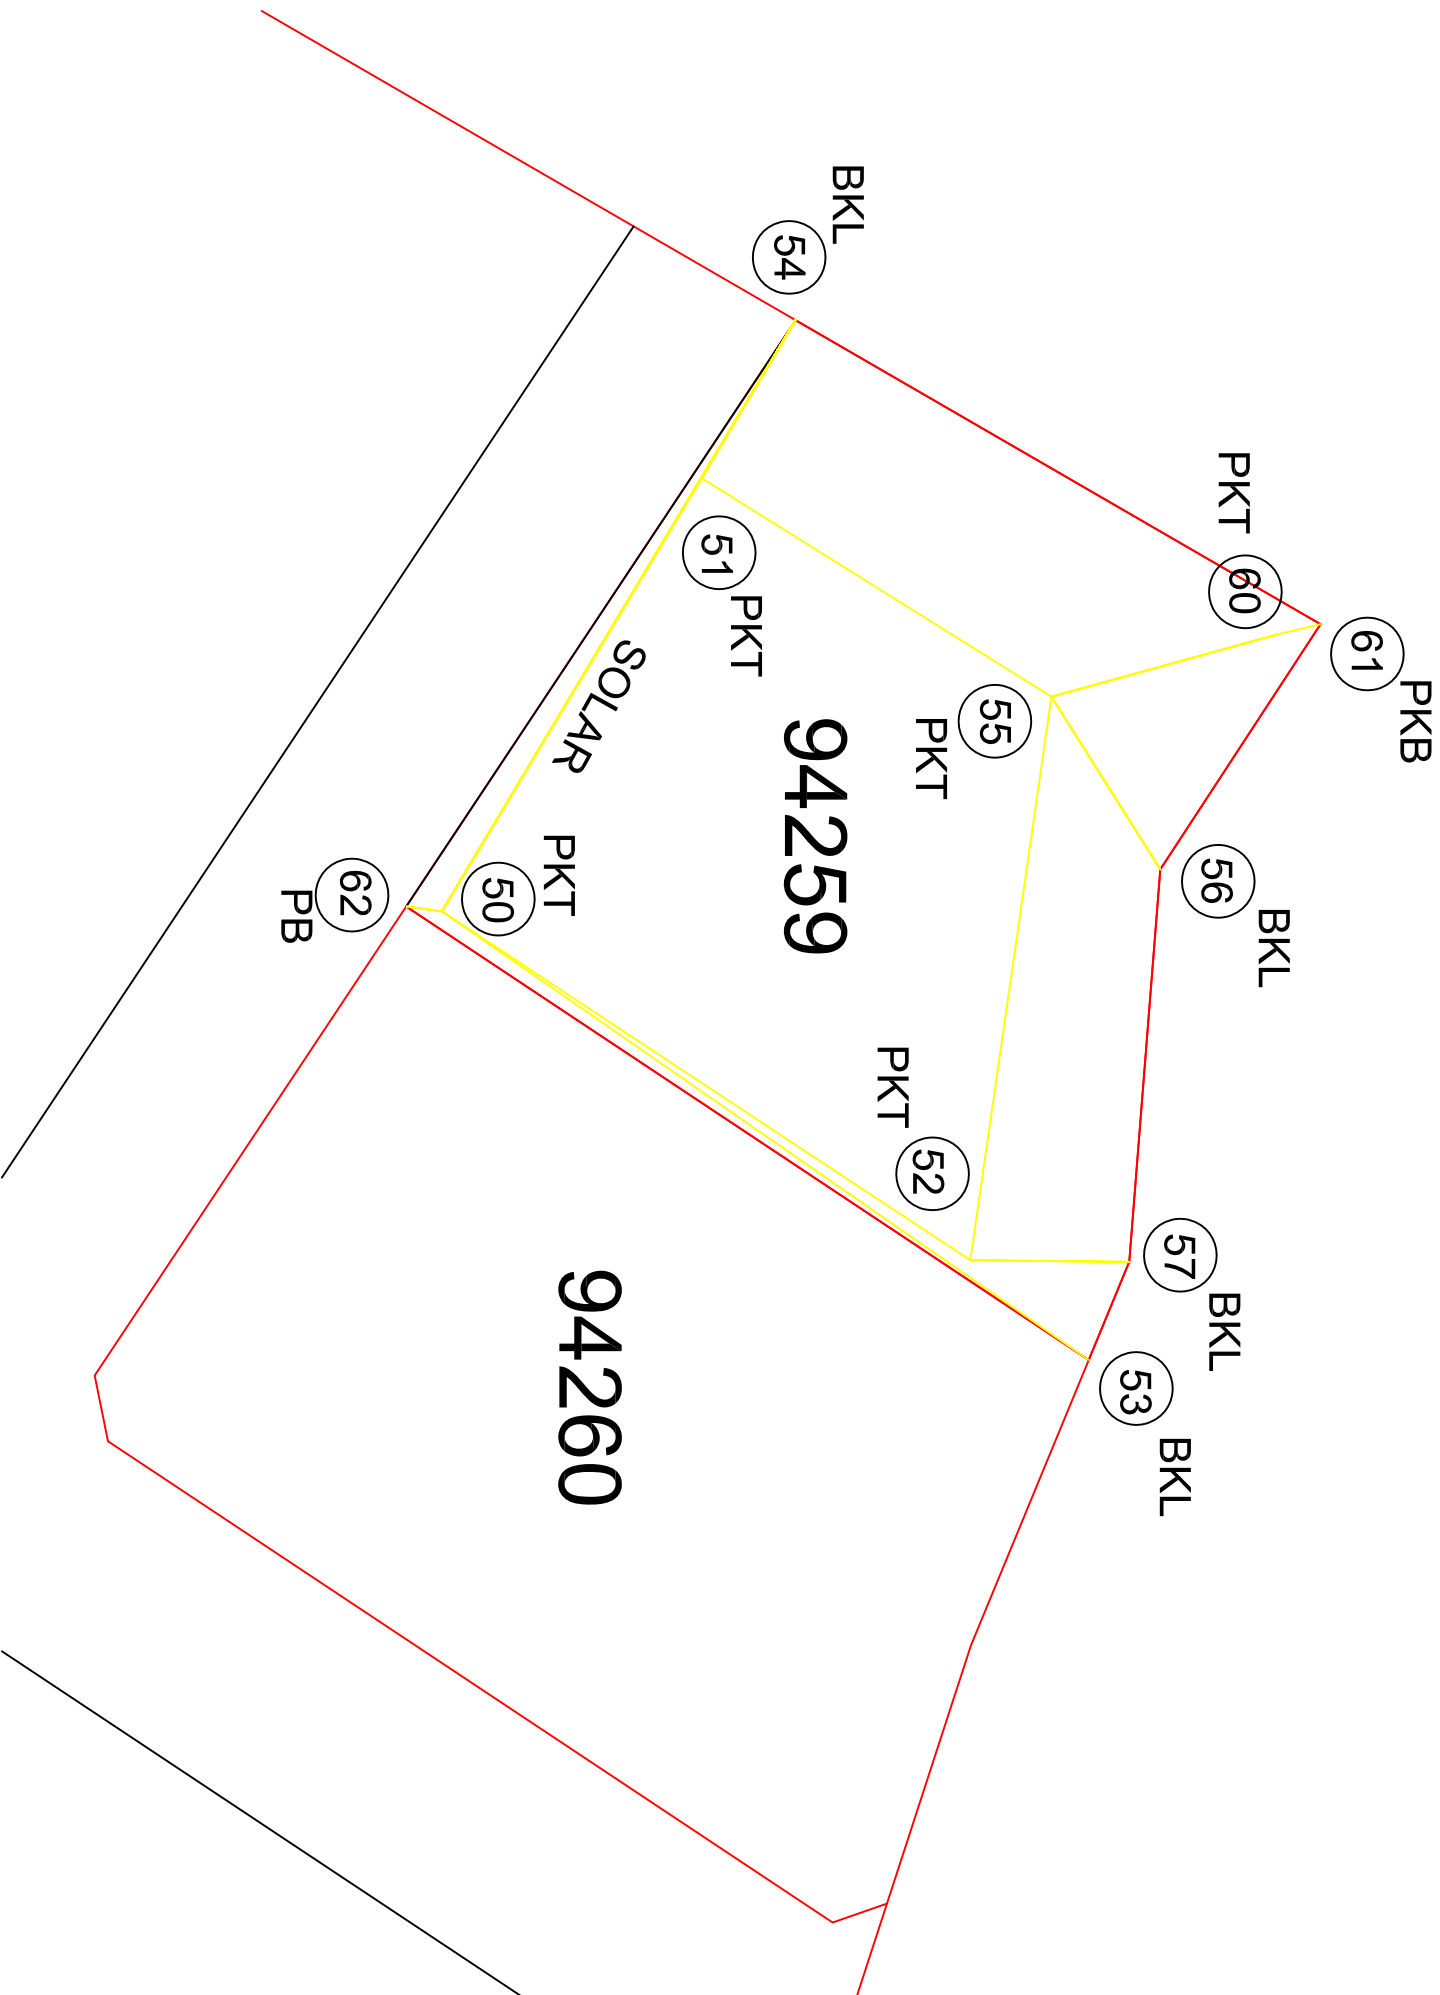

Penilik: SEL500 KWASA DAMANSARA F Tarikh: 05/08/2023

Stn. 50 Koordinat: S181 B15013 Selangor

T.R. 51 B.K. Ms.

Tiodolit Satu bah. aras ufuk:

Waktu Sasaran Ufuk Gelembong Puguk

	T.R.	300 00 00				
8 07	M.H.	72 28 55		77 45 59	Waktu purata	8 07 30
8 07	M.H.	71 56 33		77 38 11	Beza dari U.T. -	8 00 00
8 08	M.H.	251 56 25		282 27 22	U.T.	0 07 30
8 08	M.H.	252 28 47		282 31 55	Deklinasi	17 05 38
	T.R.	120 00 00				

	T.R.	300 00 00				
8 13	M.H.	72 28 07		76 29 31	Waktu purata	8 13 30
8 13	M.H.	71 55 33		76 24 39	Beza dari U.T. -	8 00 00
8 14	M.H.	251 55 24		283 42 59	U.T.	0 13 30
8 14	M.H.	252 27 52		283 48 10	Deklinasi	17 05 34
	T.R.	120 00 00				

Set 1

Set 2

Sudut pugak	12 23 47	13 39 15
Pembetulan	- 0 03 47	- 0 03 26
Altitud	12 20 00	13 35 49
Jarak kutub	72 54 22	72 54 26
Latitud	3 10 21	3 10 21
Azimut M.H. yang dikira	73 11 18	73 10 29
Purata ke M.H.	72 12 40	72 11 44
Selisih:	0 58 38	0 58 45
Purata ke T.R.	300 00 00	300 00 00
Azimuth T.R. sebenar	300 58 38	300 58 45
Pembetulan aras	+ 0 00 00	+ 0 00 00
Tirusan	- 0 00 12	- 0 00 12
Bering grid T.R.	300 58 26	300 58 33

Purata bering grid T.R. 300 58 30