

No. 1, 200

Exhibit 10-10

DAERAH KLANG.
MUKIM KLANG.
100A
TANDA, SKALA

7099
DA 12989

3799

⑧ *ptB*

255/8
208 5824

⑦

$$\begin{array}{r} 25.579 \\ \times 225302 \\ \hline \end{array}$$

⑥ pt. B

$$\begin{array}{r} 156.525 \\ \hline 269 \quad 0210 \end{array}$$

10 skB

3800
PA 11908

① p.k.B

182 2620
98.89%

Handwritten notes:

30.8.1972
30.8.1972
30.8.1972

(6)

168

H3 At. by NH

→ ———— →
————— 987 44
101.02

~~7-5 199 9752 181.997 ✓~~
199

7-5 199 5129 181.200 N
199 5295 181.282 M
-1 18' -0.082

Kajah di muka

Nama:
 No.
 Dit. Pengak.
 Lurah
 Sub
 Jarak
 Antara
 Tembang
 Jarak Muktamad

109018

4099

109017

① pkt

290 35 39

3799
PA 11908

198.390

② pkt

37900

3800

22/

④
BKL

109015
PA 85783

88123
PA 85783

⑤
BKL

172598

③ pkt

78/

22/05

175

07

37

316126

SEL 701 Kemuning.

	Datum	Daripada	2903709	2	2903539	1	4	188.390		188.390
	PA		M-130' ptt			ptt				
1	2903709	1103709	475919	2	475749	3	4	172.598		172.598
2			M-130'							
3	475919	2275919								
		ptt.								
3-4	2020136		} M-130'	3	2020006	4	4	202.051	BFL	202.051
3-5	1750907			3	1750737	5	4	336.726	BFL	336.726
2	1103539	2903539	2870210	1	2870210	6	4	158.525		158.525
1										
6	2870210	890210								
		ptt.								
1	890210	2870210	2725302	6	2725302	7	4	85.579		85.579
6										
7	2725302	925302								
		ptt.								
6	925302	2725302	2875826	7	2875826	8	4	25.519		25.519
7										
8	2875826	1075826								
		ptt.								
7	1075826	2875826	3211021	8	3211021	9	4	38.616		38.616
8										
9	3211021	1711021								
		ptt.								

8	1911021	3211021	1680277	9	1680277	10	4	101.987	101.987
9					A3 Ak.				
10	1680277	3780277			Dgn MY				
	pt B								
9	3780277	1680277	1822620	10	1822620	11	4	88.896	88.896
10									
11	1822620	22620							
	pt B	(TBM F1727)							

SEL 901 Bkt Naga.

Handwritten notes

10	1680299 398 0299 267 2691 9 267 2691 30	4	170.900	23/1/201	170.900
9	30 267 2691 87 2691				
	pt.B				
10	Sept 01 At 0 3510 9 0 3510 31	4	158.739		158.739
9	31 0 3510 180 3510				
	pt.B				
9	180 3510 0 3510 0 01 93 31 0 01 93 32	4	177.823		177.823
31	32 0 01 93 180 01 93				
	pt.B				
31	180 01 93 0 01 93 357 5939 32 357 5939 33	4	135.038		135.038
32	33 357 5939 177 5939				
	pt.B				
32	267 3907 87 3907 267 3907 33 267 3907 39	4	188.692		188.692
33	177 5939 357 5939				
39	267 3907 87 3907				
	pt.B				
33 39	87 3907 267 3907 11 4945 39 11 4945 35	4	199.727		199.727
39	35 11 4945 191 4945				
	pt.B				
35 36	301 1559	35 301 1559 36	4	87.283	AC 87.283
35 37	39 2993	35 39 2993 37	4	56.379	AC 56.379

9 87 2691 267 2691 270 7353 30 270 7353 38 4 266.90/ 266.90/

30

38 270 7353 90 7353

pkB

38-39 180 7527

38-40 202 3197

38-41 252 5850

38 180 7527 ³⁹40

38 202 3197 90

38 252 5850 41

4

4

4

239.052

10286

32968

pkC

~~pkB~~

pkC

HWP


239.052

10286


32968

No. 1411

DAERAH KLANG.
MUKIM KLANG.
100 A
TANPA SKALA

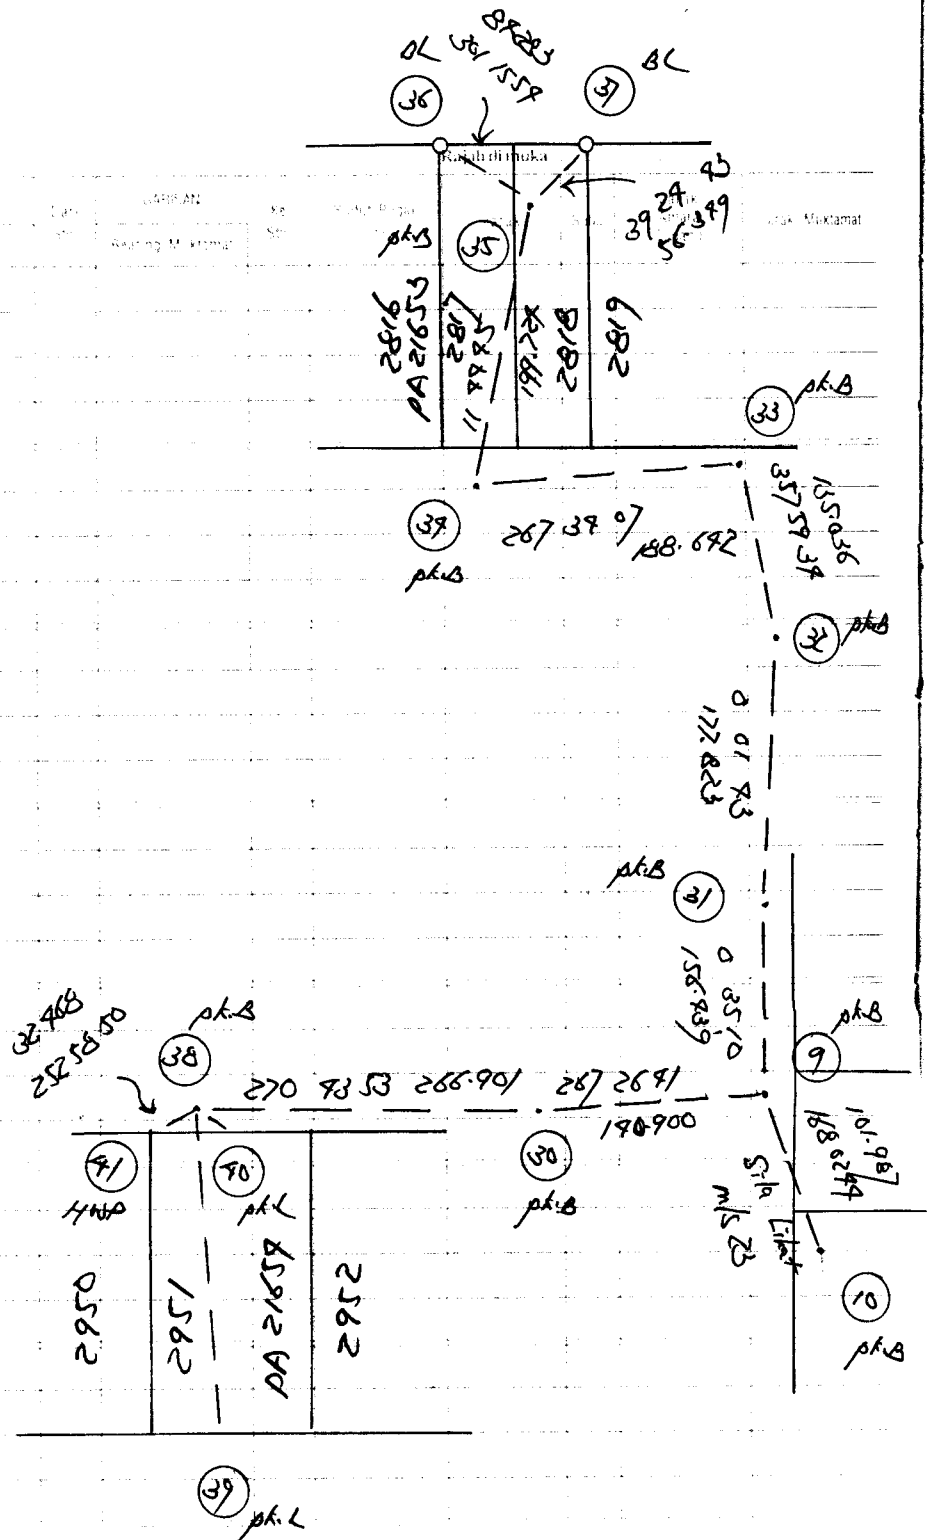

Rajah di muka

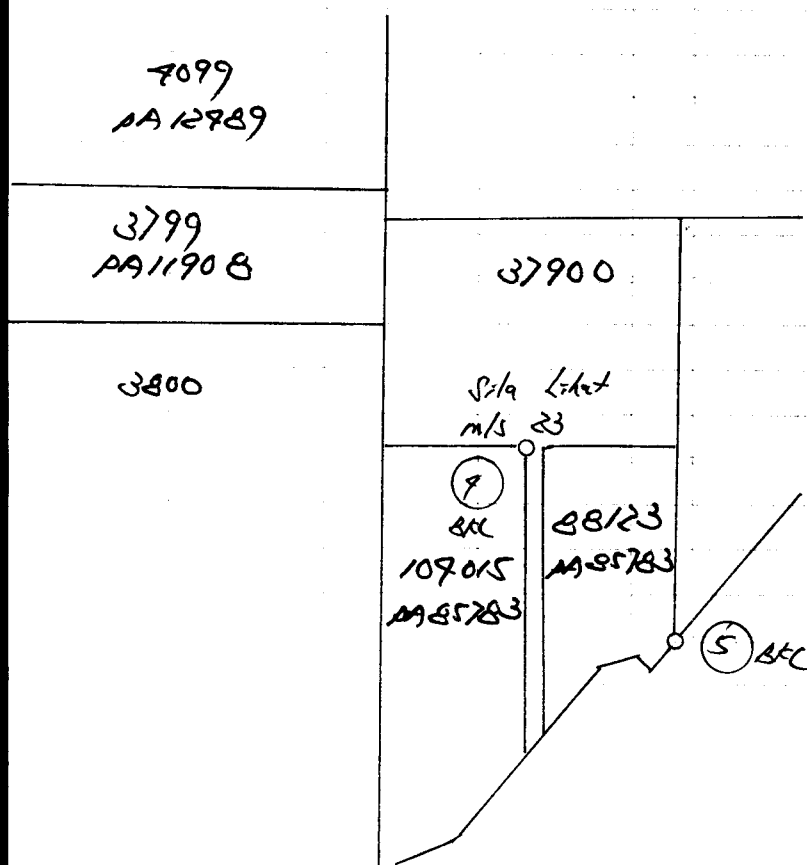

$$\begin{array}{r}
 5-36 \quad 320 \quad 05 \quad 19 \quad 1318.619 \checkmark \\
 320 \quad 06 \quad 19 \quad 1318.576 \text{ PO} \\
 \hline
 -1' 5'' \quad 70.038
 \end{array}$$

$$\begin{array}{r}
 4-5 \quad 199 \quad 51 \quad 29 \quad 181.200 \checkmark \\
 199 \quad 52 \quad 95 \quad 181.282 \text{ PO} \\
 \hline
 -1' 16'' \quad -0.080
 \end{array}$$

$$\begin{array}{r}
 4-36 \quad 319 \quad 19 \quad 73 \quad 1138.191 \checkmark \\
 319 \quad 20 \quad 77 \quad 1136.023 \text{ PO} \\
 \hline
 -1' 01'' \quad 70.118
 \end{array}$$