

WA/03 T/A Duta 2

26/12/08

Lat/Long Daripada
AC Benang

1600000 2 1595801 1 4
M- 5° 1' 59" pt.B A3 Ak. pt.B
Dgn 44


49.037

49.037

2-3	137 4017	} M- 5° 1' 59"	2	1323818	3	Sp.L	16.076	16.076
2-4	173 3353		2	1382159	4	pt.L	31.966	31.966
2-5	71 3741		2	66 3542	5	Sp.L	28.969	28.969
2-6	97 0721		2	92 0522	6	pt.L	23.720	23.720
2-7	153 0959		2	198 0755	7	pt.L	41.888	41.888
2-8	159 4959		2	159 4255	8	pt.L	50.632	50.632
2-9	110 5859		2	105 5700	9	pt.L	19.679	19.679

1 1600000 3900000 2559158 2 2503959 10 4 76.083 76.083
2 M- 5 1 59
10 2559158 759158
pt.B

2 3900000 1600000 2187539 1 2138325 11 4 37.799 37.799
1 M- 5 1 59
11 2187539 387539
pt.B

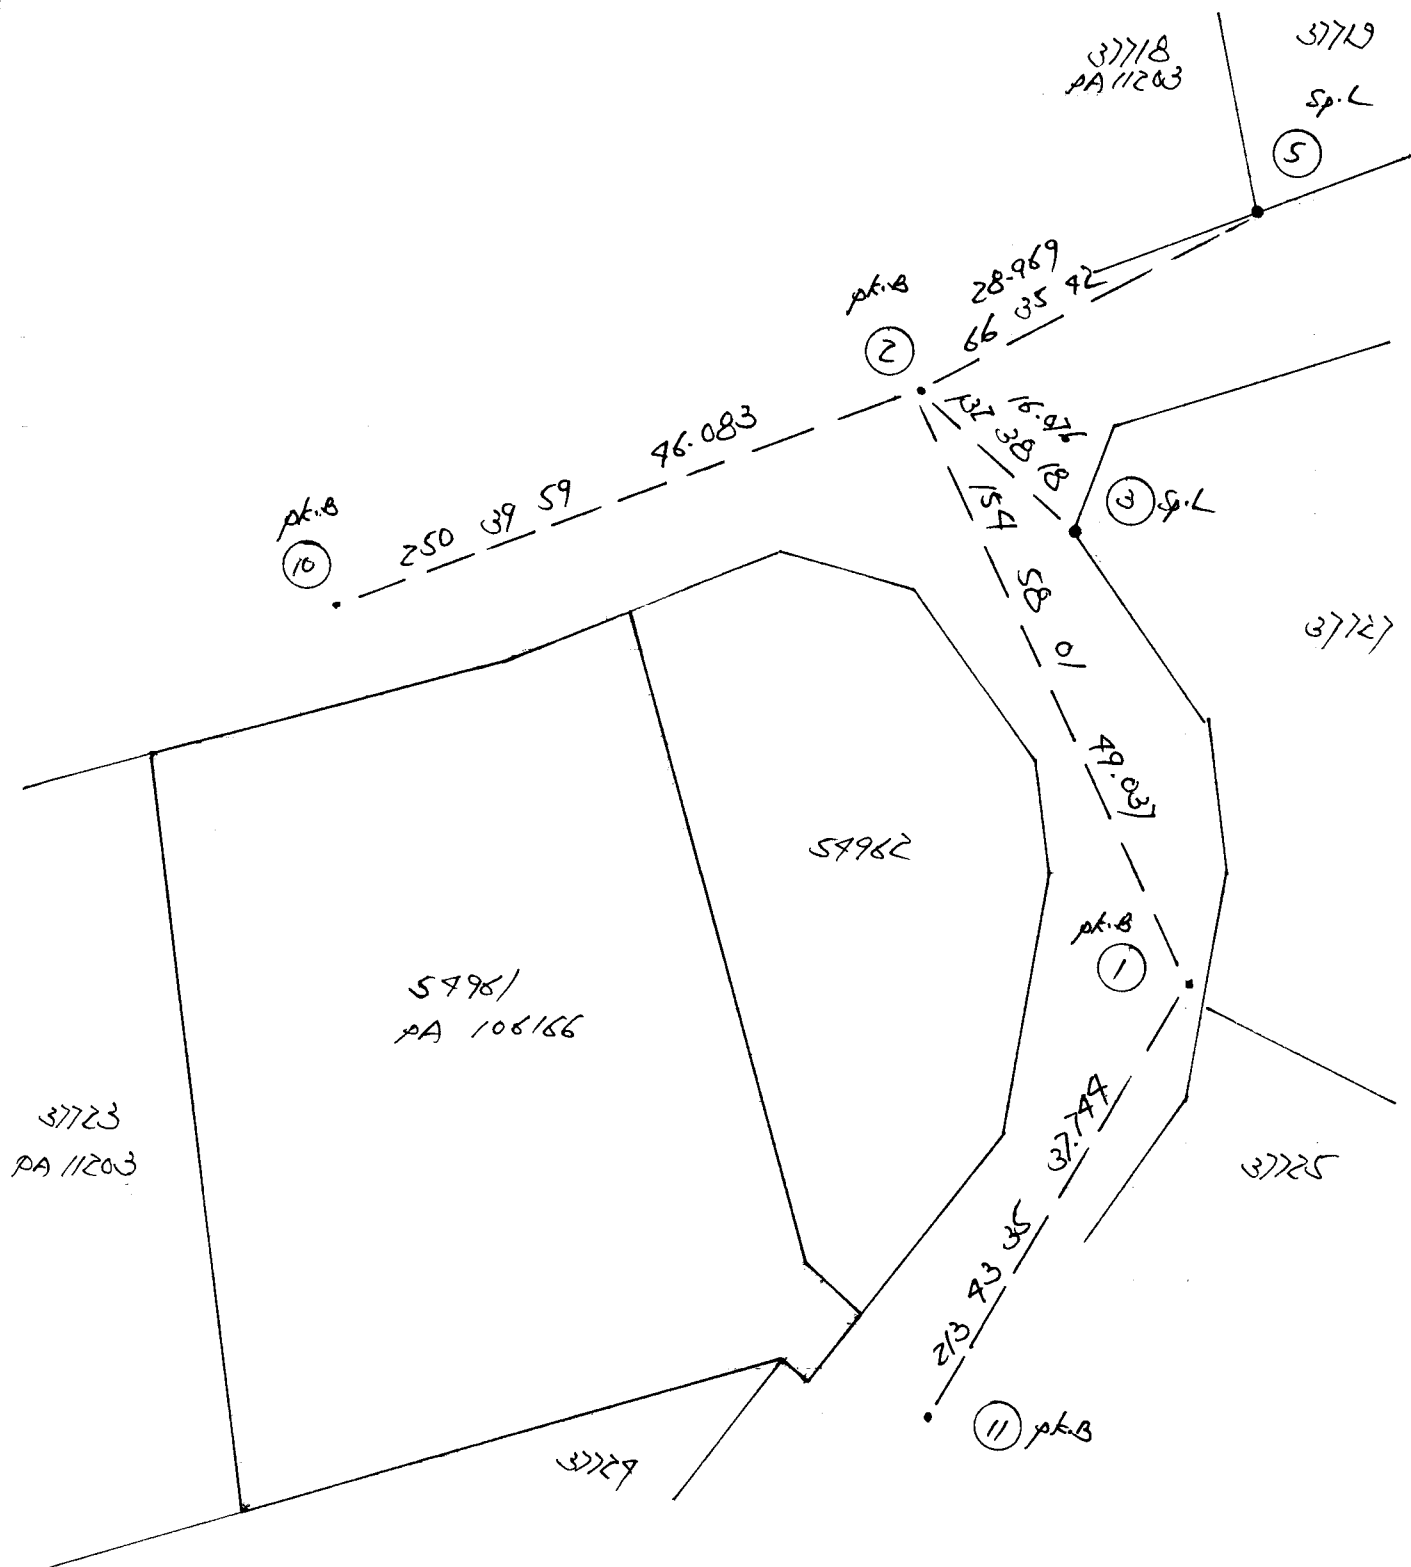

Penilik: WP103 Jln Duta 2 Tarikh: 26/12/2008
 Stn. 1 Koordinat: S1171 B3038 W.P. Kuala Lumpur
 T.R. 2 B.K. Ms.
 Tiodolit Satu bah. aras ufuk:

Waktu	Sasaran	Ufuk	Gelembong	Puguk
	T.R.	340 00 00		
9 09	M.H.	122 47 36	65 31 37	Waktu purata 9 09 30
9 09	M.H.	122 13 38	65 26 20	Beza dari U.T. - 8 00 00
9 10	M.H.	302 15 08	294 40 13	U.T. 1 09 30
9 10	M.H.	302 52 48	294 46 40	Deklinasi - 23 21 31
	T.R.	159 59 50		

	T.R.	340 00 00		
9 11	M.H.	122 56 15	65 03 08	Waktu purata 9 11 30
9 11	M.H.	122 21 44	64 59 45	Beza dari U.T. - 8 00 00
9 12	M.H.	302 23 05	295 07 25	U.T. 1 11 30
9 12	M.H.	303 01 14	295 13 55	Deklinasi - 23 21 31
	T.R.	159 59 50		

	Set 1	Set 2
Sudut pugak	24 37 14	25 04 37
Pembetulan	- 0 01 48	- 0 01 45
Altitud	24 35 26	25 02 52
Jarak kutub	113 21 31	113 21 31
Latitud	3 09 49	3 09 49
Azimut M.H. yang dikira	117 30 56	117 39 17
Purata ke M.H.	122 32 18	122 40 35
Selisih:	- 5 01 22	- 5 01 18
Purata ke T.R.	339 59 55	339 59 55
Azimuth T.R. sebenar	334 58 33	334 58 37
Pembetulan aras	+ 0 00 00	+ 0 00 00
Tirusan	- 0 00 34	- 0 00 34
Bering grid T.R.	334 57 59	334 58 03
Purata bering grid T.R.	334 58 01	

Tarikh Ara

Dibuat untuk 50

Daipada Ke

Pandangan Belakang	Pandangan Antara	Pandangan Hadapan	Naik	Turun	Ara Yang Dilaras	Jarak	Catitan
0.130	(10.73)				96.983	78M H/1	noil on top of ramp RL: 96.983m
0.096	(10.15)	3767	(112.39)				
0.771 0.665	(12.59)	2821 0.651	(925)				BM: 11.13 RL: 32.085
0.117	(10.28)	0.853	(2.13)				
0.125	(10.41)	3.109	(11.18)				
0.085	(10.28)	3.997	(11.97)				
0.126	(10.41)	3.299 2.831	(11.82)				
1.145	(13.76)	2.833	(9.29)				
3.282	(10.77)	0.762	(2.59)			F10	
5.897		0.983	(1.53)				
		3.215					
3.212	(10.59)					F10	
	1.513	(4.92)				F2	
1.360	(4.48)	2.298	(2.54)			F1	
	1.787	(5.86)				F11	
		1.805	(5.92)			78M F/1898	
9.522		7.105					