

SEL 357 Kota Samosara Ato Club.

27/12/08

1 Dokum Daripada 279 269/ 2 279 2896 1 1/ 125.109 125.109
2 PA MT 2 5'

$\left. \begin{array}{l} 2-3 \quad 358 \ 5739 \\ 2-9 \quad 7 \ 0299 \\ 2-5 \quad 209 \ 1117 \end{array} \right\} \text{NY } 2' \text{ as'}$

2 392841 2792641 2983825 / 2987030 6 4 78.960 78.960
/ M+ 2'05'
6 2983825 1183825
pt.B

1-7	70 0635	} MT 2' 5"	1	70 0890	7	4	10.638	PL	10.638
1-8	109 2759		1	109 2703	8	4	76.866	PK-L	76.866

1 1183825 2983825 213359) 6 2133752 12 4 70.319 pt.B 70.319
6 44 2' 5"
12 213359) 33359)
pt.B


8-9	13 07 20	} 172'05"	8	13 09 25	9	4	71.979	pk-L	71.979
8-10	11 11 20		8	11 13 25	10	4	77.390	pk-L	77.390
8-11	210 37 27		8	210 39 32	11		56.921	pk-B 5/1994	56.921

DATE	TIME	LOCATION	WIND	WAVE	SEA	WAVE	SEA		
12-13	1103600	1142'5"	12	1103805	13	4	29.205	pk.L	29.205
12-19	1263817		12	1264022	17	4	80.677	pk.B	80.677
12-15	2980157		12	2980902	15	4	72.132	pk.L ←	72.132
12-16	3273701		12	3273606	16	4	39.317	pk.L ←	39.317
12-17	1921627		12	1921829	17	4	3.085	pk.L	3.085

17-15	301 5811	73.059	N
	301 5811	73.060	PO
	N.1	-0.001	

17-16	330 3328	71.536	N.
	150 3326	71.527	PO
	72"	+0.009	

DAERAH AETALING.
 PEKAN BARU SINGA/BUKUH
 TANPA SEACA
 87 B

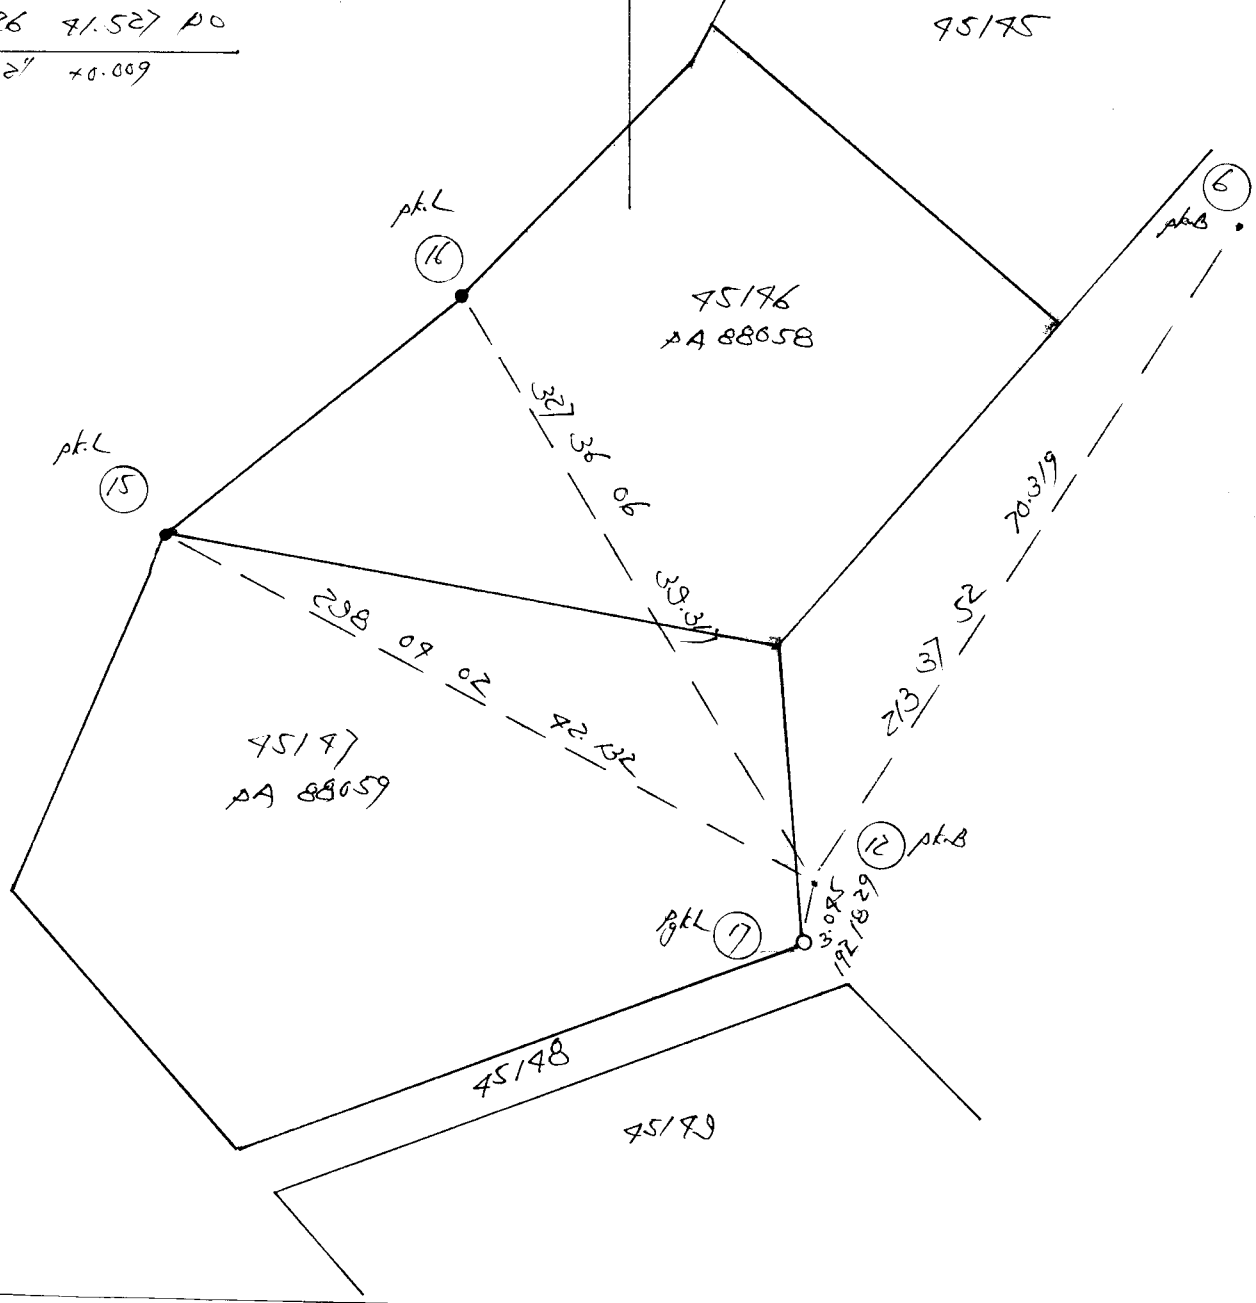

SET 357 Kda Damar
 Tarikh
 Daripada
 Aras
 No. Chk. (67-39).

Dibuat untuk
 Ke
 47

Pandangan Belakang	Pandangan Antara	Pandangan Hadapan	Naik	Turun	Aras Yang Dilaras	Jarak	Catitan
1.919 (1868)	1.395	(17.58)			37.382	M4A	
	1.939	(17.12)			37.361	M4B	
	1.991	(17.89)			37.285	M4C	
	1.278	(17.19)			37.478	M4D	
	1.518	(17.98)			37.238	M4E	
	1.555	(15.10)			37.201	M4F	
		1.370	(17.50)		37.386	M4G	
0.903 (1296)	1.131 (13.71)				71.68	78M F1499 (F11)	
	2.015 (16.01)				70.940	F12	
1.283 (14.21)	2.9.2.199 (1.2.21)				59.888	F19	
1.051 (13.95)	1.983 (16.51)				39.112	9A	
0.821 (12.09)	2.121 (16.96)				38.102		
	1.537 (15.08)				37.386		
7.058	7.890					78M F1499	

78M nail on top of ramp (Guard House Key)