

WA107 Bkt Juli/ Golf.

17/01/09

Datum Daripada
PA

179 2855

pk.B

2 179 2855

pk.B
AgkL

1 4

28.591

28.591

2-3 321 0136

2 321 0136 3

4

20.150

AgkL

20.150

2-4 305 3525

2 305 3525 4

4

37.976

PL

37.976

2-5 305 5330

2 305 5330 5

4

73.507

PL

73.507

2-6 179 0506

2 179 0506 6

4

6.261

AgkL

6.261

1 179 2855 359 2855 301 5089

2 301 5089 7

4

72.569

72.569

2

7 301 5089 121 5089

pk.B

2 121 5089 301 5089 325 3390

7 325 3390 8

4

135.37

135.37

7

8 325 3390 145 3390

pk.B

7 145 3390 325 3390 298 9227

8 298 9227 9

4

73.132

73.132

8

9 298 9227 118 9227

pk.B

8-10 286 5811

8 286 5811 10

4

20.613

AgkL

20.613

8-11 321 5050

8 321 5050 11

4

20.255

AgkL

20.255

8-12 151 2959

8 151 2959 12

4

27.961

pk.L

27.961

9-13 359 5938


9 359 5938 13

4


18.879

pk.L

18.879

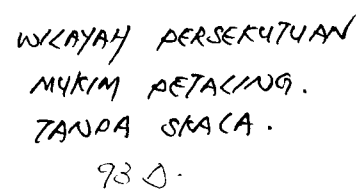

1-11	32/53/1	298.596	N
	32/53/1	298.512	PO
	N/1	70.039	
11-13	305 2959	65.992	N
	305 2933	65.752	PO
	728 ^y	-0.010	

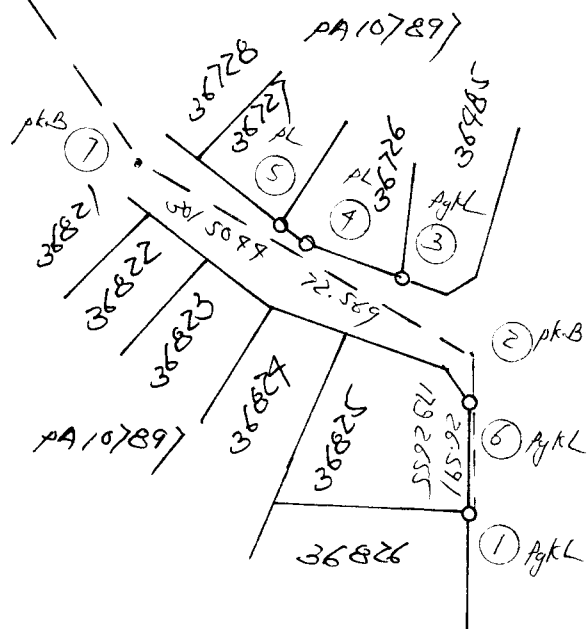

Tarikh WP 108 Aras

Daripada Bt Salil Grlf.

Dibuat untuk 56
Ke

Pandangan Belakang	Pandangan Antara	Pandangan Hadapan	Naik	Turun	Aras Yang Dilaras	Jarak	Catitan
1.503 (2.85)			1.202 (3.99)		48.945	128	
3.957 (112.98)					49.220	78M 15/500	
1.273 (7.18)			2.903 (7.86)				
0.130 (0.83)		3.688 (11.96)					
0.815 (2.67)		3.745 (12.25)					
0.170 (0.55)		3.729 (12.23)					
0.603 (1.98)		3.898 (12.17)					
2.821 (9.25)		1.057 (13.97)					
7.000 (13.12)		0.057 (10.19)					
2.303 (7.56)		0.957 (1.98)					
0.810 (2.66)		2.625 (8.07)					
3.078 (10.10)		1.683 (5.56)			42.808 X		
21.963		0.698 (2.13)			45.239		
		25.198					
1.573 (5.16)					42.804		
		1.307 (4.24)			43.070		

78M 1212 12: 43070 78M 54908/7 1047.
1047 fail 8/389.
78M 1047 12: 43.070M
78M 1045 5/3 5411 1501