

DEL 371 Tarik Bin

Dotom Banjarada
PA 107155

K29 0618

3

1280618

/

4

38.300

14/7/09

38.300

pk.B

AJ AK.

BCL

Don my

1 128 06/8 308 06/8

9/10/18

2

9/10/18

3

4

15.989

15.989

3 9 10 18 189 10 18

BFL

1. Seperti di Atas

720621

3

420621

1

4

70.883

୨୦. ପ୍ରଶ୍ନ

१ ४२०६८१ २२२०६८१

Sp. L

4-1 175 15 15 51.985 ~
 175 15 52 51.985 00

 -37" N1/


3-1 321 56 59 77.316 ~
 321 56 30 77.302 00

 719" 70.006

Raportik mika



JARAH GOMBAK.
 PERAN DENGKARAN KUNDAUNG.
 68C
 TANPA SKALA

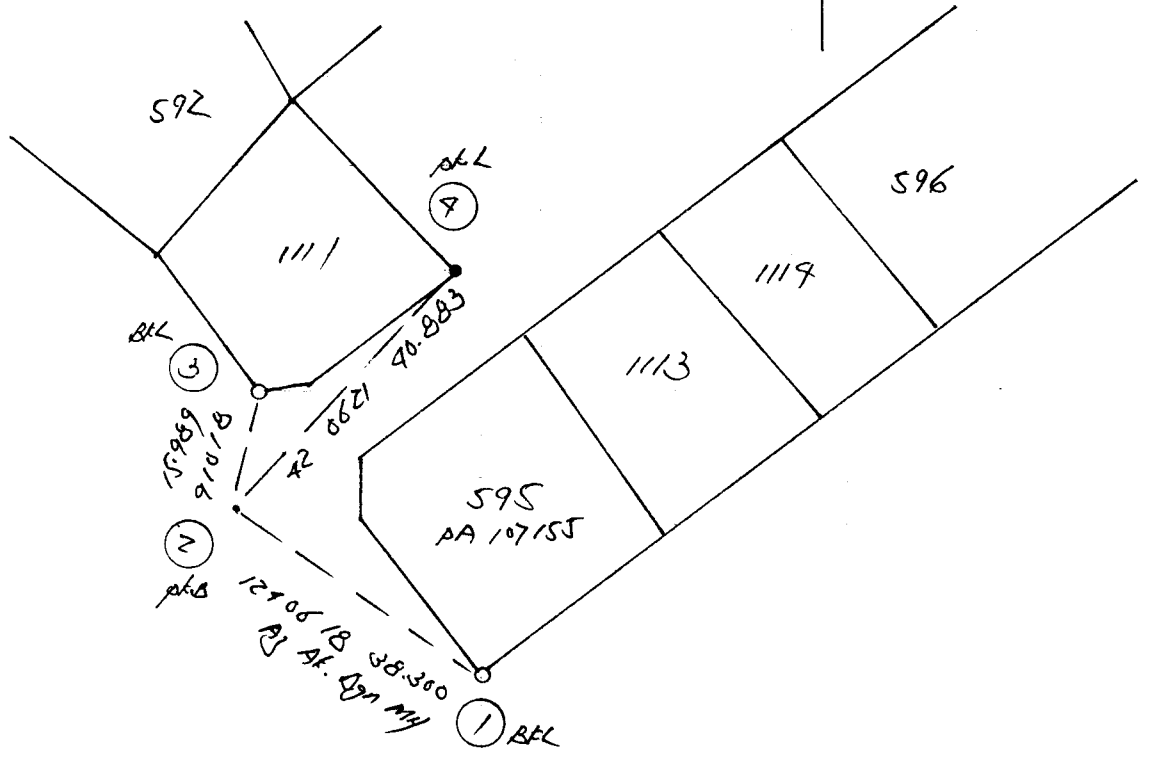

KARTAHARI BAGI AZIMUT

Tahun

Bulan

Hari

Penilik: SEL371 Tasik Biru Tarikh: 10/07/2009

Stn. 2 Koordinat: U8602 B19466 Selangor

T.R. 1 B.K. Ms.

Tiodolit Satu bah. aras ufuk:

Waktu	Sasaran	Ufuk	Gelembong	Puguk		
	T.R.	124 05 10				
8 01	M.H.	68 13 15		79 29 46	Waktu purata	8 01 30
8 01	M.H.	67 41 05		79 19 53	Beza dari U.T. -	8 00 00
8 02	M.H.	247 40 44		280 46 12	U.T.	0 01 30
8 02	M.H.	248 12 45		280 50 52	Deklinasi	22 14 36
	T.R.	304 05 10				
	T.R.	124 05 10				
8 03	M.H.	68 12 51		79 02 47	Waktu purata	8 03 30
8 03	M.H.	67 40 40		78 57 07	Beza dari U.T. -	8 00 00
8 04	M.H.	247 40 22		281 08 36	U.T.	0 03 30
8 04	M.H.	248 12 23		281 13 19	Deklinasi	22 14 36
	T.R.	304 05 10				

	Set 1	Set 2
Sudut pugak	10 41 51	11 05 30
Pembetulan	- 0 04 25	- 0 04 15
Altitud	10 37 26	11 01 15
Jarak kutub	67 45 24	67 45 24
Latitud	3 15 07	3 15 07
Azimut M.H. yang dikira	67 58 09	67 57 46
Purata ke M.H.	67 56 57	67 56 34
Selisih:	0 01 12	0 01 12
Purata ke T.R.	124 05 10	124 05 10
Azimuth T.R. sebenar	124 06 22	124 06 22
Pembetulan aras	+ 0 00 00	+ 0 00 00
Tirusan	- 0 00 04	- 0 00 04
Bering grid T.R.	124 06 18	124 06 18

Purata bering grid T.R. 124 06 18

Tasik Bina

Tarikh

Aras


Dibuat untuk

06/03/

Ke

Daripada

Pandangan Belakang	Pandangan Antara	Pandangan Hadapan	Naik	Turun	Aras Yang Dilaras	Jarak	Catitan
1.907	(622)				28.916	152	
1.305	(428)	1.070	(357)		29.753	CP 100/	
0.729	(239)	1.700	(558)		29.358	CP 108/	
1.533	(503)	2.668	(875)		27.919	CP	
	(363)	(431)			27.639	BM F1542 nail on top of sump. (Main Kuar)	
1.236	(406)	0.810	(266)		28.182	CP 1300	
		0.859	(282)		28.412	BM B5423	
6.710		7.107			28.519		
0.929	(305)				28.519	BM A5423	
1.583	(506)	1.118	(367)				
1.952	(641)	0.983	(319)				
1.540	(505)	1.328	(436)				
1.729	(567)	1.257	(412)				
1.409	(462)	1.437	(472)				
1.613	(529)	1.113	(365)				
		1.402	(460)		30.636		
10.716		8.598					

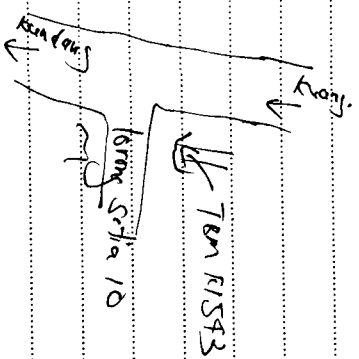

BM F1543 nail on top of sump

