

SEC 806 by Sybong

No. 101

TODAY'S DATE

22/7/2010

Darym Danipada
PA

2 1899538 1 4

28.373

28.373

1 1899538 3999538 2599927 2 2599927 3

4

133.713

133.713

2 2599927 799927

Ag Ak.

Dj 11/4

3 2599927 799927

pt.B

2 799927 2599927 1613526 3 1613526 7

4

57.976

57.976

7 1613526 3913526

pt.B

3 2 ~~Seperti Di Atas~~ 1205100 34 1205100 5

4

153.626

153.626

7 1613526 1613526

5 1205100 3005100

pt.B

3 3005100 1205100 1631157 5 1631157 6

4

67.252

67.252

6 1631157 3931157

pt.B (cp 1122)

3 3931157 1631157 2104619 6 2104619 7

4

11.690

11.690

7 2104619 304619

B/L

3 ~~Seperti Di Atas~~ 2590330 6 2590330 8

4


195.907

195.907

8 2590330 790330

pt.B (cp 1216)


6	790330	2590330	2790047	8	2790047	9	4	66.062	66.062
8	9	2790047	990047						
		pk (cp 1280)							
8	990047	2790047	2835549	9	2835549	10	4	78.836	78.836
9	10	2835549	1035549						
		pk (cp 1320)							
9	1035549	2835549	3514003	10	3514003	11	4	9.079	9.079
10	11	3514003	1114003						
		BK							
9	Sept 11 Atw	3232229	10	3232229	12	4	73.166	73.166	
10	12	3232229	1732229						
		pk							
9	Sept 11 Atw	1283338	10	1283338	13	4	87.832	87.832	
10	13	1283338	3083338						
		SuL							

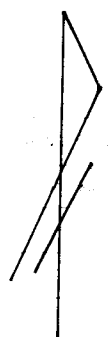

DARAH PETAKING.
 PERAN DARU SYBANG.
 87A & B
 TANPA SKALA

13-7	79 37 93	252.790	N
	79 39 00	252.792	PO
	-1 17'	-0.052	

11-7	90 79 78	300.397	N
	90 75 78	300.737	PO
	-1 10'	-0.092	

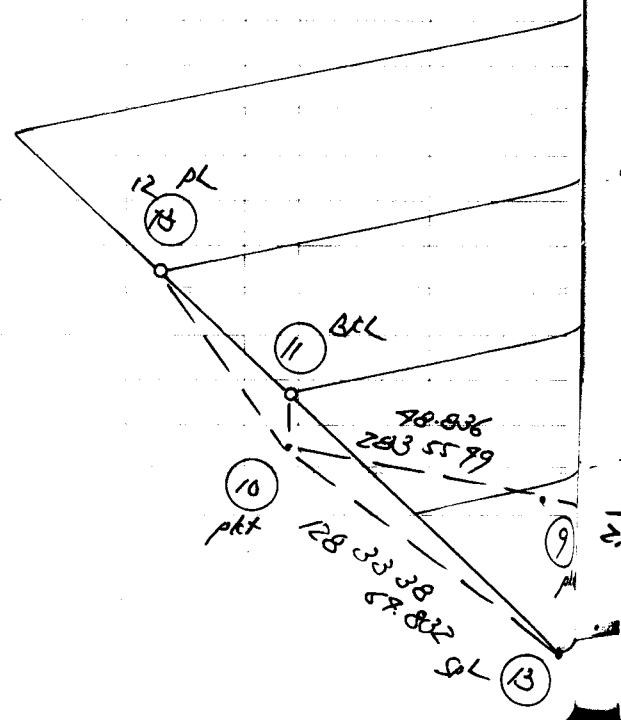

Raphidi muka

