

SEKUSO Subang industri

							11/8/08	
	Datum Danjanda	1875700	2	1875390	1	4	70.289	70.289
	PA	M- 207		BCL				
1	1875700	75700	1830508	2	1830998	3	4	16.837
2		M- 207						16.837
3	1830508	30508						
	Sp-L							
1	Separat Di Atas	2692717	2	2692657	7	4	58.843	58.843
2		M- 207						
7	2692717	892717						
	ptk (Atas Bank Longkong.)							
1	Separat Di Atas	2559596	2	2559526	5	4	66.686	66.686
2		M- 207						
5	2559596	759596						
	BCL							
1	Separat Di Atas	1182201	2	1182191	8	4	66.637	66.637
2		M- 207					68.637	68.637
6	1182201	2982201						
	ptk.							
2	2982201	1182201	1859829	6	1859809	7	4	19.352
6		M- 207						19.352
7	1859829	59829						
	PL							
2	Separat Di Atas	1923937	6	1923917	8	4	19.790	19.790
6		M- 207						
8	1923937	3223937						
	PL							

7	288 2201 / 118 2201	193 7555	6	193 7535	9	4	181.677		181.677
6		M- 20"							
9	193 7555	13 7555							
	Pkt								
6	13 7555 / 193 7555	85 0958	9	85 0938	10	4	37.238		37.238
9		M- 20"							
10	85 0958	285 0958							
	Pk								
6	Seperti Di Atas	82 1976	9	82 1926	11	4	20.601		20.601
9		M- 20"							
11	82 1976	282 1976							
	BKL								
6	Seperti Di Atas	273 0951	9	273 0931	12	4	38.801		38.801
9		M- 20"							
12	273 0951	23 0951							
	BKL								
6	Seperti Di Atas	285 0552	9	285 0532	13	4	89.857		89.857
9		M- 20"							
13	285 0552	85 0552							
	Pkt								
9	85 0552	285 0552	350 1628	13	350 1608	17	4	9.752	9.752
13		M- 20"							
17	350 1628	170 1628							
	BKL								
9	Seperti Di Atas	7 5918	13	7 5858	15	4	198.172		198.172
13		M- 20"							
15	7 5918	187 5918							
	Pkt								

13 189 5918 7 5918 70 3929 15 70 3909 2 4 58.713 58.713
15 M- 20"
2 70 3929 250 3929


15 250 3929 70 3929 118 220 2 118 21 91 6 Sipa Rijk m/s 15 R 5
2 M- 20"
6 118 220 298 220

Benj 2-6 Dibaca 118 220
Seperti itu Dibaca 118 220
Tikarai Nil
Pembetulan Nil

3-12	1861200	191.239 ✓
	1861200	191.299 PO
	Nf)	-0.95

3-17	2005750	207.136 ✓
	2005759	207.173 PO
	79'	-0.935

DAERAH DETAKUNG.
PEKAN PENYAGA
920
TANPA SKALA

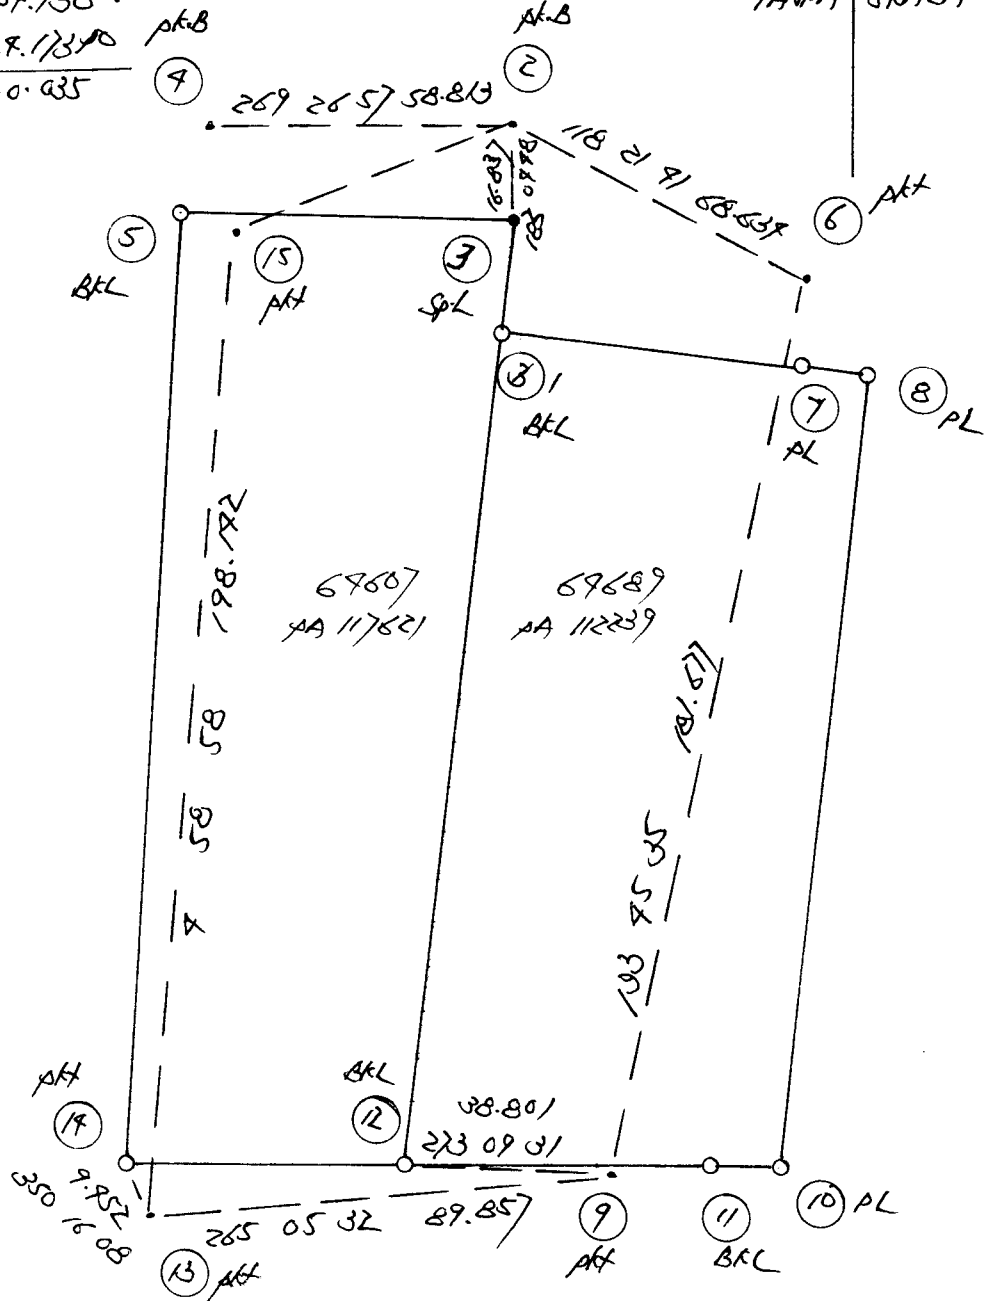

Tarih 19/03/2019

Aras

7

Daripada

Dibuat untuk

Ke

Pandangan Belakang	Pandangan Antara	Pandangan Hadapan	Naik	Turun	Aras Yang Dilaras	Jarak	Catitan
0.819 (22.59)					11.038		TBM F1/R32 on top of Hydrant Di hadapan
1.320 (28.33)	1.967	(6.85)					PL: 11.028 Ketinggian Hydropipes induction sch. 4d.
1.317 (28.32)	1.886	(2.81)					berdasarkan dgn 1st BSS. 17/10
1.620 (35.5)	1.205	(3.95)					Subang & / SEC 157 (1482
3.625 (11.89)	1.505	(4.98)					13.02 m/s 68. Subang
1.307 (28.29)	1.067	(3.50)					
	1.802 (5.25)						
10.068	1.555	(5.19)			12.391	90 kaki	TBM F1/R33 on top of RSL
	8.765						
1.555					12.391		TBM F1/R33
1.368 (28.29)	1.728	(5.73)			12.148		
1.621 (35.32)	1.062	(3.85)			12.148	47	
	1.808	(5.83)			12.267	42 / TBM F1/R34 nail on sch (entrance).	
2.594	2.618						