


No. Fail

Rajah di muka

Stesen	BEARING / SUDUT		Dari Stn.	GARISAN Bearing Mukamat	Ke Stn.	Sudut Pugak (±)	Jarak	Suhu	Jarak Antara Tupang	Jarak Mukamat
	Penyilang Kiri	Penyilang Kanan								

Demarcation.

11-50 255 9327 5.279 AB
 12-51 355 9802 1.180 pAB
 13-52 330 2922 6.389 AB

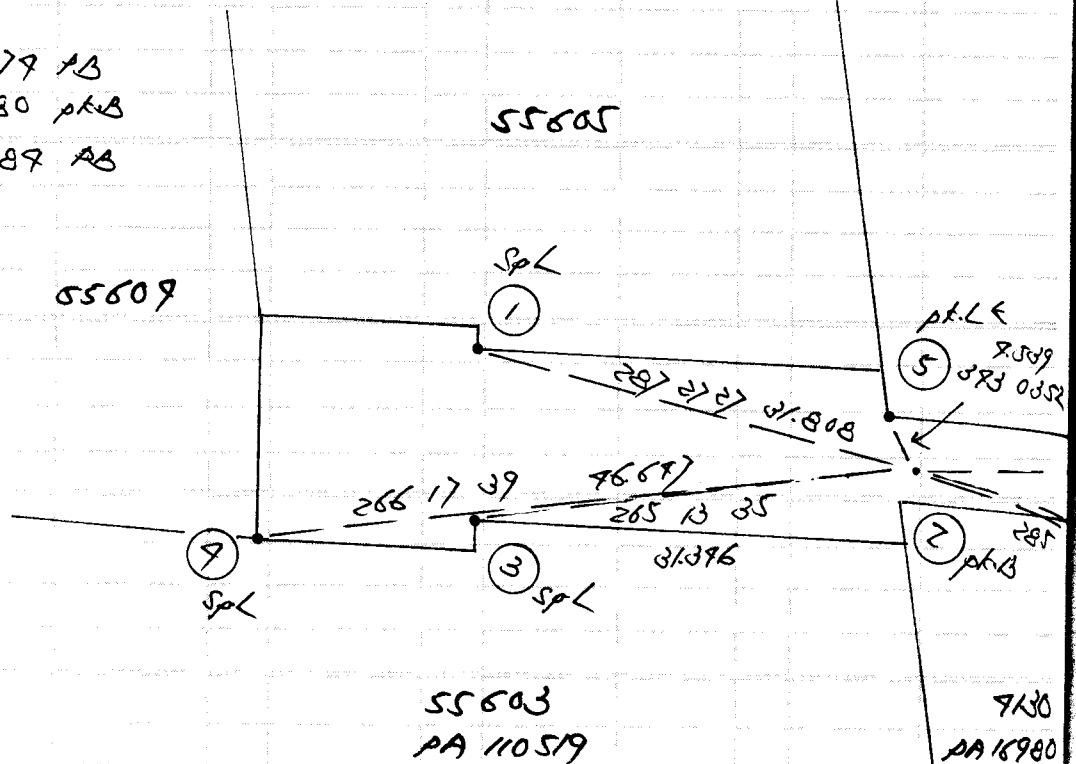

17-1 278 9815 115.222 N
 278 98 51 115.103 PO
 -38' 70.119

1-B 109 3592 120.814 N
 109 3551 120.792 PO
 -9' 70.072


No. Fail

Rajah di muka

Stesen	BEARING / SUDUT		Dari Stn.	GARISAN Bearing Mukamat	Ke Stn.	Sudut Pugak (±)	Jarak	Situ	Jarak Antara Tupang	Jarak Mukamat
	Penyilang Kiri	Penyilang Kanan								

4103
PA16980

WILAYAH PERSEKUTUAN
MURIM KUACA CUMPAK
075
TANAA SKACA

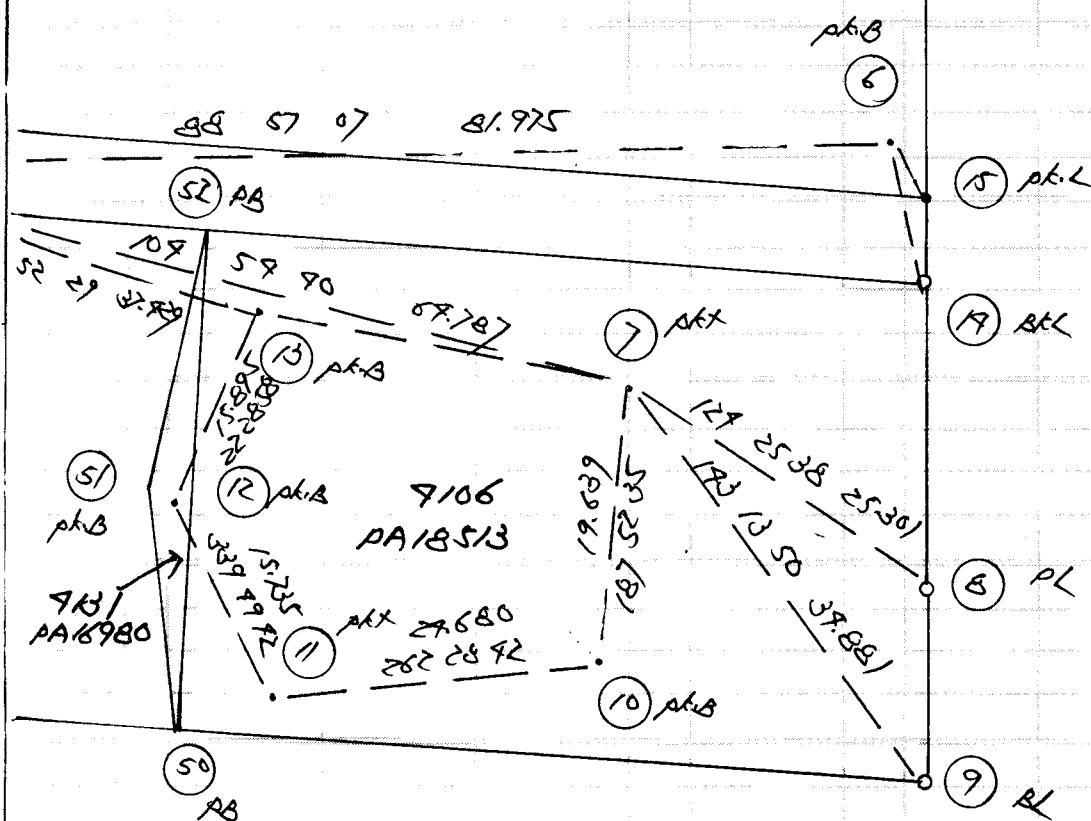

55502
PA110897

CERAPAN MATAHARI BAGI AZIMUT

Penilik _____ Hari _____ Tarikh _____ Bulan _____ Tahun _____

Penilik: PUT2435 Bkt Tunku Tarikh: 15/03/2010

Stn. 1007 Koordinat: S1693.617 B2695.015 W.P. Kuala Lumpur

T.R. 2 B.K. Ms.

Tiodolit Satu bah. aras ufuk:

Waktu	Sasaran	Ufuk	Gelembong	Puguk
	T.R.	284 55 21		
9 30	M.H.	94 59 35	57 34 53	Waktu purata 9 30 30
9 30	M.H.	94 22 08	57 30 03	Beza dari U.T. - 8 00 00
9 31	M.H.	274 22 17	302 37 48	U.T. 1 30 30
9 31	M.H.	275 01 06	302 44 00	Deklinasi - 2 14 29
	T.R.	104 55 11		
	T.R.	284 55 21		
9 34	M.H.	95 04 35	56 48 12	Waktu purata 9 34 30
9 34	M.H.	94 26 33	56 46 15	Beza dari U.T. - 8 00 00
9 35	M.H.	274 26 28	303 21 08	U.T. 1 34 30
9 35	M.H.	275 06 01	303 28 52	Deklinasi - 2 14 25
	T.R.	104 55 11		

	Set 1	Set 2
Sudut pugak	32 34 13	33 18 53
Pembetulan	- 0 01 15	- 0 01 13
Altitud	32 32 58	33 17 40
Jarak kutub	92 14 29	92 14 25
Latitud	3 09 32	3 09 32
Azimut M.H. yang dikira	94 41 09	94 45 57
Purata ke M.H.	94 41 17	94 45 54
Selisih:	0 00 08	0 00 03
Purata ke T.R.	284 55 16	284 55 16
Azimuth T.R. sebenar	284 55 08	284 55 19
Pembetulan aras	+ 0 00 00	+ 0 00 00
Tirusan	- 0 00 34	- 0 00 34
Bering grid T.R.	284 54 34	284 54 45

Purata bering grid T.R. 284 54 40

P.Ki. — Penyilang Kiri
P.Ka. — Penyilang Kanan

T.R. — Tanda Rujuk
Sel — Selisih

W.U. — Waktu Umum
W.T.K. — Waktu Tempatan Ketara

Tarikh *28/4/2014*

Aras

Dibuat untuk

58

Daripada *P07 2735*

Ke

Pandangan Belakang	Pandangan Antara	Pandangan Hadapan	Naik	Turun	Aras Yang Dilaras	Jarak	Catitan
1.508 (1.995)	(1.935)	1.925	(1.668)		66.808	411	
1.327 (1.386)	(1.386)	1.768	(1.579)				
1.183 (1.186)	(1.186)	1.917	(1.629)				
0.952 (1.025)	(1.025)	2.789	(1.915)				
0.075 (1.019)	(1.019)	3.668	(1.203)				
0.094 (1.095)	(1.095)	3.192	(1.031)				
0.290 (1.290)	(1.290)	2.336	(1.730)				
0.883 (1.976)	(1.976)	2.288	(1.751)				
1.956 (1.1109)	(1.1109)	0.312	(1.03)				
3.379		1.250	(1.910)		56.820	78m N1670	24/04 top of sump
10.571		20.781					
1.250					56.820	78m N1670	
3.663 (1.1202)	(1.1202)	0.102	(1.033)		57.568		
3.630 (1.1191)	(1.1191)	0.148	(1.086)		61.083	R6	
3.019 (1.990)	(1.990)	0.327	(1.107)		67.386		
1.369 (1.299)	(1.299)	0.223	(1.073)		67.182	R2	
	0.987	13.281			67.568		
2.104 (1.670)	(1.670)	0.550	(1.60)		68.001		
		1.342	(4.51)		68.713	TBM F1671	Atas Sump
15.035		2.782					

Tarikh Aras

Dibuat untuk

59

Daripada

Ke

Pandangan Belakang	Pandangan Antara	Pandangan Hadapan	Naik	Turun	Aras Yang Dilaras	Jarak	Catitan
0.267	(10.87)				76.983	78m F1672 (74m H1)	78m F1672
0.089	(10.29)	3.923	(11.23)			RC: 76.983m	changkat dide
0.036	(10.12)	7.43	(13.17)			8m 8.237	
0.194	(10.68)	3.744	(12.24)			BM W0113 RC: 32.085m	
0.213	(10.70)	3.471	(11.39)				
0.103	(10.38)	3.578	(11.74)				
0.166	(10.54)	3.763	(11.36)				
0.138	(10.85)	3.636	(11.71)				
0.192	(10.63)	3.963	(11.36)				
		2.992	(7.82)		66.508	411	
1.398		3.177					