


No. Fail 2472792 Fpk.

Rajah di muka

Stesen	BEARING / SUDUT			Dari Stn.	GARISAN		Ke Stn.	Sudut Pukak (±)	Jarak	Suhu	Jarak Antara Tupang	Jarak Muktamat
	Penyilang Kiri	Penyilang Kanan	Purata		Bearing Muktamat							
	Dataran Dangpadan			2	189 41 18		1	4	97.852	147/240		97.852
					pk.B Az Ak.			pk.L				
					Dgn m							
2-4	182 17 10			2	182 17 10		4	4	198.428		B/L	198.428
2-5	301 02 59			2	301 02 59		5	4	5.971		B/L	5.971
6-9	183 39 58			6	183 39 58		9	4	177.985		B/L	177.985
6-10	11 40 13			6	11 40 13		10	4	97.362		PL	97.362
	1 189 41 18	4 41 18	1 12 07	2	1 12 07		6	4	281.336			281.336
2												
6	1 12 07	181 12 07										
	pk.B											
2	181 12 07	1 12 07	359 52 23	6	359 52 23		7	4	292.407			292.407
6												
7	359 52 23	179 52 23										
	pk.B											
2	Springs Di Atas	352 40 26	6	352 40 26	8		4	4	55.099			55.099
6												
8	352 40 26	172 40 26										
	pk.B											
6	172 40 26	352 40 26	4 10 47	8	4 10 47		11	4	208.434			208.434
8												
11	4 10 47	184 10 47										
	pk.B											
11-12	179 39 20			11	179 39 20		12	4	116.245		pk.L	116.245
11-13	176 32 36			11	176 32 36		13	4	15.904		PL	15.904
11-14	290 31 00			11	290 31 00		14	4	236.521		AL	236.521

No. Fail


Rajah di muka

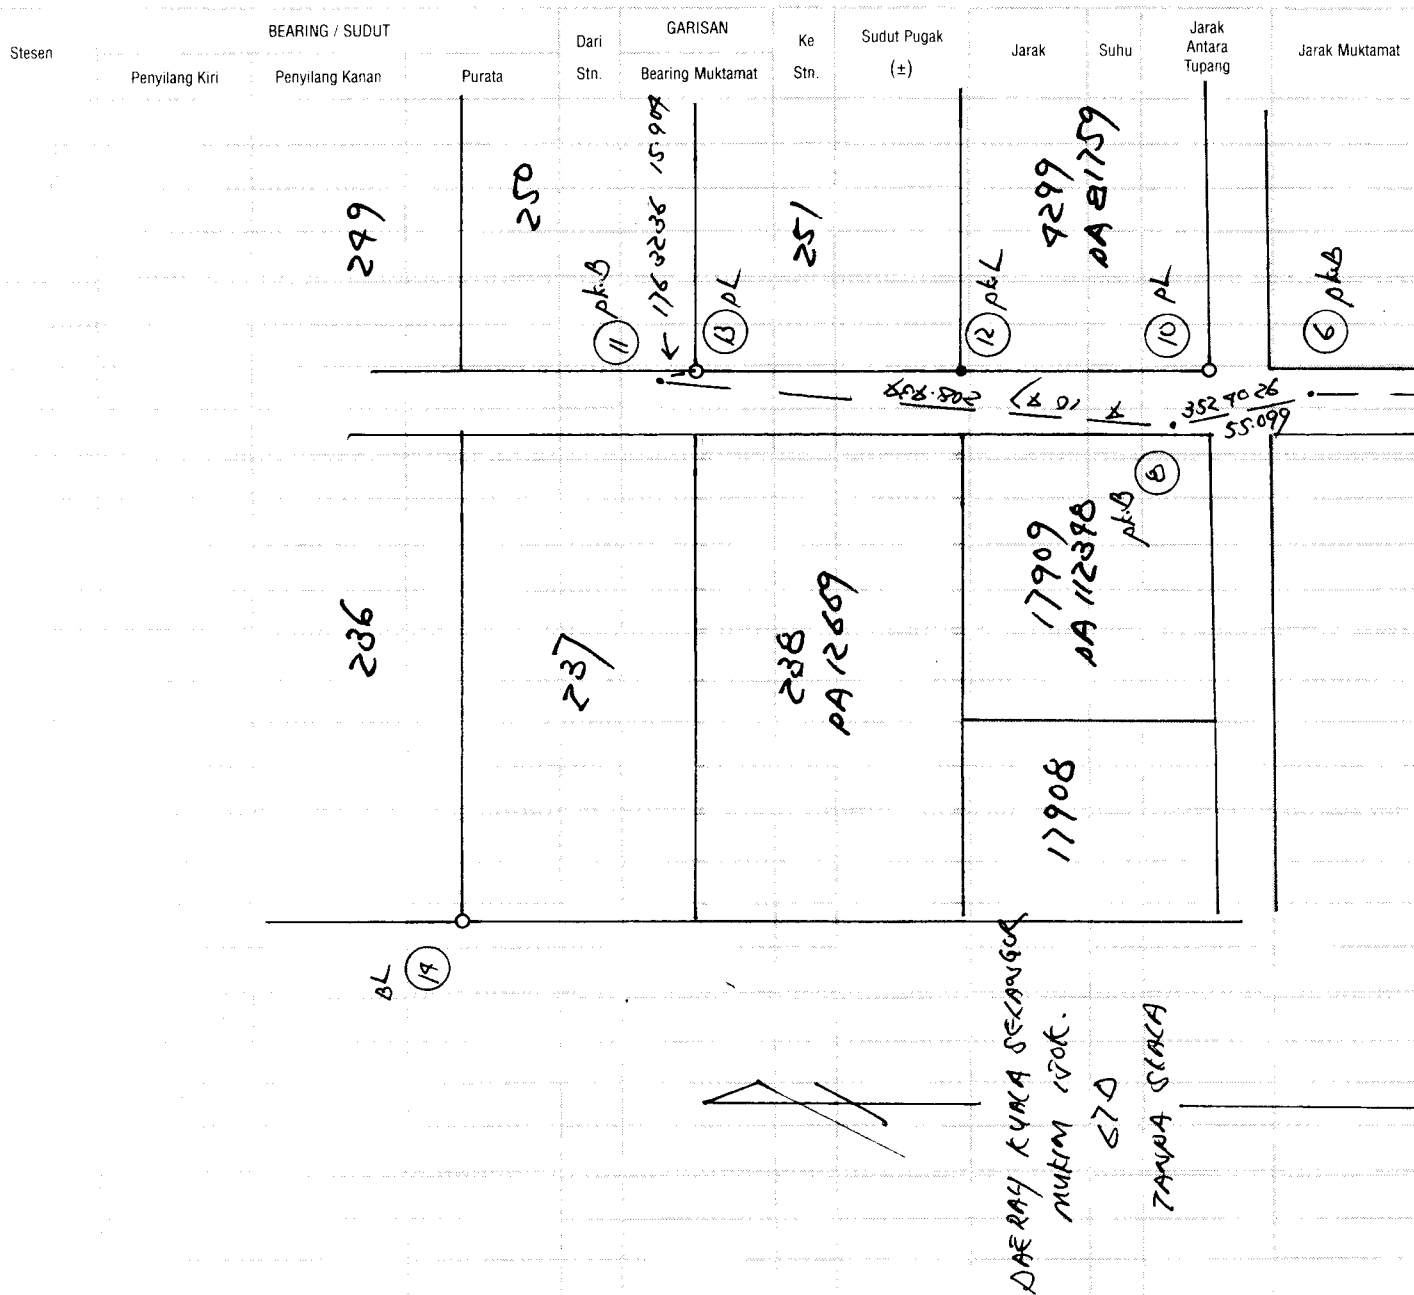

No. Fail

Rajah di muka

Stesen	BEARING / SUDUT			Dari Stn.	GARISAN Bearing Mukamat	Ke Stn.	Sudut Pugak (±)	Jarak	Suhu	Jarak Antara Tupang	Jarak Mukamat
	Penyilang Kiri	Penyilang Kanan	Purata								

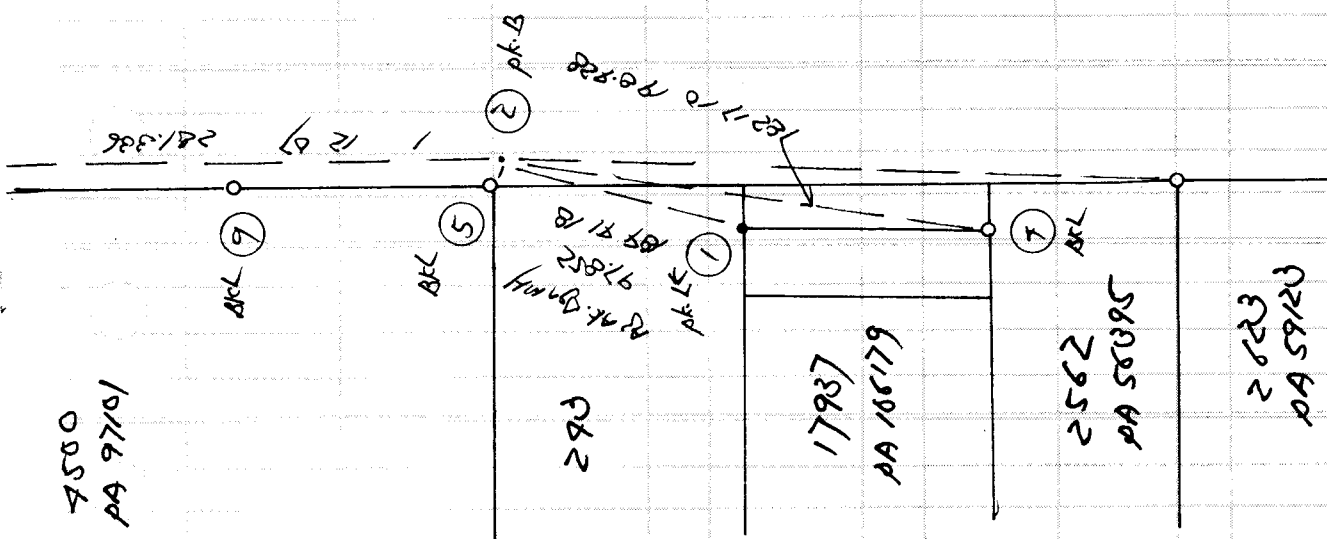

1-13 2 06 30 625.876 ~
 2 07 38 625.932 PD

 -1 08' -0.056

4-13 1 48 39 726.580 ~
 1 49 18 726.602 PD

 -48" -0.092

CERAPAN MATAHARI BAGI AZIMUT

Penilik _____ Hari _____ Tarikh _____ Bulan _____ Tahun _____
 Stesen _____ T.R. _____ B.K. _____ Ms. _____ Tiodolait (Jenis) _____ l Bah. Aras Ufuk - a _____

Penilik: PUT2492 IJOK Tarikh: 10/07/2010
 Stn. 2 Koordinat: U10727 B28101 Selangor
 T.R. 1 B.K. Ms.
 Tiodolit Satu bah. aras ufuk:

Waktu	Sasaran	Ufuk	Gelembong	Puguk
	T.R.	197 00 00		
8 54	M.H.	79 46 17	66 58 31	Waktu purata 8 54 30
8 54	M.H.	79 11 28	66 53 55	Beza dari U.T. - 8 00 00
8 55	M.H.	259 10 02	293 12 20	U.T. 0 54 30
8 55	M.H.	259 43 49	293 17 32	Deklinasi 22 16 05
	T.R.	17 00 00		
	T.R.	197 00 00		
8 56	M.H.	79 42 32	66 25 24	Waktu purata 8 56 30
8 56	M.H.	79 07 29	66 20 58	Beza dari U.T. - 8 00 00
8 57	M.H.	259 05 58	293 45 23	U.T. 0 56 30
8 57	M.H.	259 39 55	293 51 39	Deklinasi 22 16 04
	T.R.	17 00 00		

	Set 1	Set 2
Sudut pugak	23 09 22	23 42 40
Pembetulan	- 0 01 56	- 0 01 53
Altitud	23 07 26	23 40 47
Jarak kutub	67 43 55	67 43 56
Latitud	3 16 16	3 16 16
Azimut M.H. yang dikira	67 09 02	67 05 02
Purata ke M.H.	79 27 54	79 23 58
Selisih:	- 12 18 52	- 12 18 56
Purata ke T.R.	197 00 00	197 00 00
Azimuth T.R. sebenar	184 41 08	184 41 04
Pembetulan aras	+ 0 00 00	+ 0 00 00
Tirusan	+ 0 00 12	+ 0 00 12
Bering grid T.R.	184 41 20	184 41 16
Purata bering grid T.R.		184 41 18

Tarikh

Aras

Dibuat untuk

Daripada

Ke

Jok.

24/7 2782

Pandangan Belakang	Pandangan Antara	Pandangan Hadapan	Naik	Turun	Aras Yang Dilaras	Jarak	Catitan
1.135	(3.72)	(14.83)			10.183	78M F1743 / F11	tpi pink Abu 3/66.
	1.712				9.856	F7	
3.033	(19.95)	1.276	(4.19)		10.052		
1.601	(5.25)	0.811	(2.61)		12.278	F8	
	1.170	(3.88)			12.205	F6	
1.329	(9.36)	1.089	(3.57)		12.786		
1.142	(3.75)	1.778	(5.83)		12.337		
0.662	(2.17)	2.131	(6.99)		11.398	F2	
0.568	(1.85)	2.670	(8.76)		9.390		
0.989	(3.29)	1.816	(5.96)		8.088		
		2.203	(7.23)		6.878	78M/5X3	RC: 6.878 CG 12 M/S 83
10.755		13.778					BM 18 2080 RC: 11.027m