

Rajah di muka

[illegible]

No. Fail

Rajah di muka

Stesen	BEARING / SUDUT			Dari Stn.	GARISAN Bearing Mukamat	Ke Stn.	Sudut Pukak (±)	Jarak	Suhu	Jarak Antara Tupang	Jarak Mukamat
	Penyilang Kiri	Penyilang Kanan	Purata								
3-11	126 08 23	182.219 N									
	126 08 23	182.227 PO									
	N.1		-0.008								
3-9	211 08 20	55.562 N									
	211 08 00	55.563 PO									
	+21'		-0.001								
3-8	169 09 52	296.826 N									
	169 05 38	296.709 PO									
	-46'		+0.117								


Demarcation.

7-12	13 43 11	38.88	AB
2-13	32 05 19	103.681	77
2-19	32 06 09	102.181	AB (offset 1.500 m).

MUKAM OF KLANG.
DISTRICT OF KLANG.
106-B
NOT TO SCALE

No. Fail

Rajah di muka

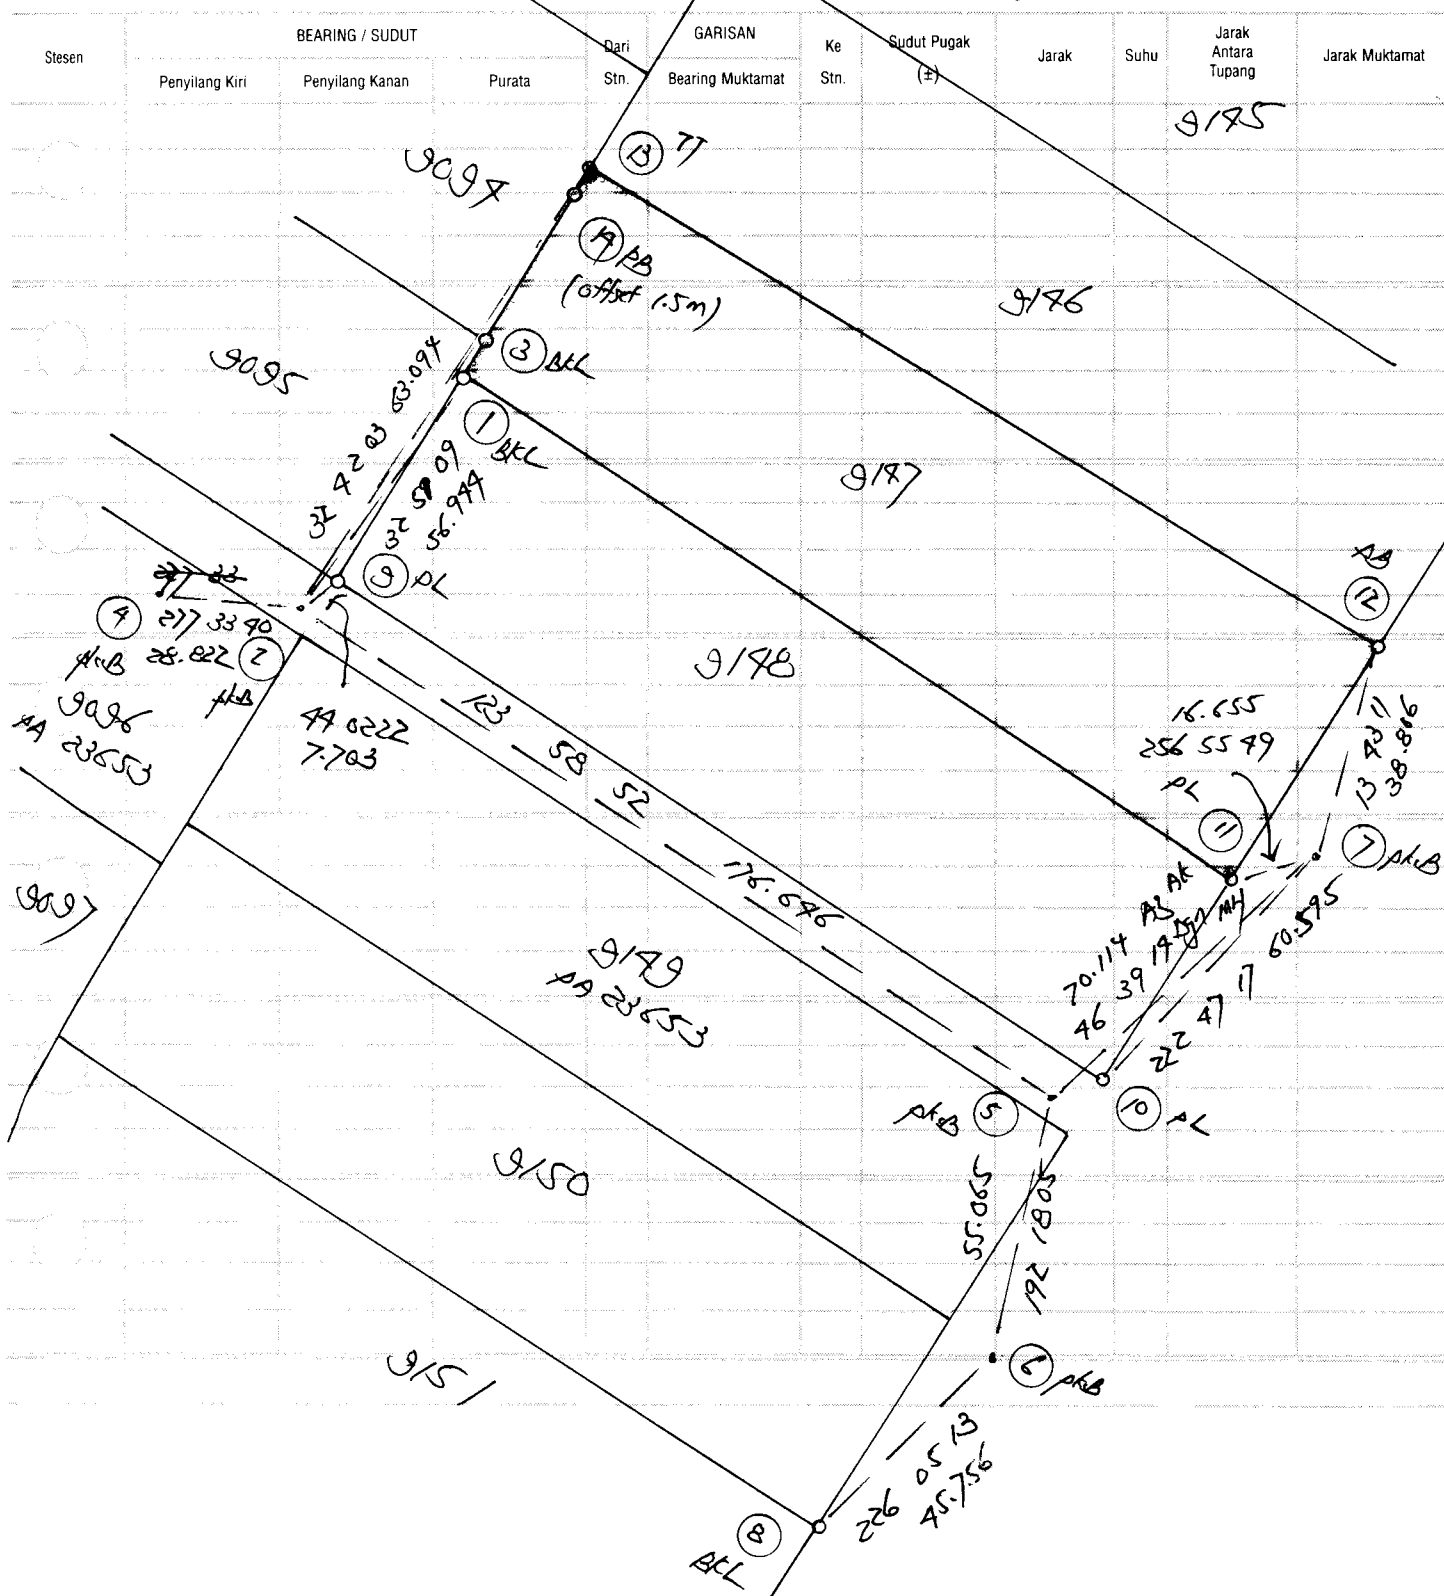

CERAPAN MATAHARI BAGI AZIMUT

Penilik _____ Hari _____ Tarikh _____ Bulan _____ Tahun _____

Penilik: FOO CHEE YONG Tarikh: 15/05/2008
 Stn. 7 Koordinat: S24863 B35711 Selangor
 T.R. 5 B.K. Ms.5 R6
 Tiodolit Satu bah. aras ufuk:

p47219/
 Teluk Gong.

Waktu	Sasaran	Ufuk	Gelembong	Puguk
	T.R.	226 39 12		
09 52	M.H.	68 23 38	51 28 50	Waktu purata 9 52 30
9 52	M.H.	67 41 58	51 26 02	Beza dari U.T. - 8 00 00
9 53	M.H.	247 39 10	308 42 20	U.T. 1 52 30
9 53	M.H.	248 18 14	308 48 47	Deklinasi 18 55 29
	T.R.	46 39 12		
	T.R.	226 39 12		
9 50	M.H.	68 30 12	51 54 21	Waktu purata 9 50 30
9 50	M.H.	67 48 41	51 51 11	Beza dari U.T. - 8 00 00
9 51	M.H.	247 46 38	308 15 07	U.T. 1 50 30
9 51	M.H.	248 25 43	308 20 11	Deklinasi 18 55 28
	T.R.	46 39 12		

	Set 1	Set 2
Sudut pugak	38 39 04	38 12 27
Pembetulan	- 0 00 59	- 0 01 00
Altitud	38 38 05	38 11 27
Jarak kutub	71 04 31	71 04 32
Latitud	2 56 57	2 56 57
Azimuth M.H. yang dikira	68 00 09	68 07 12
Purata ke M.H.	68 00 45	68 07 48
Selisih:	- 0 00 36	- 0 00 36
Purata ke T.R.	226 39 12	226 39 12
Azimuth T.R. sebenar	226 38 36	226 38 36
Pembetulan aras	+ 0 00 00	+ 0 00 00
Tirusan	+ 0 00 23	+ 0 00 23
Bering grid T.R.	226 38 59	226 38 59

Purata bering grid T.R. 226 38 59

P.Ka - Penyilang Kanan

Sel - Selisih

W.U. - Waktu Umum
 W.T.K. - Waktu Tempatan Ketara

Tarikh 24/7 219/

Aras Dibuat untuk 43

Daripada 72/44 Gony. Ke

Pandangan Belakang	Pandangan Antara	Pandangan Hadapan	Naik	Turun	Aras Yang Dilaras	Jarak	Catitan
1.998	(6.39)				2.059	78M F/1381	nailon top of cen. drain
	1.571	(5.15)			2.986	F7	
1.362	(9.86)	1.393	(9.57)		2.614	A5	
1.975	(9.84)	1.629	(5.33)		2.352	C4	
	2.008	(6.59)			1.819	78M F/1382	Abas Btl
	1.291	(9.29)			2.536	78M F/1382A	Abas culvert, breakdown sign abg R2
	1.999	(9.92)			2.328	R2	
9.785		9.54				C42	
1.368	(9.99)				2.328		
1.367	(9.98)	1.681	(5.52)		7.550	R2	
1.565	(5.18)	1.567	(5.18)				
1.953	(9.77)	1.570	(5.15)				
1.532	(5.03)	1.528	(5.0)				
1.725	(5.66)	1.506	(9.98)				
1.573	(5.8)	1.992	(9.96)				
	1.178	(3.66)			2.391	78M F/1383	Di Cen. Drain Kilang probot circle valley side btl
10.583		9.922				C4X	Lot 11920
		10.520					Jalan perajurit

Tarikh Aras


Dibuat untuk

44

Daripada

Ke

Pandangan Belakang	Pandangan Antara	Pandangan Hadapan	Naik	Turun	Aras Yang Dilaras	Jarak	Catitan
1.178					2.391	→ 78m P/1383	
1.503 (19.83)		1.553 (15.10)					
1.712 (15.62)		1.908 (19.62)					
1.813 (19.83)		1.998 (19.75)					
1.613 (15.29)		1.909 (18.60)					
1.579 (15.18)		1.382 (18.53)					
1.995 (19.91)		1.650 (15.82)					
1.923 (19.67)		1.570 (15.15)					
		1.802 (15.91)			1.996	→ 78m P/1384	
11.81611		12.271					
1.802					1.990	→ 78m P/1385	
1.67 (15.90)		1.874 (16.18)					
1.930 (19.69)		1.678 (15.51)					
1.577 (15.17)		1.912 (19.63)					
1.705 (15.59)		1.680 (15.85)					
		1.067 (13.99)			2.963	→ 78m P/1386A	
8.1611		7.688					

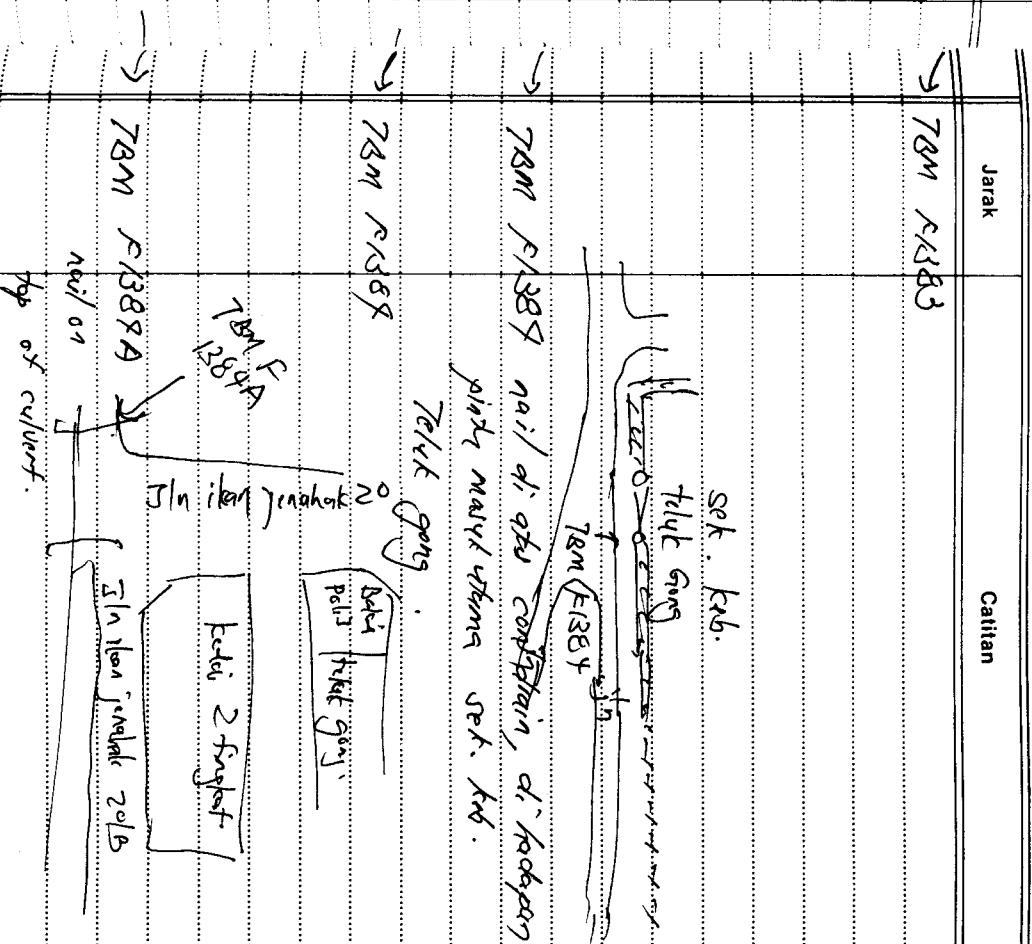


Tarikh Aras

Dibuat untuk Ke

45

Daripada

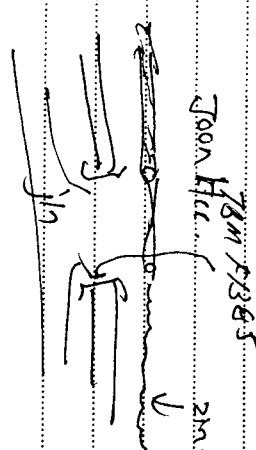Pandangan Belakang	Pandangan Antara	Pandangan Hadapan	Naik	Turun	Aras Yang Dilaras	Jarak	Catitan
1.069					2.963	78M 513894	
7.84 1.681 (5.35)		1.740	(5.71)				
1.571	(5.15)	1.520	(4.98)				
1.600	(5.25)	1.533	(5.03)				
1.499	(4.92)	1.569	(5.15)				
1.484	(4.87)	1.517	(4.88)				
1.728	(5.67)	1.569	(5.15)				
0.527		0.331	(1.09)		3.271	78M 51385	
		2.779					
0.331 (1.09)					3.271	78M 51385	nail on top of bar culvert, Ki hadapa, putu utama kilang Joan the miron sdn. bhd. lot 8909
1.590 (5.22)		1.302	(4.27)				
1.570 (5.15)		1.607	(5.27)				
0.399		1.473	(4.83)		2.380	78M	pc: 2.380m. BM 80184
0.460		(4.382)					