


No. Fail

Rajah di muka

Stesen	BEARING / SUDUT			Dari Stn.	GARISAN Bearing Muktamat	Ke Stn.	Sudut Pugak (±)	Jarak	Suhu	Jarak Antara Tupang	Jarak Muktamat
	Penyilang Kiri	Penyilang Kanan	Purata								

DAERAH PETALUNG.
MUKIM SUNGAI BUKUH
BT-A
TANPA SKALA

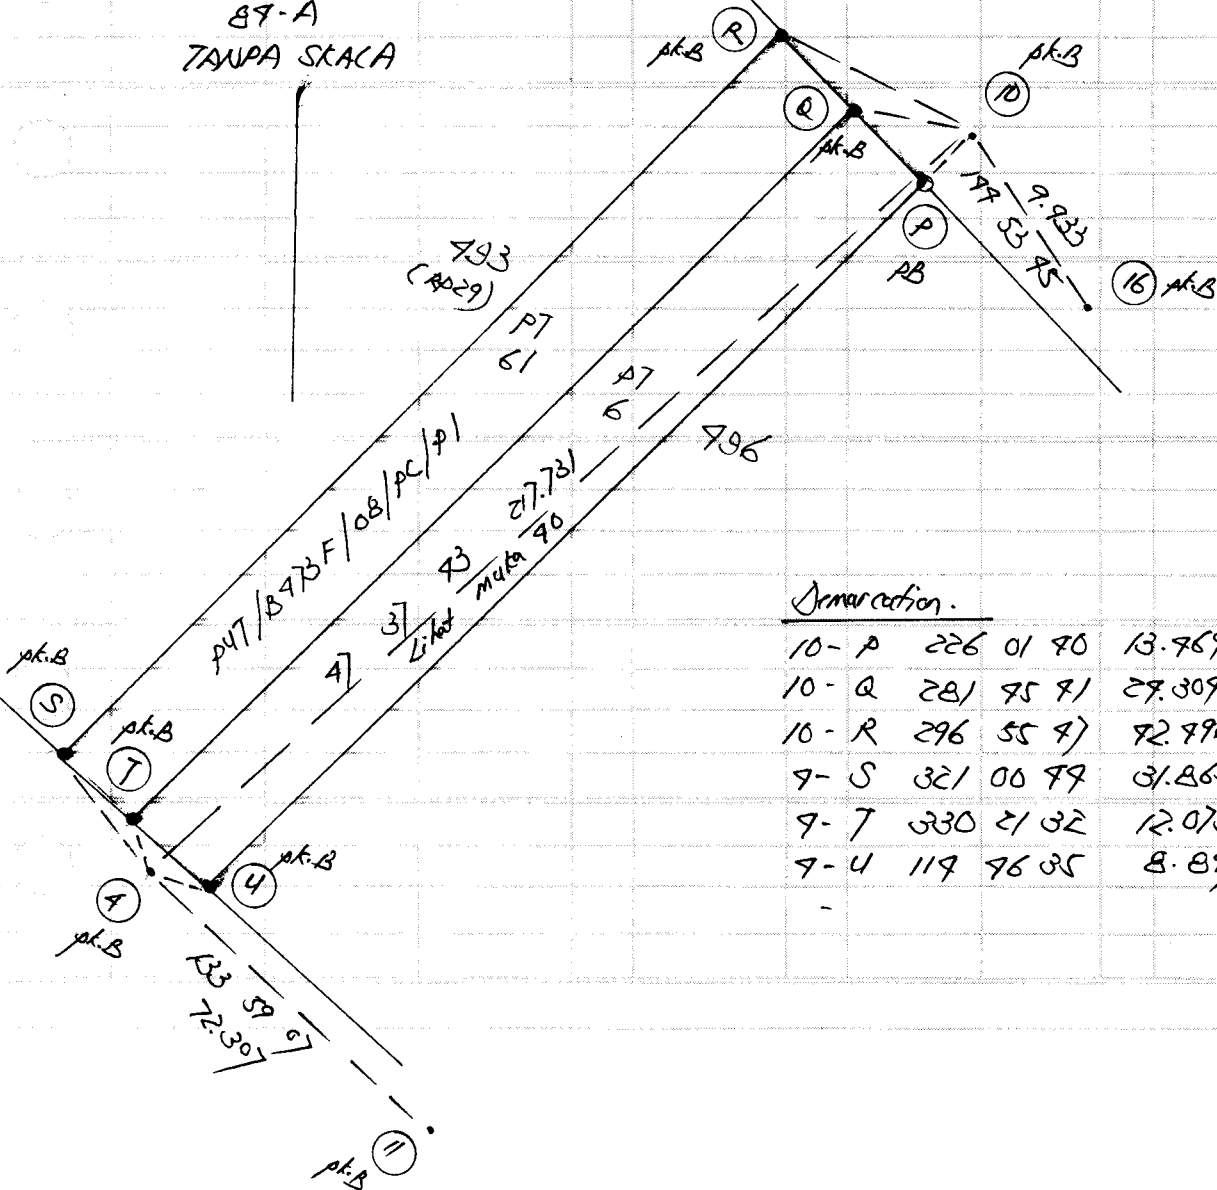

Demarcation.

10 - P	226	01	40	13.767	(PB)
10 - Q	281	45	41	27.307	(pk.B)
10 - R	296	55	47	72.796	(pk.B)
9 - S	321	00	49	31.265	(pk.B)
9 - T	330	21	32	12.073	(pk.B)
9 - U	119	46	35	8.877	(pk.B)