

047 2297 Skill 0052 (by Medon)

21/2/09
Jatun Jari padu PA 1915919 > 1915919 1 4 36.765 36.765

2-3 1981557 2 1981557 3 4 12.979 B/L 12.979
2-4 1830007 2 1830007 4 4 36.881 B/L 36.881

1 1915919 115919 2755213 2 2755213 5 4 122.071 122.071
2
5 2755213 955213
pk.B
Ag At.
Dgn MY

1 983738 983738 2 983738 6 4 196.978 196.978
2

6 983738 2783738
pk.B

2 2783738 983738 1895651 6 1895651 7 4 68.838 68.838
6

7 1895651 95651
pk.B

6-8 1850909 6 1850909 8 4 37.553 B/L 37.553
6-9 1777338 6 1777338 9 4 13.786 B/L 13.786

6 95651 1895651 2961999 7 2961999 10 4 30.955 S/L 30.955
7

10 2961999 1161999
S-L

Date of trade

2 05 5213 255213 256 9699 5
5


11 4 99.100

99.100

11 256 9699 76 9699
pt.B

Demarcation.


5-A	1273992	4.763	HWP
5-F	1892693	61.637	pt.B
11-B	795726	16.171	HWP
11-C	1929236	2.663	HWP
11-D	2159296	11.086	HWP
11-E	2002910	28.756	HWP

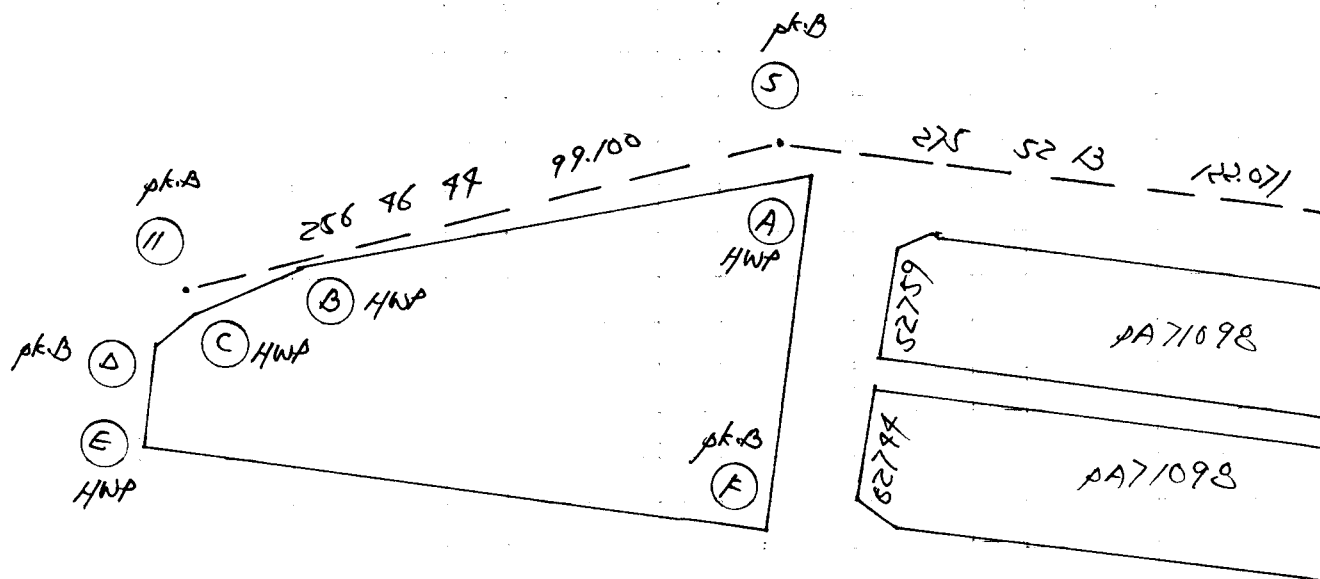

Rajah di muka

DAERAH DETALING.
MUKIM DETALING.

93 A
TANPA SKALA

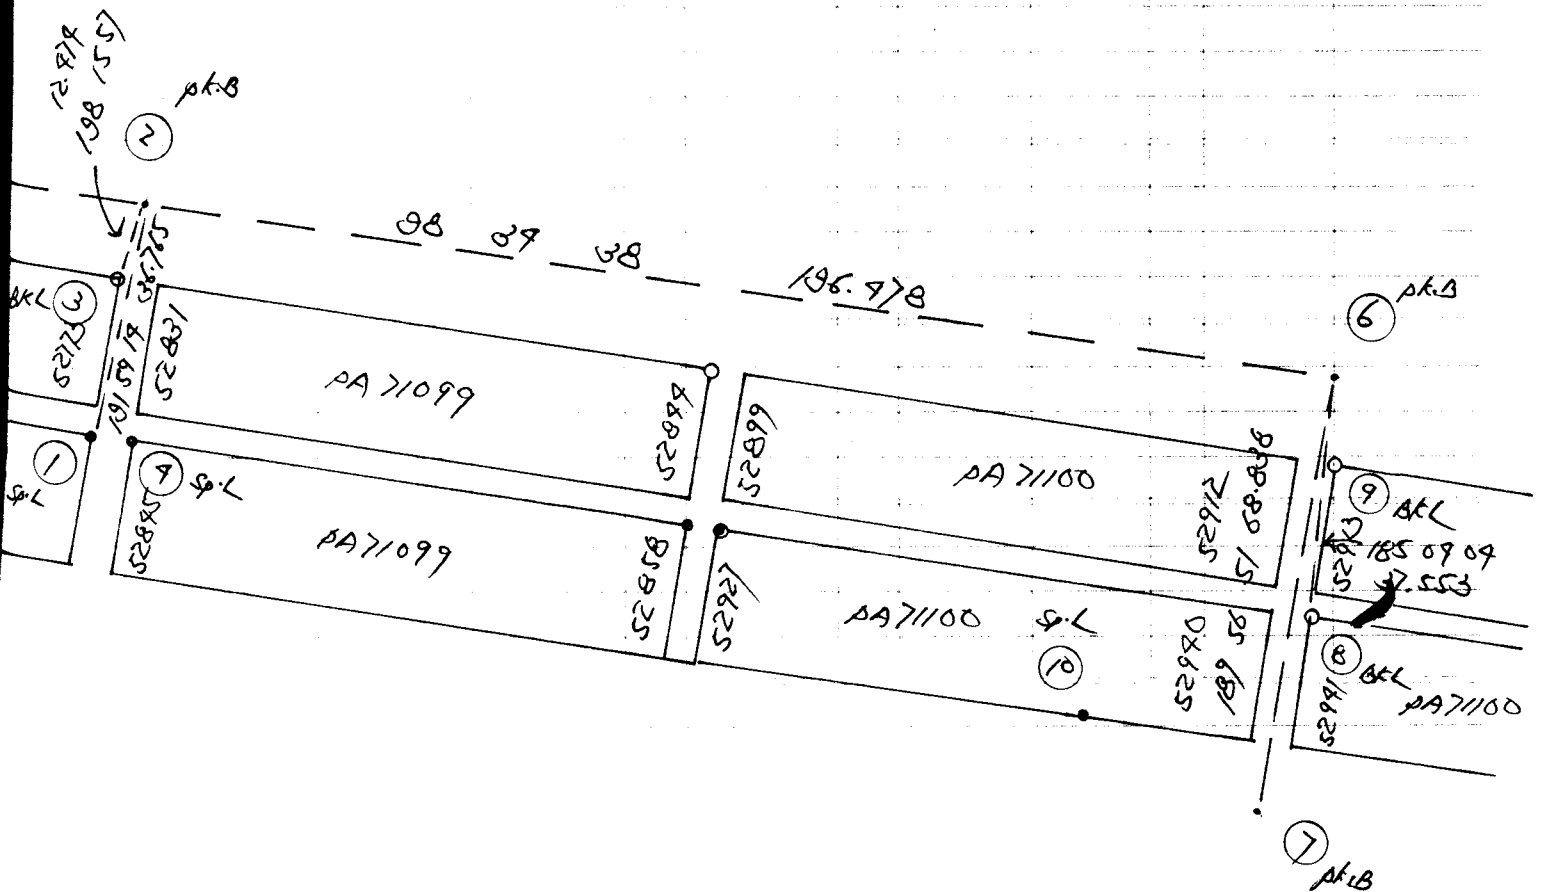

Penilik: PUT2297 Kg Medan Tarikh: 21/02/2009

Stn. 2 Koordinat: S9993 B7568 Selangor

T.R. 3 B.K. Ms.

Tiodolit Satu bah. aras ufuk:

Waktu	Sasaran	Ufuk	Gelembong	Puguk		
	T.R.	275 54 09				
8 35	M.H.	102 13 25		74 05 08	Waktu purata	8 35 30
8 35	M.H.	101 40 19		73 59 23	Beza dari U.T. -	8 00 00
8 36	M.H.	281 40 41		286 07 26	U.T.	0 35 30
8 36	M.H.	282 15 03		286 12 00	Deklinasi	- 10 34 45
	T.R.	95 54 03				

	T.R.	275 54 09				
8 37	M.H.	102 16 28		73 38 45	Waktu purata	8 37 30
8 37	M.H.	101 43 11		73 34 53	Beza dari U.T. -	8 00 00
8 38	M.H.	281 43 31		286 31 46	U.T.	0 37 30
8 38	M.H.	282 18 09		286 38 50	Deklinasi	- 10 34 43
	T.R.	95 54 03				

	Set 1	Set 2
Sudut pugak	16 03 44	16 29 15
Pembetulan	- 0 02 54	- 0 02 49
Altitud	16 00 50	16 26 26
Jarak kutub	100 34 45	100 34 43
Latitud	3 05 02	3 05 02
Azimut M.H. yang dikira	101 55 54	101 58 51
Purata ke M.H.	101 57 22	102 00 20
Selisih:	- 0 01 28	- 0 01 29
Purata ke T.R.	275 54 06	275 54 06
Azimuth T.R. sebenar	275 52 38	275 52 37
Pembetulan aras	+ 0 00 00	+ 0 00 00
Tirusan	- 0 00 25	- 0 00 25
Bering grid T.R.	275 52 13	275 52 12

Purata bering grid T.R. 275 52 13

----- grid T.R. 105 00 52 105 00 53

Purata bering grid T.R. 105 00 53

Tarikh 24/7/2029

Aras

Dibuat untuk

61

Daripada

04/11/2022

Ke

Pandangan Belakang	Pandangan Antara	Pandangan Hadapan	Naik	Turun	Aras Yang Dilaras	Jarak	Catitan
1.259 (7.13)	1.303 (7.27)				21.391	78m F/151	nail atau longkong.
1.385 (7.59)	1.668 (8.97)				20.942	94	
	1.852 (6.08)				20.515	F	
	0.895 (2.98)				21.972	78m F/1510	nail brush unipole CP
2.078'		2.565'					
2.167							
2.112 (7.13)					21.972	78m F/1510	
1.768 (7.81)	1.258 (7.13)						
1.586 (5.20)	1.798 (5.90)					78m F	1376 / F32
	1.232 (7.09)				22.910		522091 kg Menden.
5.226'		7.288'					LB 06 m/1.98
							PC: 22.910
1.599 (5.25)					21.387	AS	
1.753 (5.75)	1.081 (3.55)				21.865		BM 80509
	1.293 (7.29)				22.325	AS	
3.352'		2.379'					