

PUT WS/BF Bkt Damansara.

Rajah Bagan

8/5/09

Asyura Danipada	5 00 00	2	5 25 00	1	4	96.539	96.539
PC Bening	MT 25'						

1	5 00 00	185 00 00	192 93 92	2	193 08 92	3	4	39.099	39.099
2			MT 25'						

3 192 93 92 322 93 92
BKL

1	Seperti Di Atas	132 59 59	2	133 19 59	9	4	25.361	25.361
2		MT 25'						

9 132 59 59 322 59 59
BKL

1	Seperti Di Atas	199 17 92	2	199 42 92	5	4	63.163	63.163
2		MT 25'						

5 199 17 92 329 17 92
BKL

1	Seperti Di Atas	20 03 30	2	20 28 30	6	4	23.659	23.659
2		MT 25'						

6 20 03 30 206 03 30
BKL

1	Seperti Di Atas	71 59 27	2	72 19 27	7	4	79.735	79.735
2		MT 25'						

7 71 59 27 251 59 27
pt.L

1	Seperti Di Atas	65 23 30	2	65 48 30	8	4	51.635	51.635
2		MT 25'						

8 65 23 30 275 23 30
SpL

[illegible]

13	2150916	350916	73 5903 ²⁹⁰³	15	73 5903	16	4	77.782	77.782
15	73 2903	223 2903	MT 25'						
16	73 5903	223 5903							
	pk.B								
15	223 2903	73 2903	308 5217	16	309 1717	17	4	121.336	121.336
16			MT 25'						
17	308 5217	128 5217							
	pk.B								
16	128 5217	308 5217	22 9999	17	23 0999	18	4	83.796	83.796
17			MT 25'						
18	22 99 99	202 9999							
	BKL								
16	Sports Di Atas	22 33 50	17 22 52 50	18	4			70.039	70.039
17		MT 25'							
18	22 33 50	202 33 50							
	BKL								
16	Sports Di Atas	285 33 96	17 285 33 96	20	4			118.153	118.153
17		MT 25'							
20	285 33 96	105 33 96							
	pk.B								
17	105 33 96	285 33 96	251 56 91	20 252 21 91	21	4		79.897	79.897
20		MT 25'							
21	251 56 91	71 56 91							
	pk.B								
20	71 56 91	251 56 91	229 99 09	21 225 09 09	1	4		82.831	82.831
21		MT 25'							
1	229 99 09	99 99 09							

21 999909 2299909 1850000 / 1852500 2 Sila Lhat m/s/ R1
/ 18 00 00 5 MT 25'
2 18 00 00 1850000


Bering 1-2 Di baaq 1852500
Sepatutnya Di baaq 1852500
Tikarong Ni/
Pambetulan Ni/




WILAYAH PERSEKUTUAN
MUKIM KUACA CUMPUK.
BS.13
TANDA SKACA

7-19 90 99 39 58 159.200NPO
99 90 13 159.189N
+15" + -0.01/

2-3	183	0842	39.099	pt.B
2-7	133	19 59	25.361	
2-5	199	4242	63.163	
2-6	20	2830	23.859	
2-7	72	1927	99.735	
2-8	65	9830	51.635	

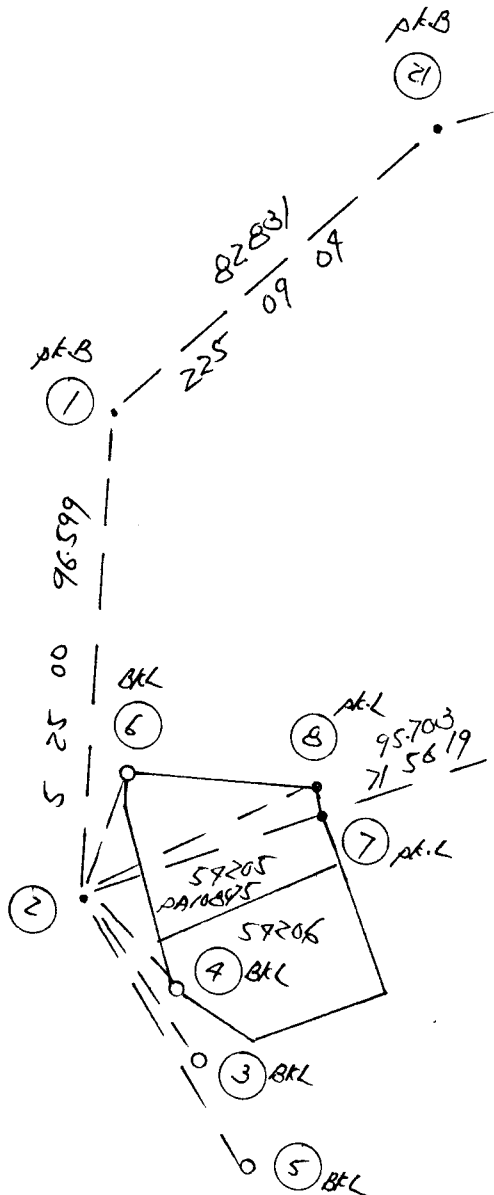

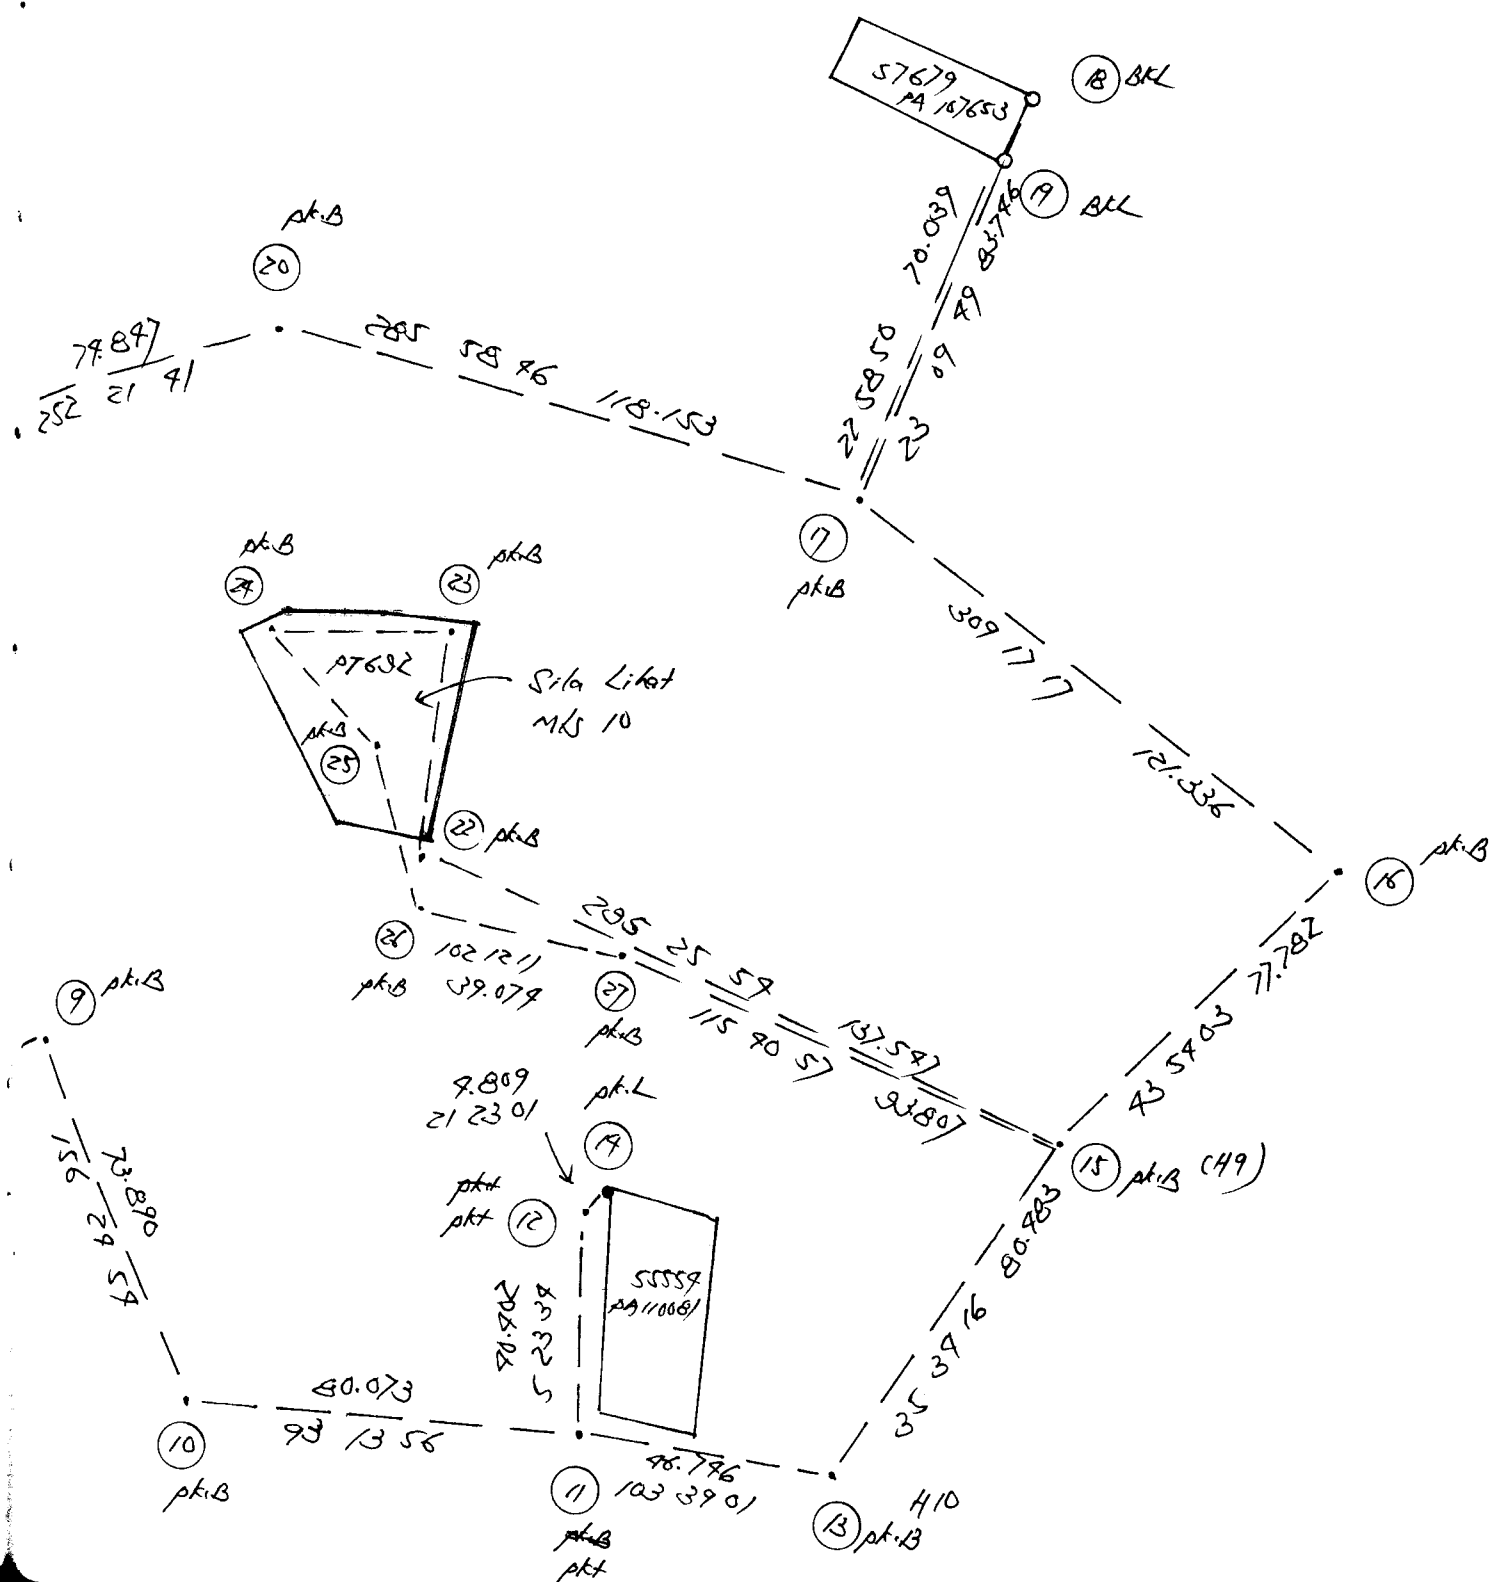

2/5/09

13	215 3916	35 3916	295 2557	15	295 2557	22	4	137.597	137.597
15									
22	295 2557	115 2557							
	pk.B								
15	115 2557	295 2557	6 3816	22	6 3816	23	4	73.605	73.605
22									
23	6 3816	186 3816							
	pk.B								
22	186 3816	6 3816	271 1816	23	271 1816	27	4	33.832	33.832
23									
27	271 1816	91 1816							
	pk.B								
23	91 1816	271 1816	135 5353	27	135 5353	25	4	31.307	31.307
27									
25	135 5353	375 5353							
	pk.B								
27	375 5353	135 5353	165 0225	25	165 0225	26	4	32.879	32.879
25									
26	165 0225	375 0225							
	pk.B								
25	375 0225	165 0225	102 1211	26	102 1211	27	4	39.079	39.079
26									
27	102 1211	282 1211							
	pk.B								
26	282 1211	102 1211	115 7057	27	115 7057	15	4	33.807	33.807
27									
15	115 7057	295 7057							

27 2054057 1154057 2153916 15 2153916 13 Sika Lihet m/s 2 R7
 15
 13 2153916 053916

Bering 15-13 Sibaca 2153916
 Sepatutnya Sibaca 2153916
 Tikaiqan ni/
 Pambetulan ni/

15 1152559 2052559 929998 22 929998 50 4 2.920 2.920

22

50 929998 2229998

pk.L ←

23 911816 2711816 900530 29 900530 51 4 38.337 38.337

29

51 900530 2700530

pk.L ←

23 Seperti Di Atas 899757 29 899757 52 4 21.679 21.679

29

52 899757 2899757

pk.L ←

23 Seperti Di Atas 591308 29 591308 53 4 7.139 7.139

29

53 591308 2391308

pk.B ←

29 Seperti Di Atas ⁷⁹28997616 23 28997916 59 4 5.095 5.095

23

59 28997916 8997616

pk.B (RM) ←

23 ~~27~~ 9/18/16 27/18/16 268 5397 23 268 5397 55 4 5.702 5.702
 27 ~~25~~ 27

55 268 5397 88 5397

23 77
 27 ~~25~~ Seperti Di Atas 265 0978 25 265 0978 56 4 5.297 5.297
 27 27

56 265 0978 85 0978

pt.B

27 035 5353 135 5353 210 5838 25 210 5838 57 4 16.885 16.885
 25

57 210 5838 030 5838

pt.B ←


27 25 Seperti Di Atas 173 5637 25 173 5637 58 4 18.391 18.391
 25

58 173 5637 053 5637

pt.B ←

Plant BKB

22-50	72 77 78	2.720	pt.L
29-51	90 05 30	08.337	pt.L
29-52	87 77 57	21.679	pt.L
29-53	59 13 08	7.139	pt.B
29-54	269 79 16	5.075	pt.B (RM)
29-55	268 53 77	5.702	77
29-56	265 09 78	5.297	pt.B (RM)
25-57	210 58 38	16.885	pt.B
25-58	173 56 37	18.391	pt.B

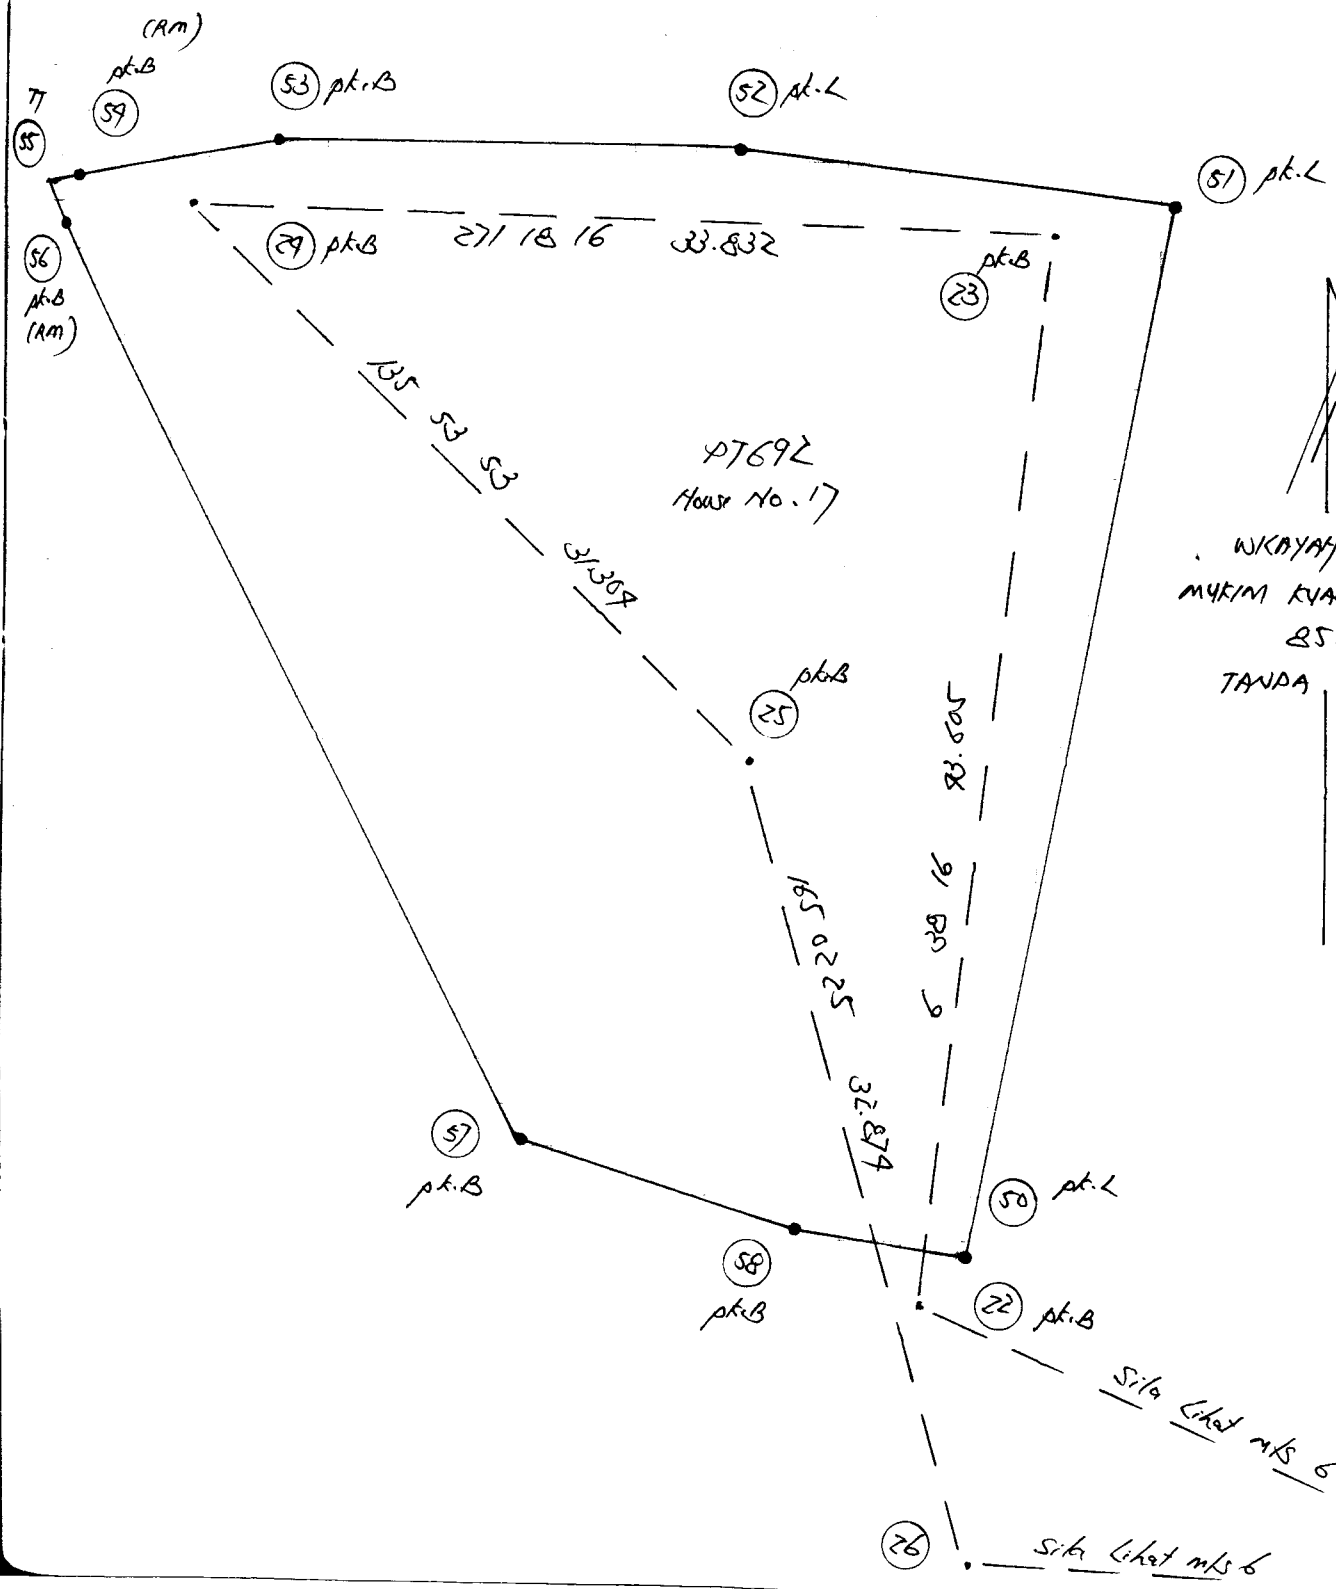

WILAYAH PERSEKUTUAN
MUKIM KAKA LUMPUR
85B
TANDA SKALA