


LOTS 298 & 299

Being subdivision of lot 157 - C. P. 5687

Town Area XXIX

TOWN OF MALACCA

Scale One Chain to an Inch

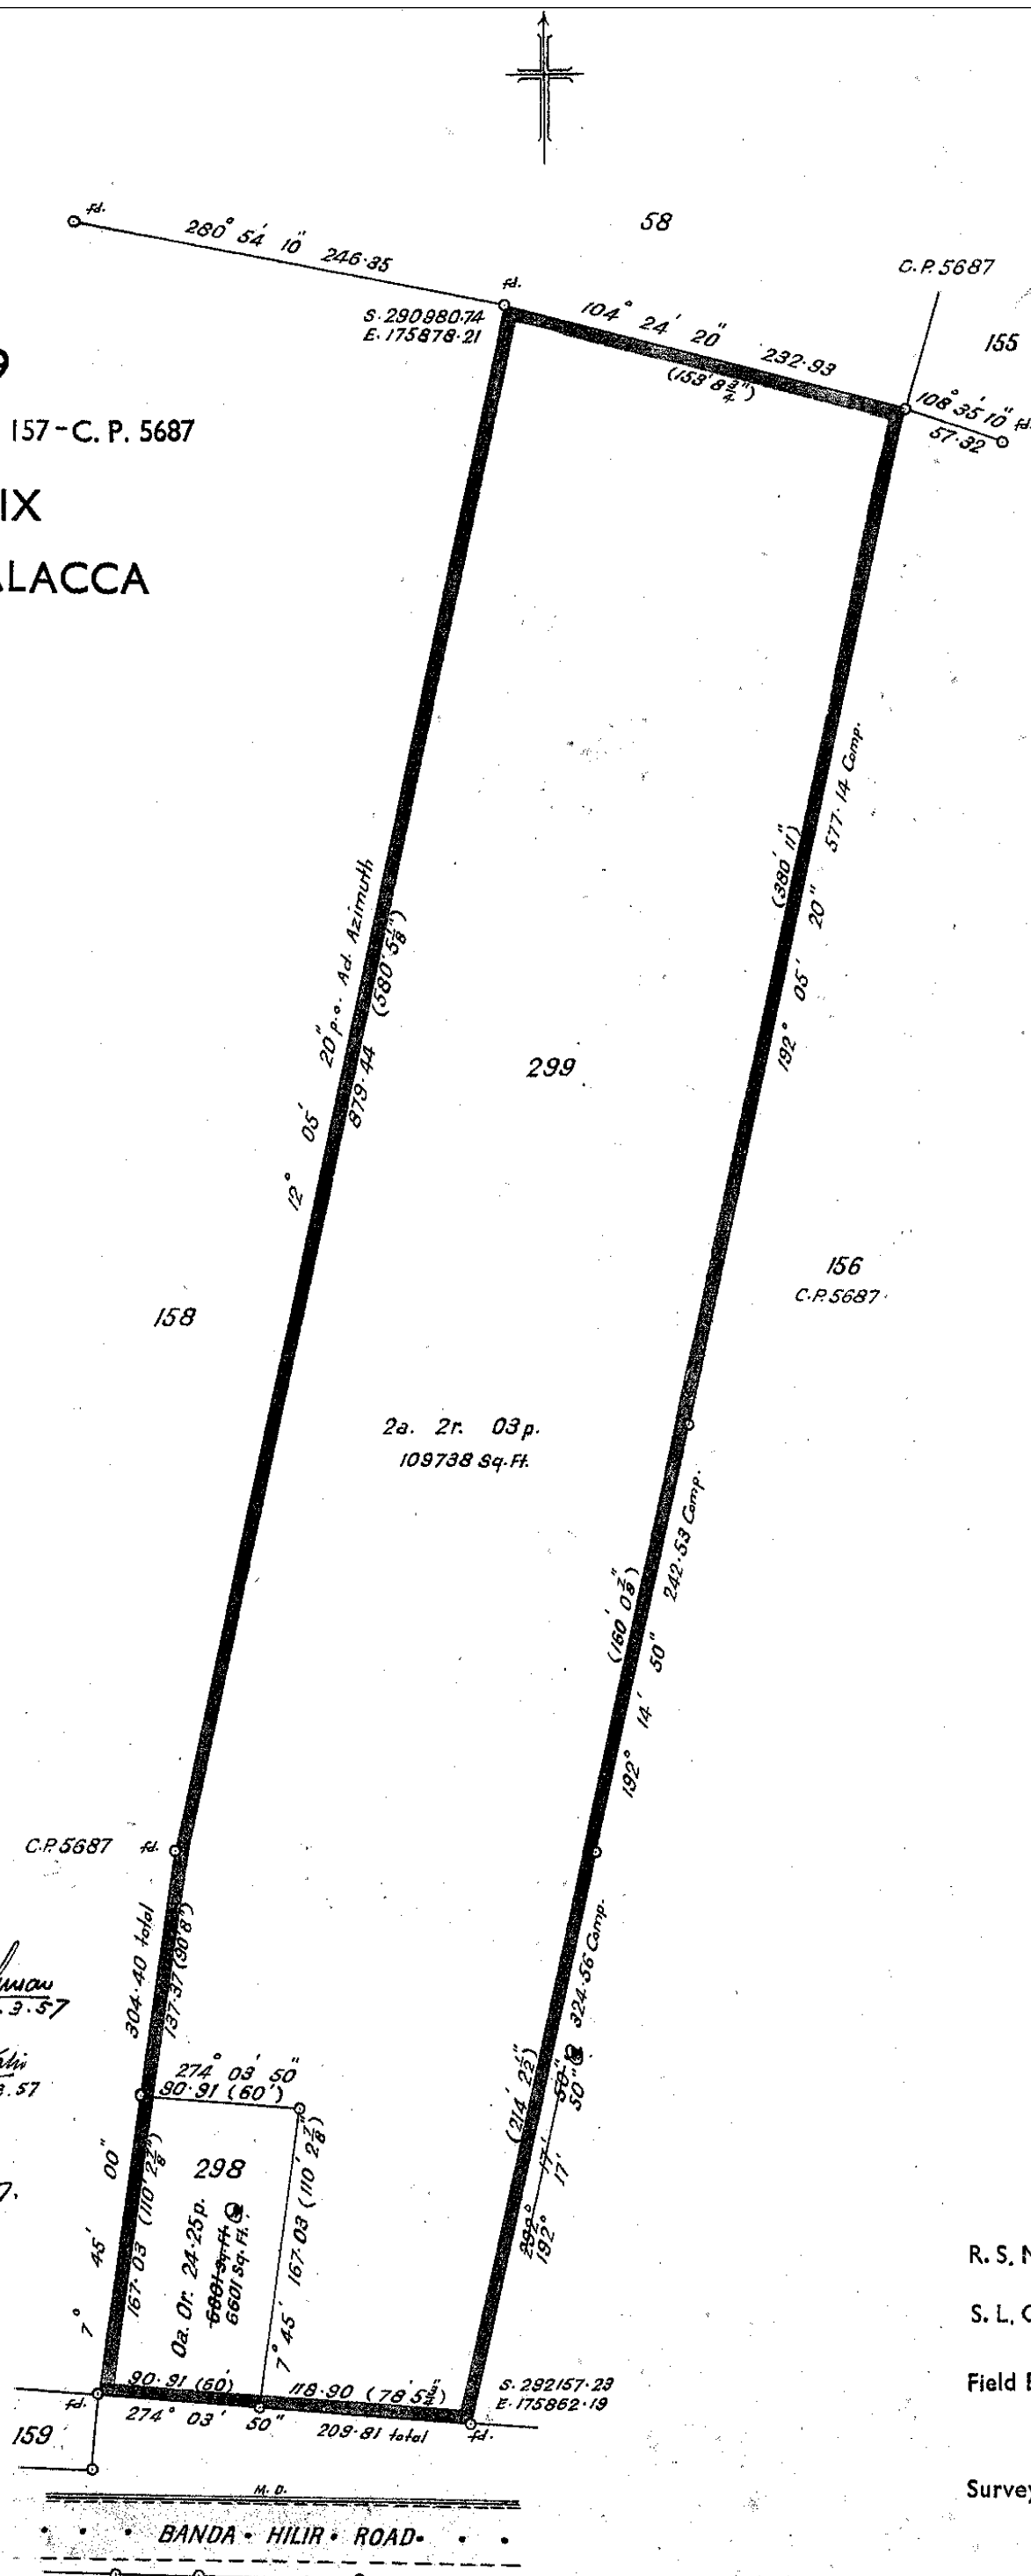

First Class Survey

Drawn & Charted by *R. S. M.*
14.3.57

Examined by *A. Rudra Deva*
20.3.57

Approved by *A. Rudra Deva*
21.3.57

R. S. M. 46-57

S. L. O. (M.) 620

Field Book 4052 pages 17 to 22

Surveyed by A. Rudra Deva
5. 3. 57