
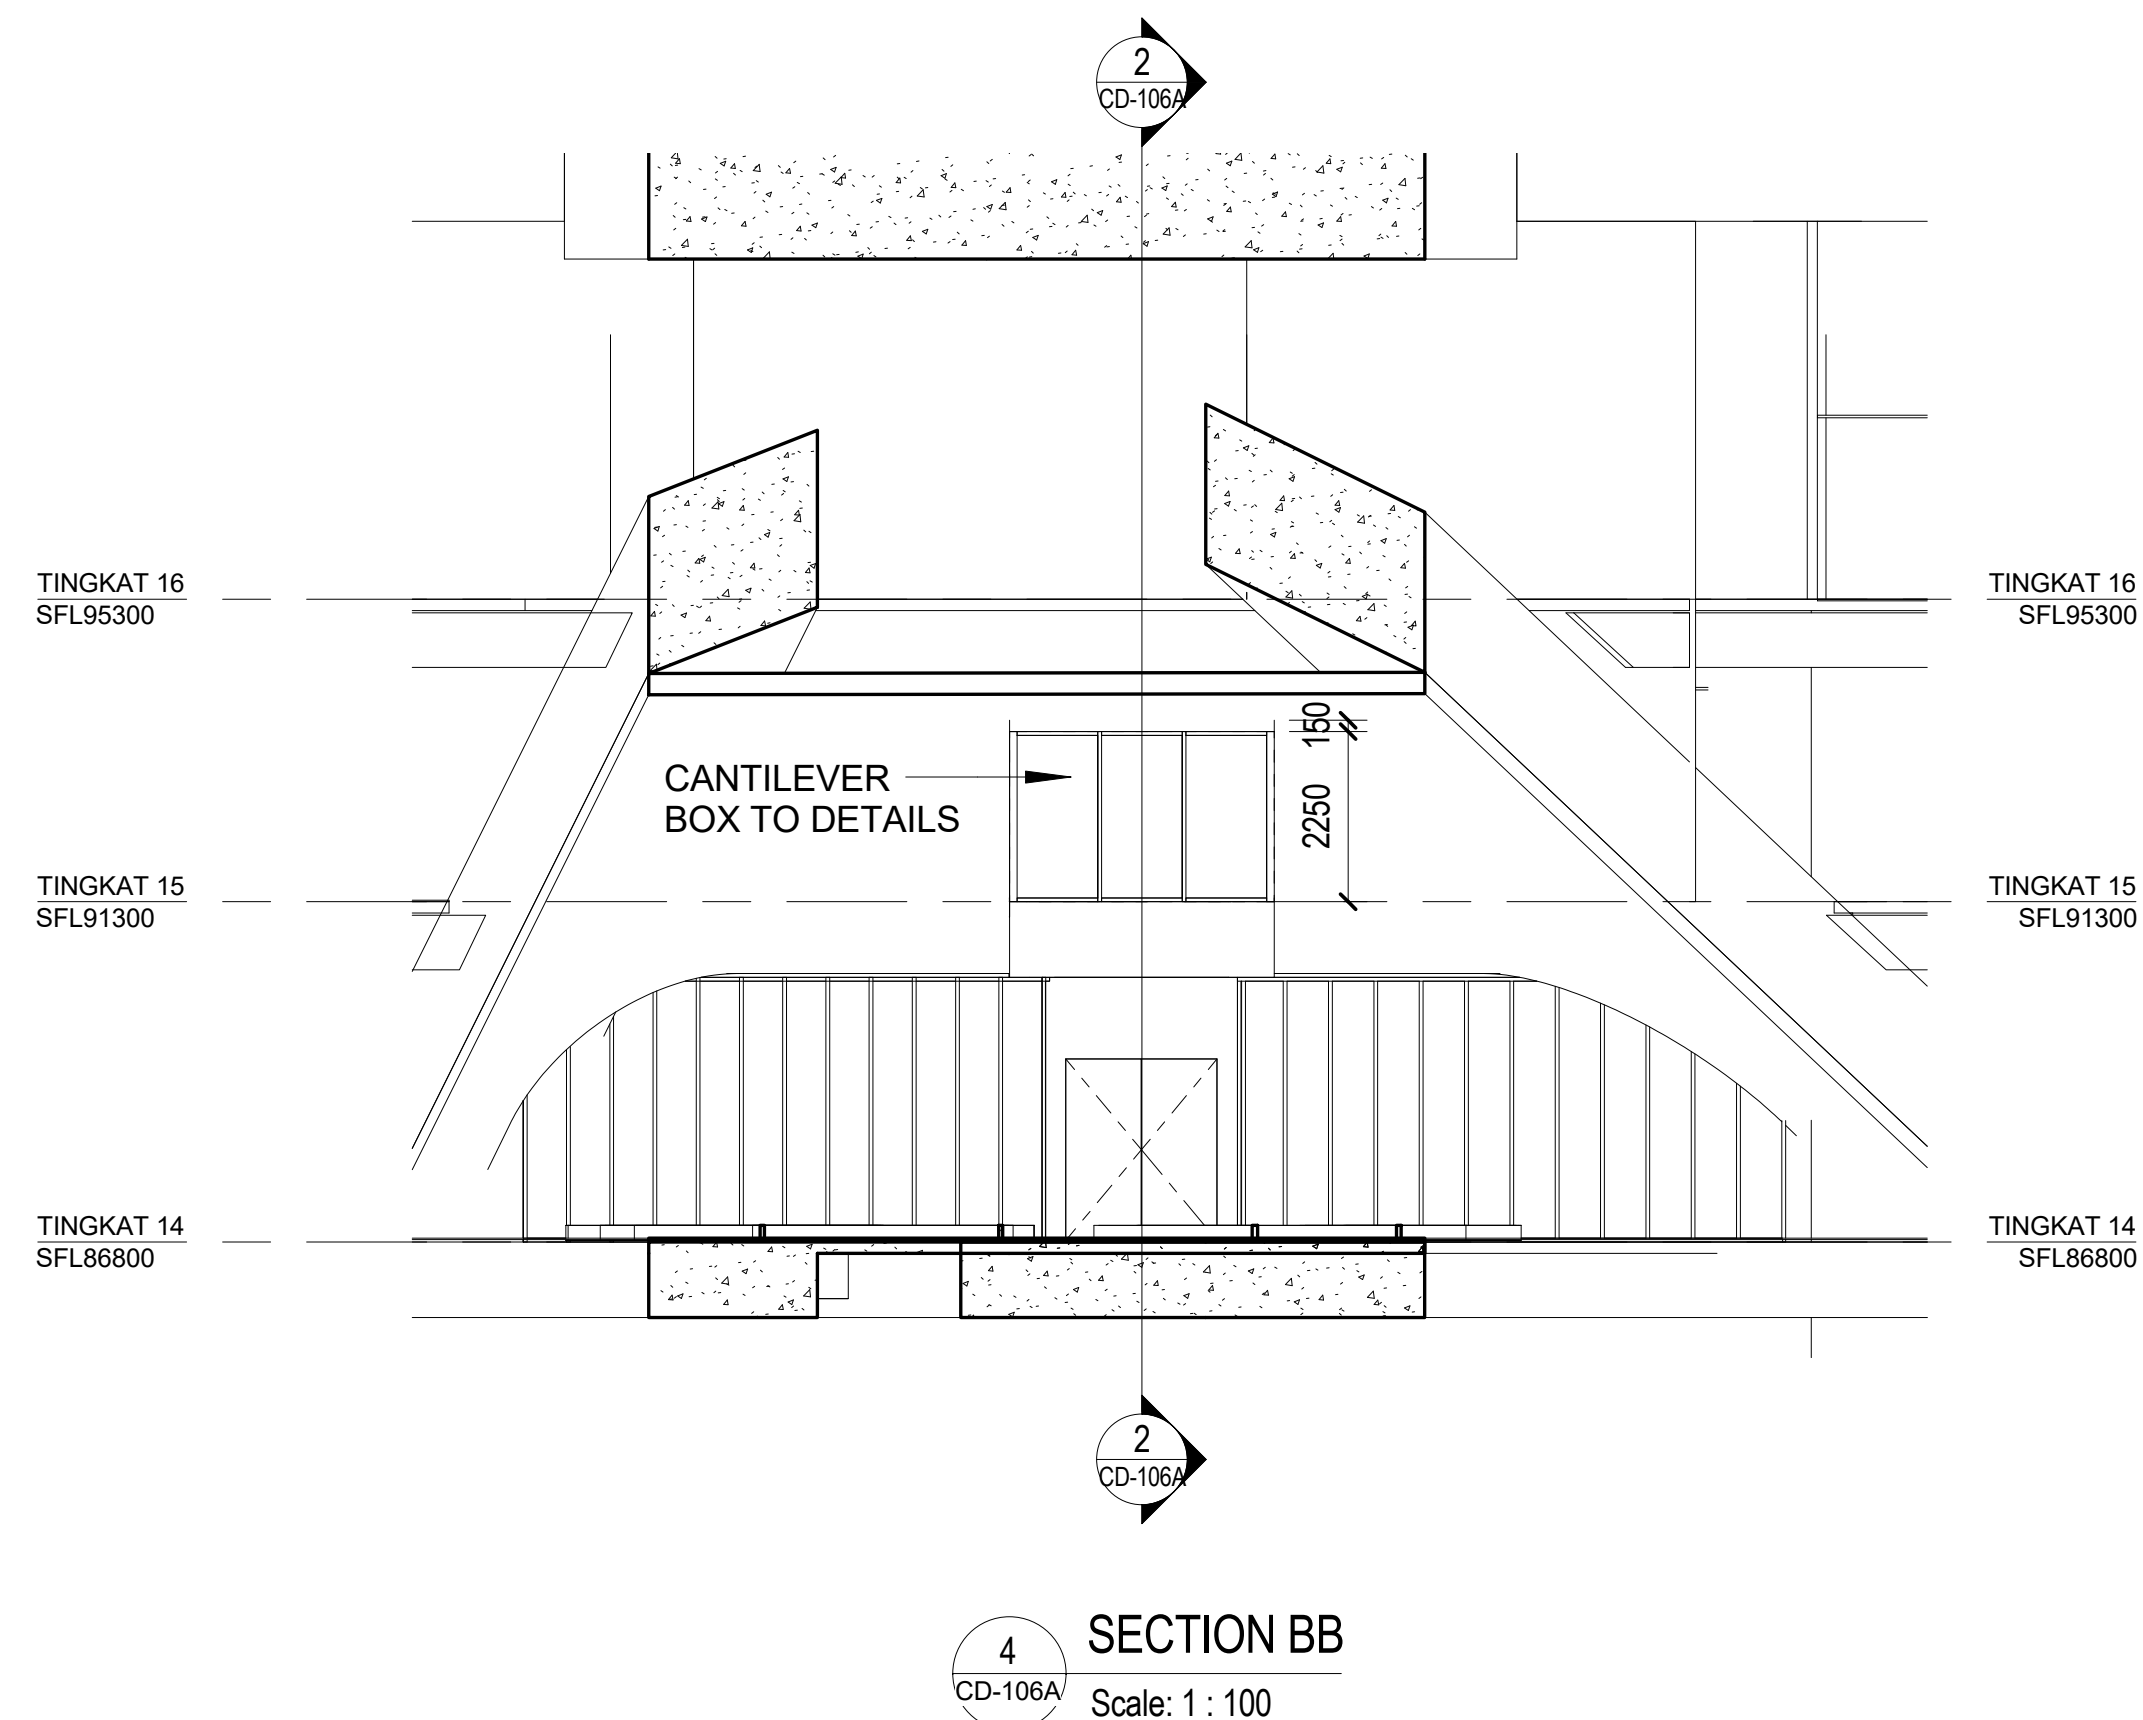
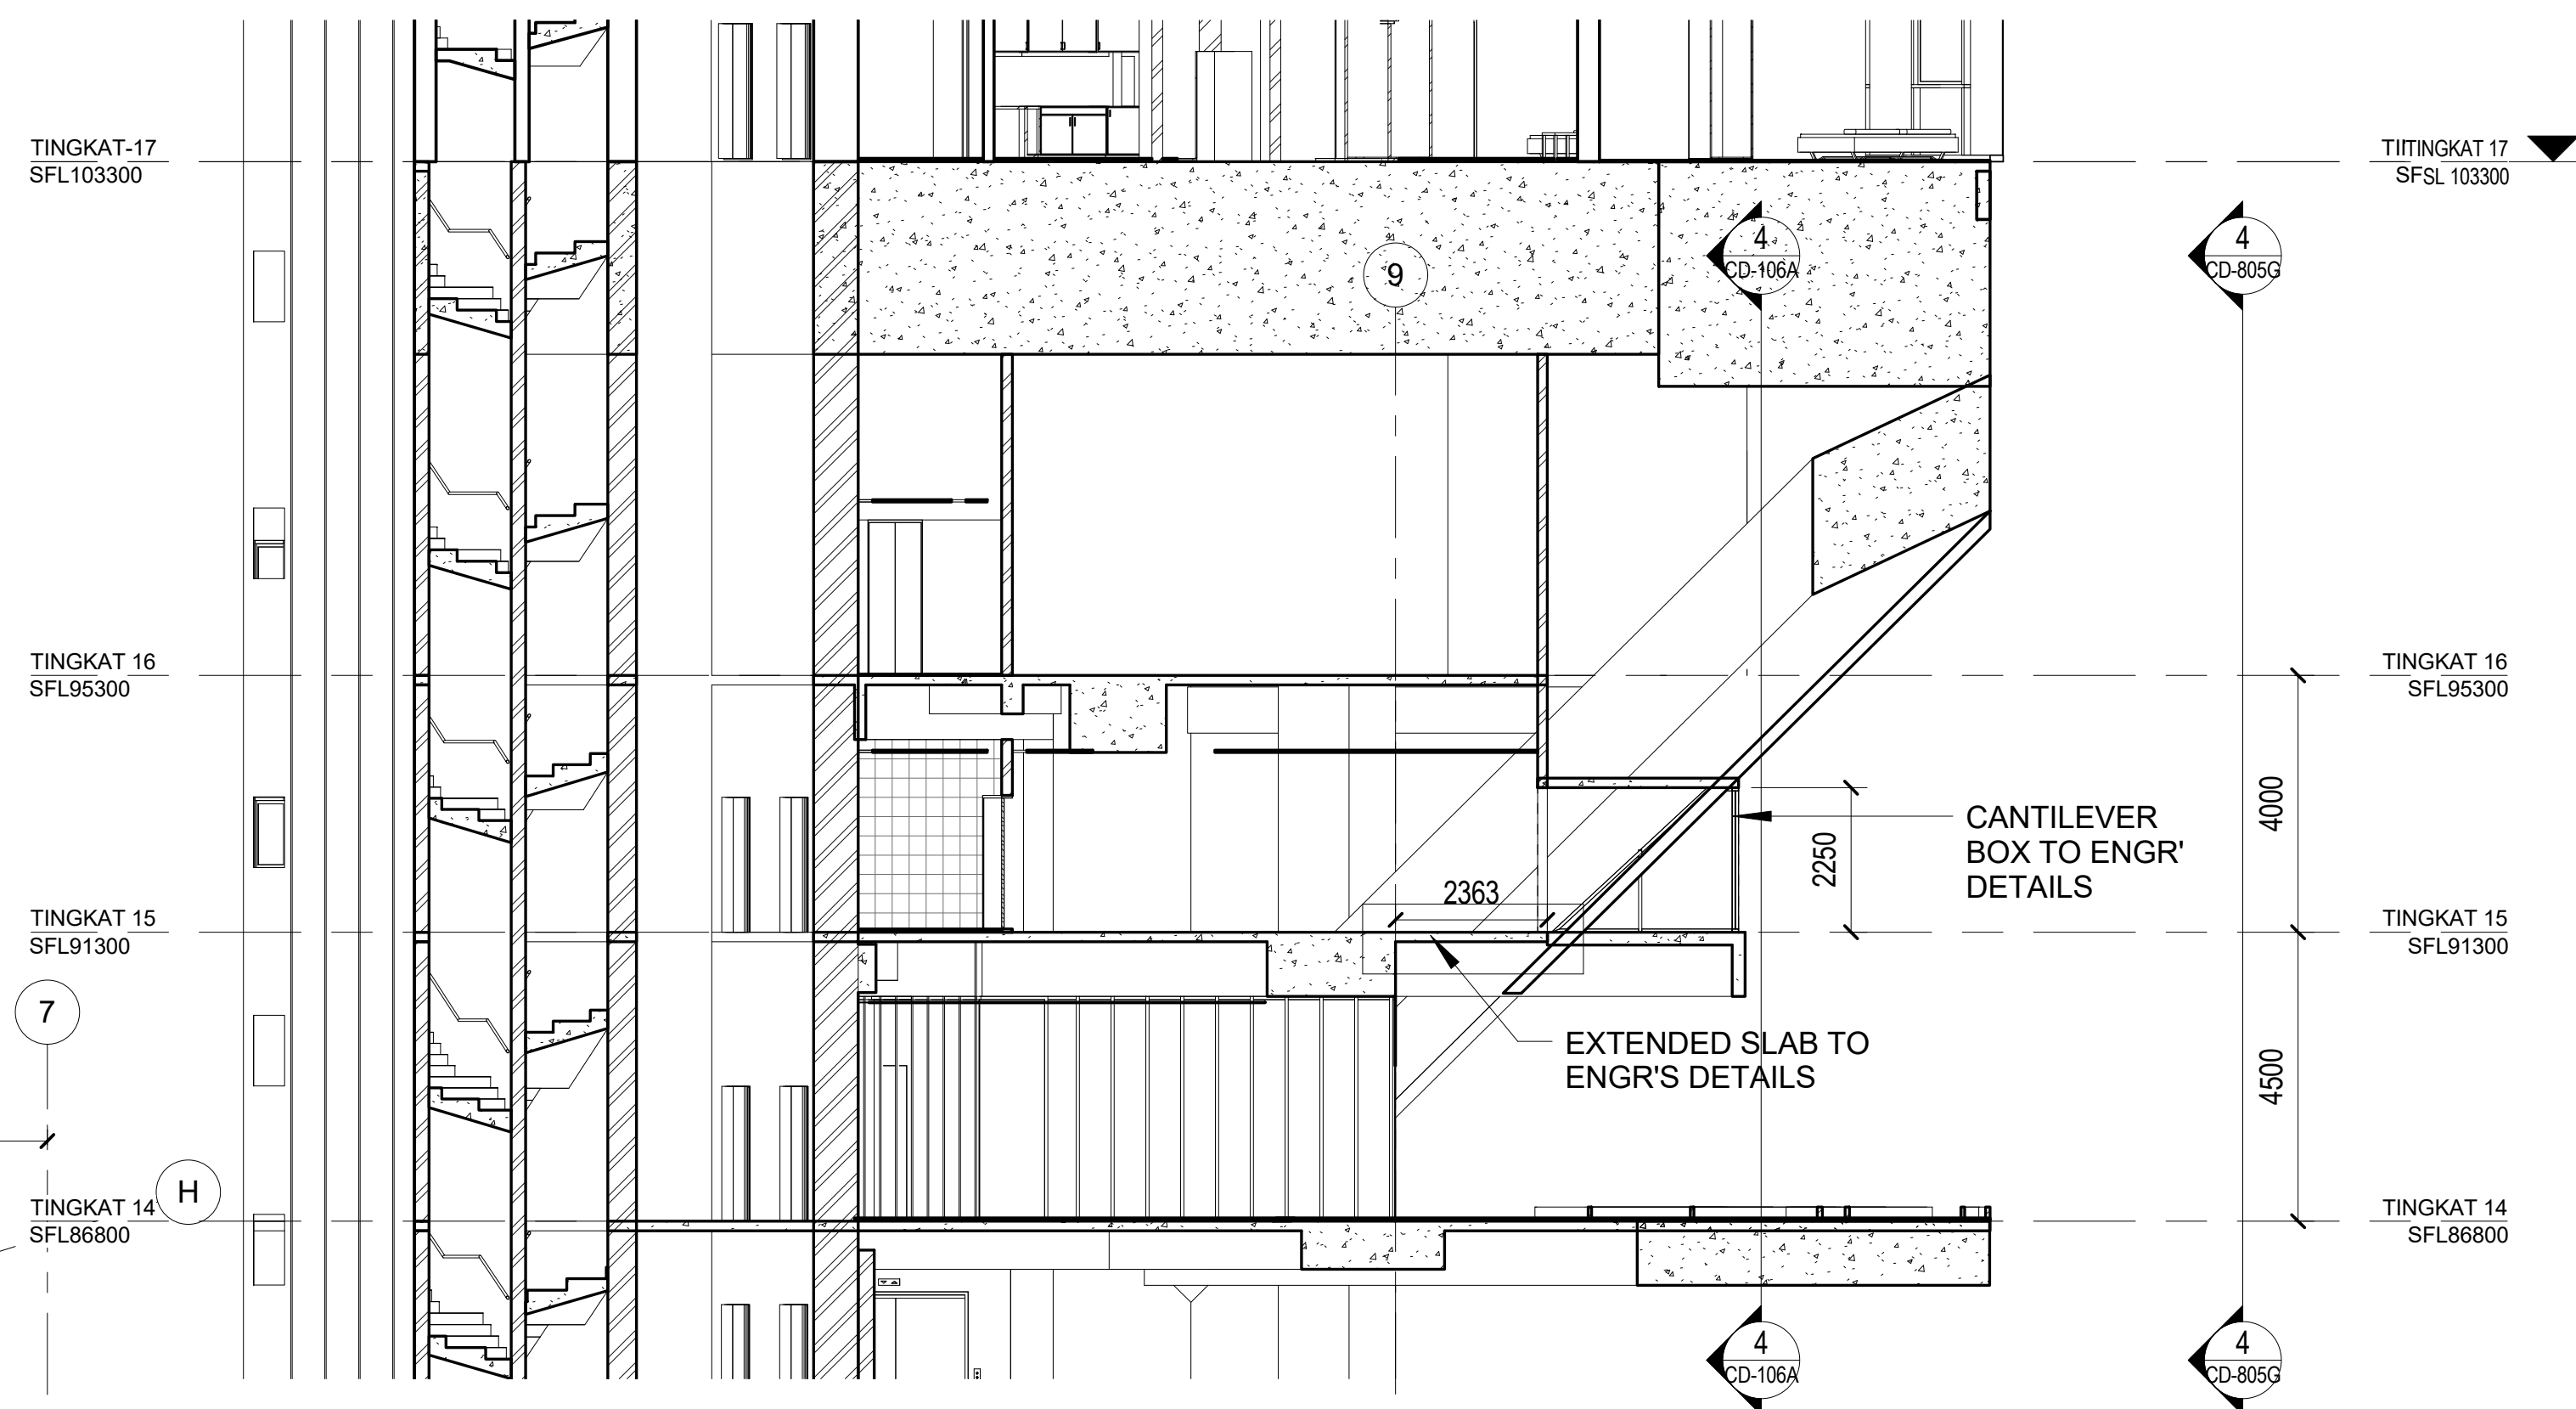


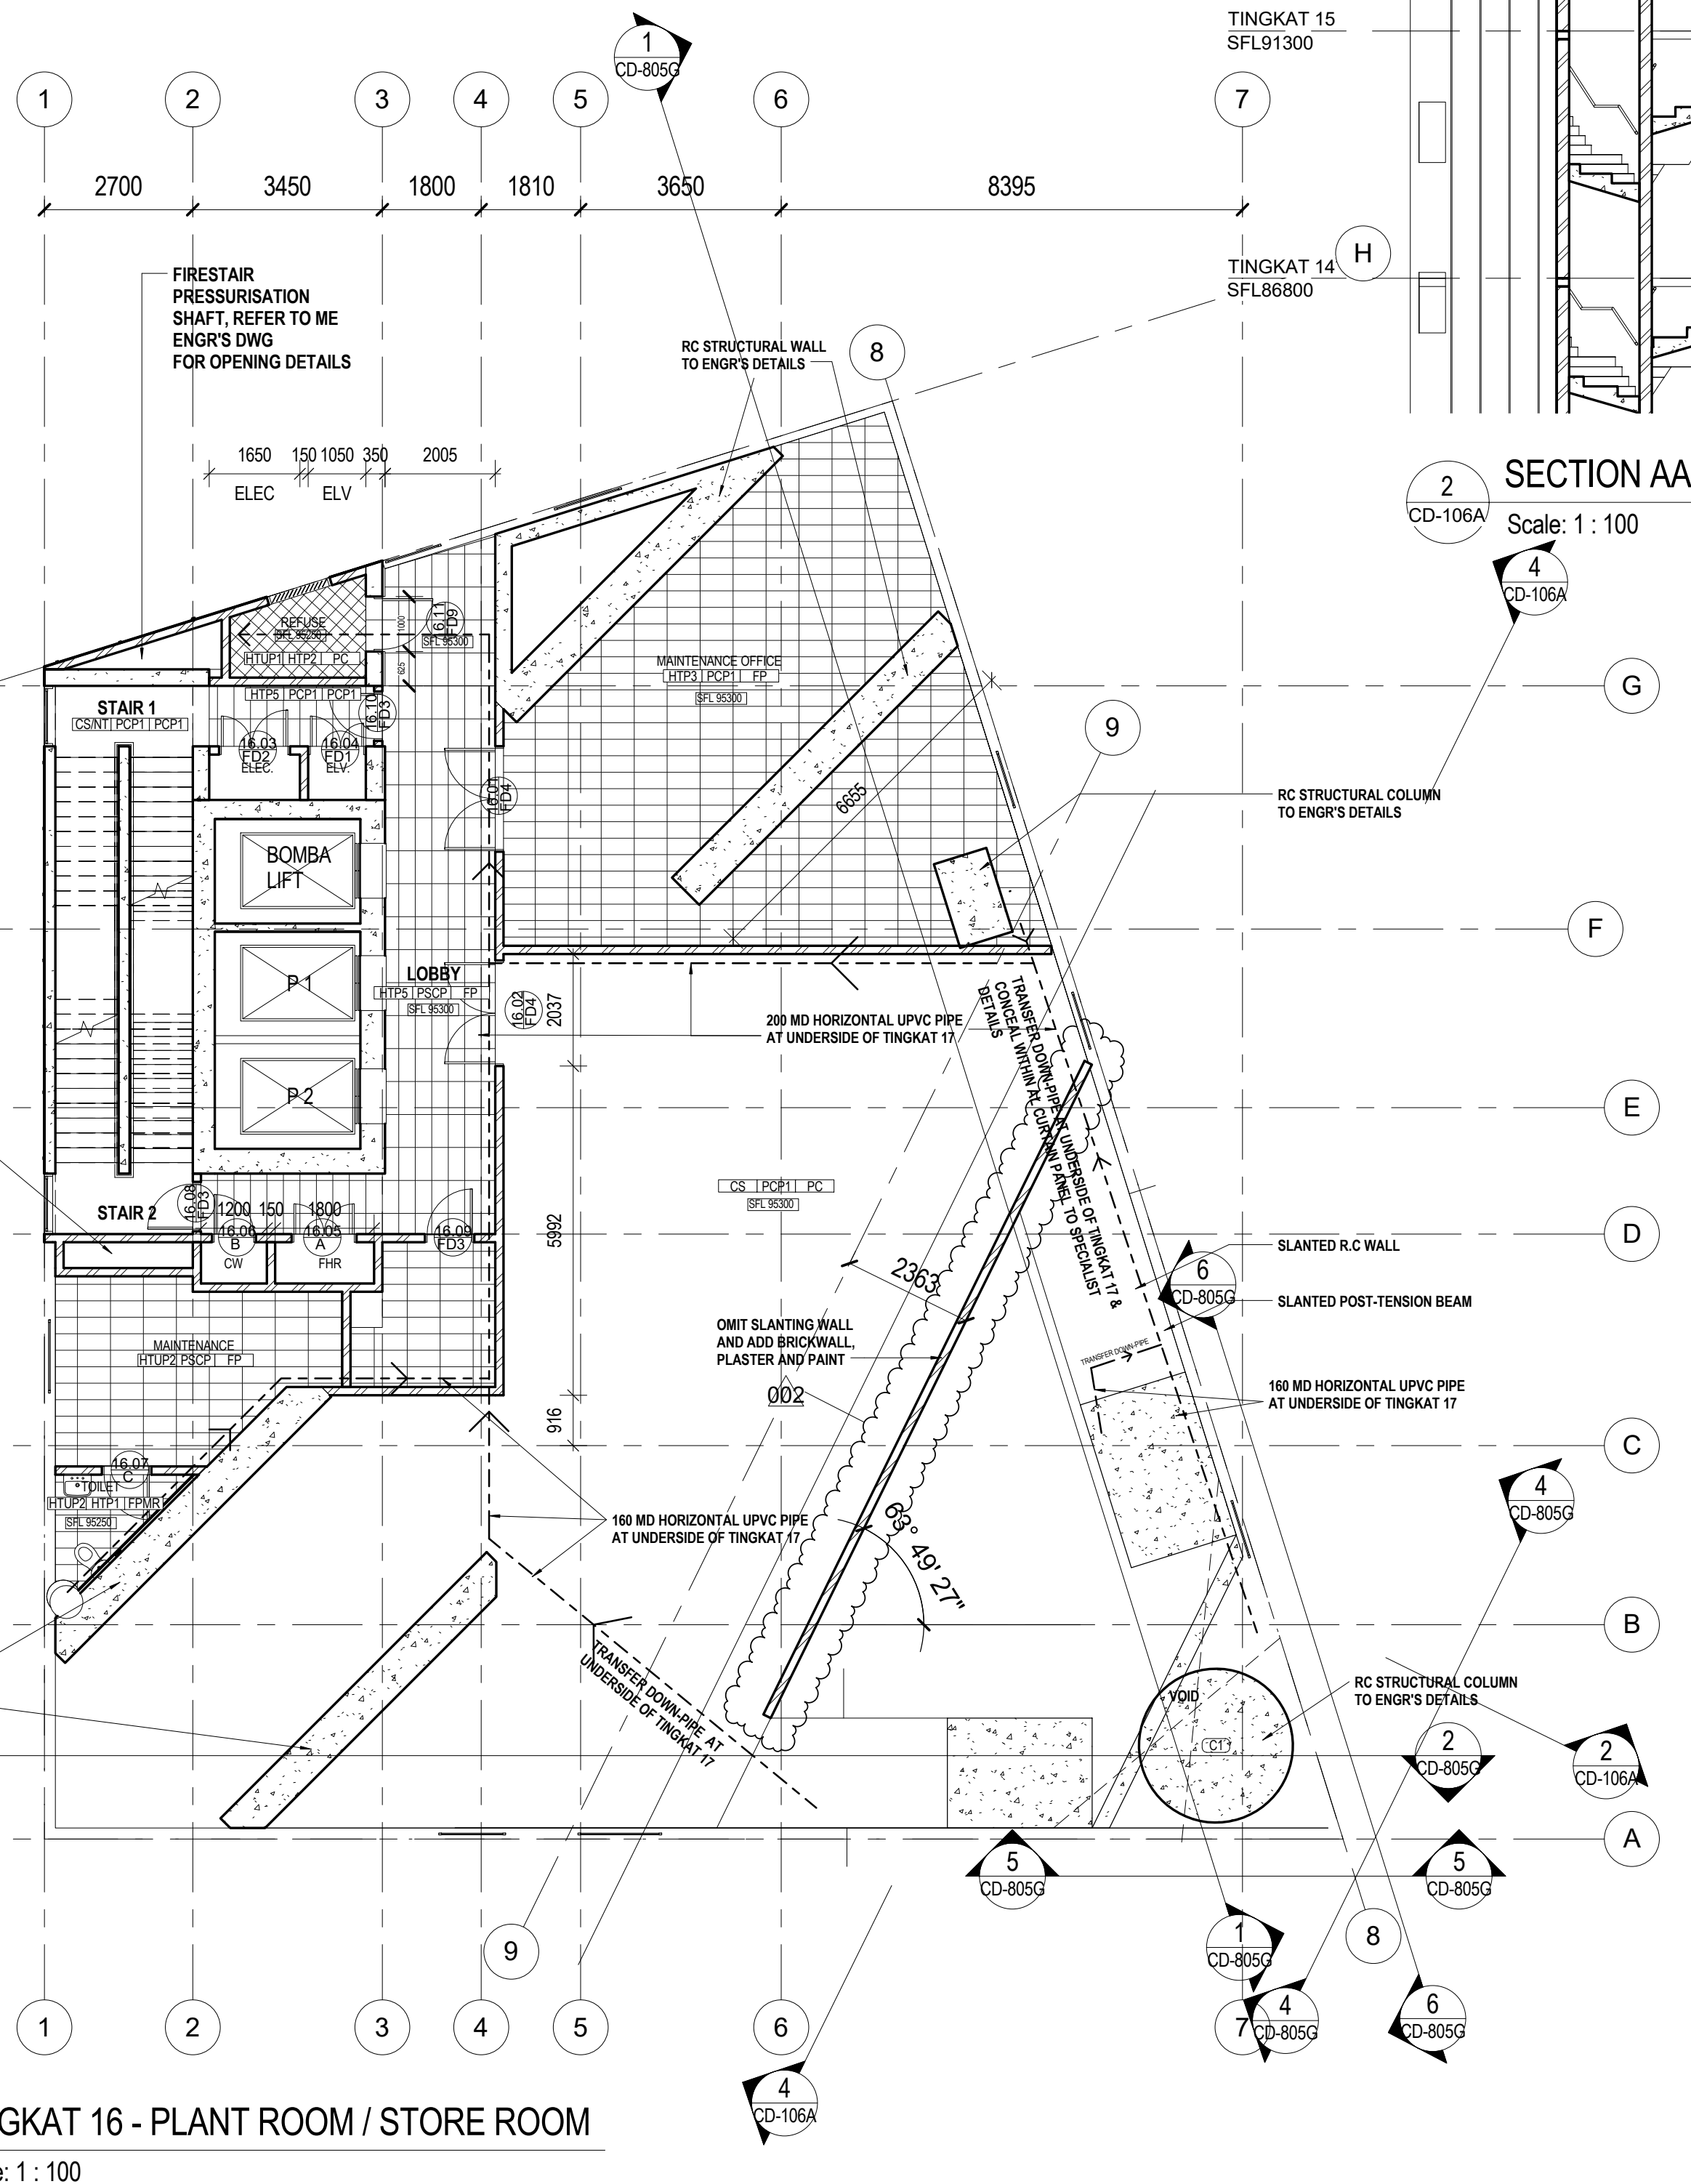

NOTES:-

THESE DRAWINGS ARE TO BE READ IN CONJUNCTION WITH THE GENERAL SCHEDULE OF FINISHES & SPECIFICATIONS AS CONTAINED IN THE CONTRACT DOCUMENTS:-

DO NOT SCALE DRAWINGS AND SETTING OUT OF CONSTRUCTION WORKS MUST BE BASED ON HARDCOPY AND NOT BASED ON DIGITAL DRAWINGS SUCH AS AUTOCAD. REPORT ANY DRAWING DISCREPANCIES CONTAINED HEREIN INCLUSIVE OF ALL INTER-RELATED CONSULTANTS' DRAWINGS TO ARCHITECT FOR FINAL CONFIRMATION.

REFER M&E ENGINEER'S DRAWINGS FOR ALL OPENING SIZES AND SETTING OUT DETAILS.

REFER TO INTERIOR DESIGNER DRAWINGS FOR ALL INTERIOR FINISHES
AND SPECIFICATIONS, FITTING AND FIXTURES AND ALL SETTING OUT
DETAILS

Rev.	Description	Date
001	Issued for construction	MAY 2019
002	OMIT INTERNAL SLOPE WALL AND ADD BRICKWALL	6/11/2020

CONSTRUCTION DRAWING

PROJECT TITLE
CADANGAN PEMBANGUNAN 1 BLOK
PANGSAPURI SERVIS 40 TINGKAT (90 UNIT)
YANG MENGANDUNGI:-

- I. 1 TINGKAT BASMEN
- II. 2 TINGKAT RUANG KOMERSIAL
- III. 12 TINGKAT PODIUM TEMPAT LETAK KERETA SERTA LIF KERETA
- IV. 2 TINGKAT KEMUDAHAN KELAB SERTA MID-LEVEL TERRACE
- V. 23 TINGKAT PANGSAPURI SERVIS
- VI. 1 TINGKAT KEMUDAHAN SERTA SKY GARDEN

DI ATAS LOT 621 (PT 203), SEKSYEN 67,
BANDAR KUALA LUMPUR, WILAYAH
PERSEKUTUAN UNTUK TETUAN
FOREBASE PROPERTY S/B

PEMILIK:
FOREBASE PROPERTY SDN BHD

A-38-3A, S.O.H.O @ KLCC
Jalan Perak,
Kuala Lumpur 50450
Malaysia
Tel:03- 21812595

ASSOCIATE:
PARTICULAR PTE LTD
Suite 912
365 Little Collins Street
3000 Melbourne
T: +61 3 9942 3082

ARKITEK:

ARKITEK
S M TEO

DRAWING TITLE

TINGKAT 16 AMENDED PLAN

DRAWING NO. CD-106A	DATE: OCT 2020	ISSUE 002
	SCALE: 1:100 @A1	

FILE: D:\1 CURRENT\0-LOT 620 &
621\1-SUPERSTRUCTURE-HBDJ\1-SUPERSTRUCTURE CONSTRUCTION
DWG\01-REVIT CONSTRUCTION DWG-2 NOV 2020\190517-HEMMON
CONSTRUCTION.M