
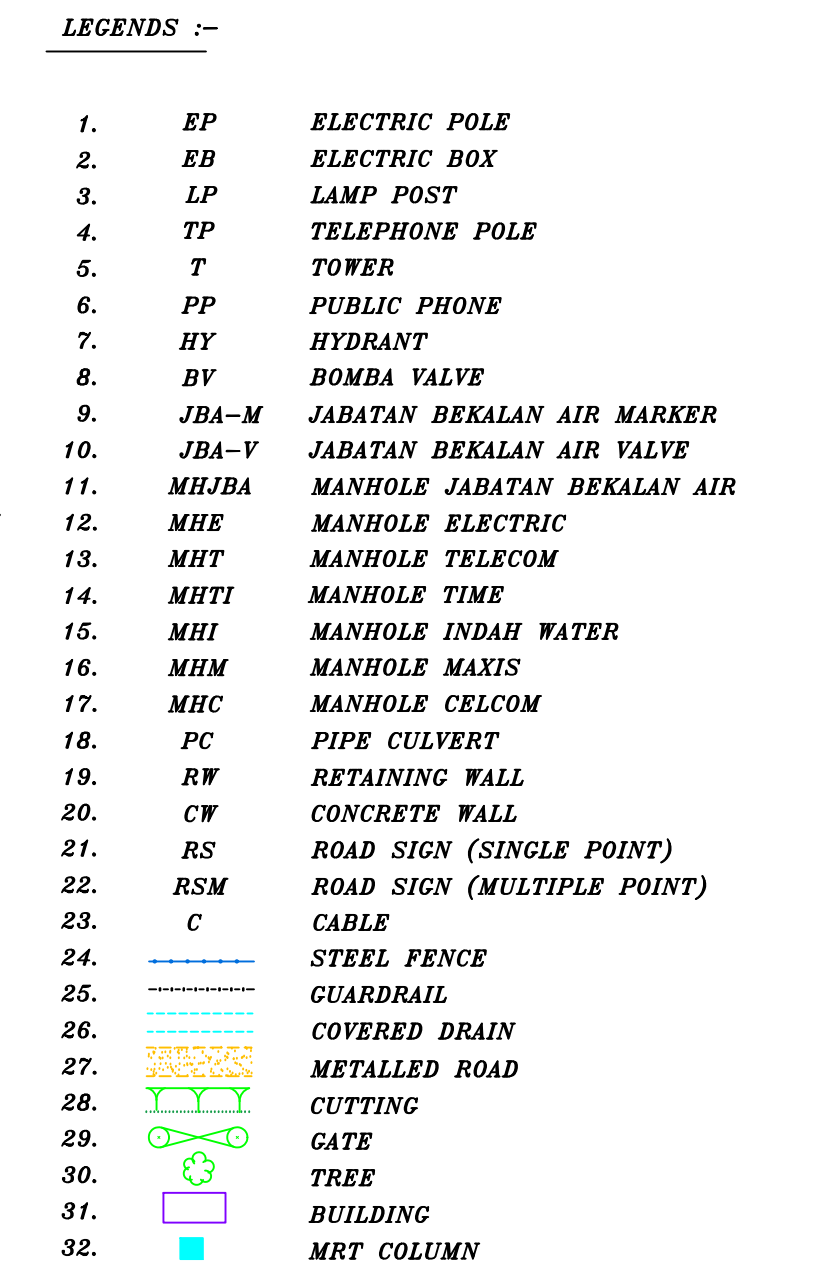


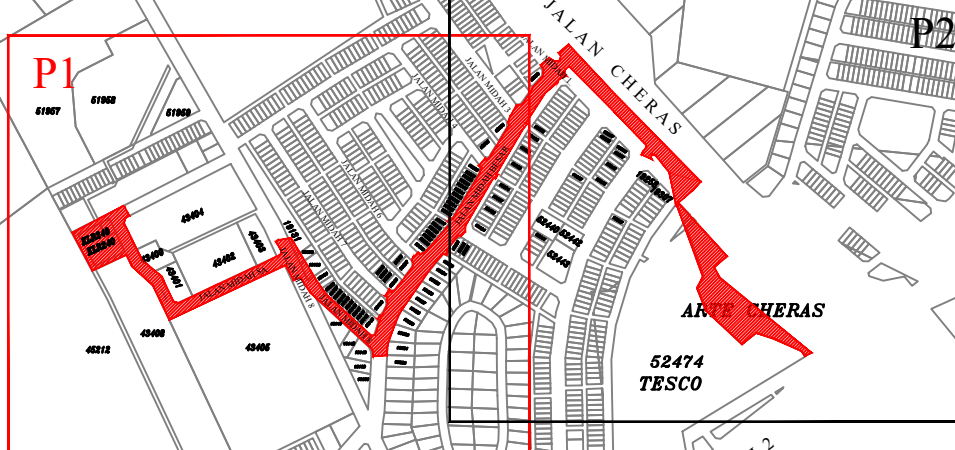

NOTE :-


1. ALL MEASUREMENTS ARE IN METRES.
2. ALL LEVELS ARE BASED ON BM W 0131 (RL=89.981m)
"Di kiri Jalan Kuari - Jalan Cheras. Di dalam kawasan pagar Madrasah Islamiah Cheras Baru, Kuala Lumpur"
3. DERIVED FROM DRAWING PUT/W3381a/17/DT/P1.

<i>SURVEYED BY :</i>	<i>FOO FEB.2021</i>
<i>DRAWN BY :</i>	<i>IRA FEB.2021</i>
<i>CHECKED BY :</i>	<i>VINCENT</i>
<i>LICENSED LAND SURVEYOR :</i>	

Sr. LAU WEI SENG
B. GEOMATICS (MELB) HONS, R.I.S.M (M)
Juruter Tanah Yang Dilesein Di Bawah Akta 458
PERUNDING UKUR TEKUN
 20-2, JALAN PJU 5/15
 DATARAN SUNWAY
 KOTA DAMANSARA
 47810 PETALING JAYA
 Tel : 03-61579988 Fax : 03-61572145 E-mail : main@put.com.my

PLAN NO : PUT/W4170/2021/DT/P1



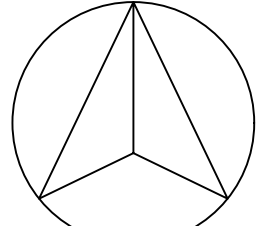

SCALE 1 : 1000
STD. SHEET : 94-A

PROJECT :

DETAIL AND LEVELLING
SURVEY AT JALAN CHERAS,
JALAN MIDAH BESAR, JALAN
MIDAH 9, JALAN MIDAH 8A
AND KLR 240 SEWAGE
TREATMENT PLANT, KUALA
LUMPUR,

LEGENDS :-

1.	EP	ELECTRIC POLE
2.	EB	ELECTRIC BOX
3.	LP	LAMP POST
4.	TP	TELEPHONE POLE
5.	T	TOWER
6.	PP	PUBLIC PHONE
7.	HY	HYDRANT
8.	BV	BOMBA VALVE
9.	JBA-M	JABATAN BEKALAN AIR MARKER
10.	JBA-V	JABATAN BEKALAN AIR VALVE
11.	MHJBA	MANHOLE JABATAN BEKALAN AIR
12.	MHE	MANHOLE ELECTRIC
13.	MHT	MANHOLE TELECOM
14.	MHTI	MANHOLE TIME
15.	MHI	MANHOLE INDAH WATER
16.	MHM	MANHOLE MAXIS
17.	MHC	MANHOLE CELCOM
18.	PC	PIPE CULVERT
19.	RW	RETAINING WALL
20.	CW	CONCRETE WALL
21.	RS	ROAD SIGN (SINGLE POINT)
22.	RSM	ROAD SIGN (MULTIPLE POINT)
23.	C	CABLE
24.		STEEL FENCE
25.		GUARDRAIL
26.		COVERED DRAIN
27.		METALLED ROAD
28.		CUTTING
29.		GATE
30.		TREE
31.		BUILDING
32.		MRT COLUMN

NOTE :-

- ALL MEASUREMENTS ARE IN METRES.
- ALL LEVELS ARE BASED ON BM W 0131 (RL=89.981m)
"Di kiri Jalan Kuari - Jalan Cheras. Di dalam kawasan pagar Madrasah Islamiah Cheras Baru, Kuala Lumpur"
- DERIVED FROM DRAWING PUT/W3381a/17/DT/P1.

SURVEYED BY : FOO FEB.2021

DRAWN BY : IRA FEB.2021

CHECKED BY : VINCENT

LICENSED LAND SURVEYOR :

ST. LAU WEI SENG
B. GEOMATICS (MRLB) HONS, R.L.S.M (M)
Jurukur Tanah Yang Dilemah Di bawah Akta 468
PERUNDING UKUR TEKUN
20-2, JALAN PUJ 5/15
DATARAN SUNWAY
KOTA DAMANSARA
47810 PETALING JAYA
Tel : 03-61579888 Fax : 03-61572145 E-mail : main@put.com.my

PLAN NO : PUT/W4170/2021/DT/P2