


No. Fail

Rajah di muka

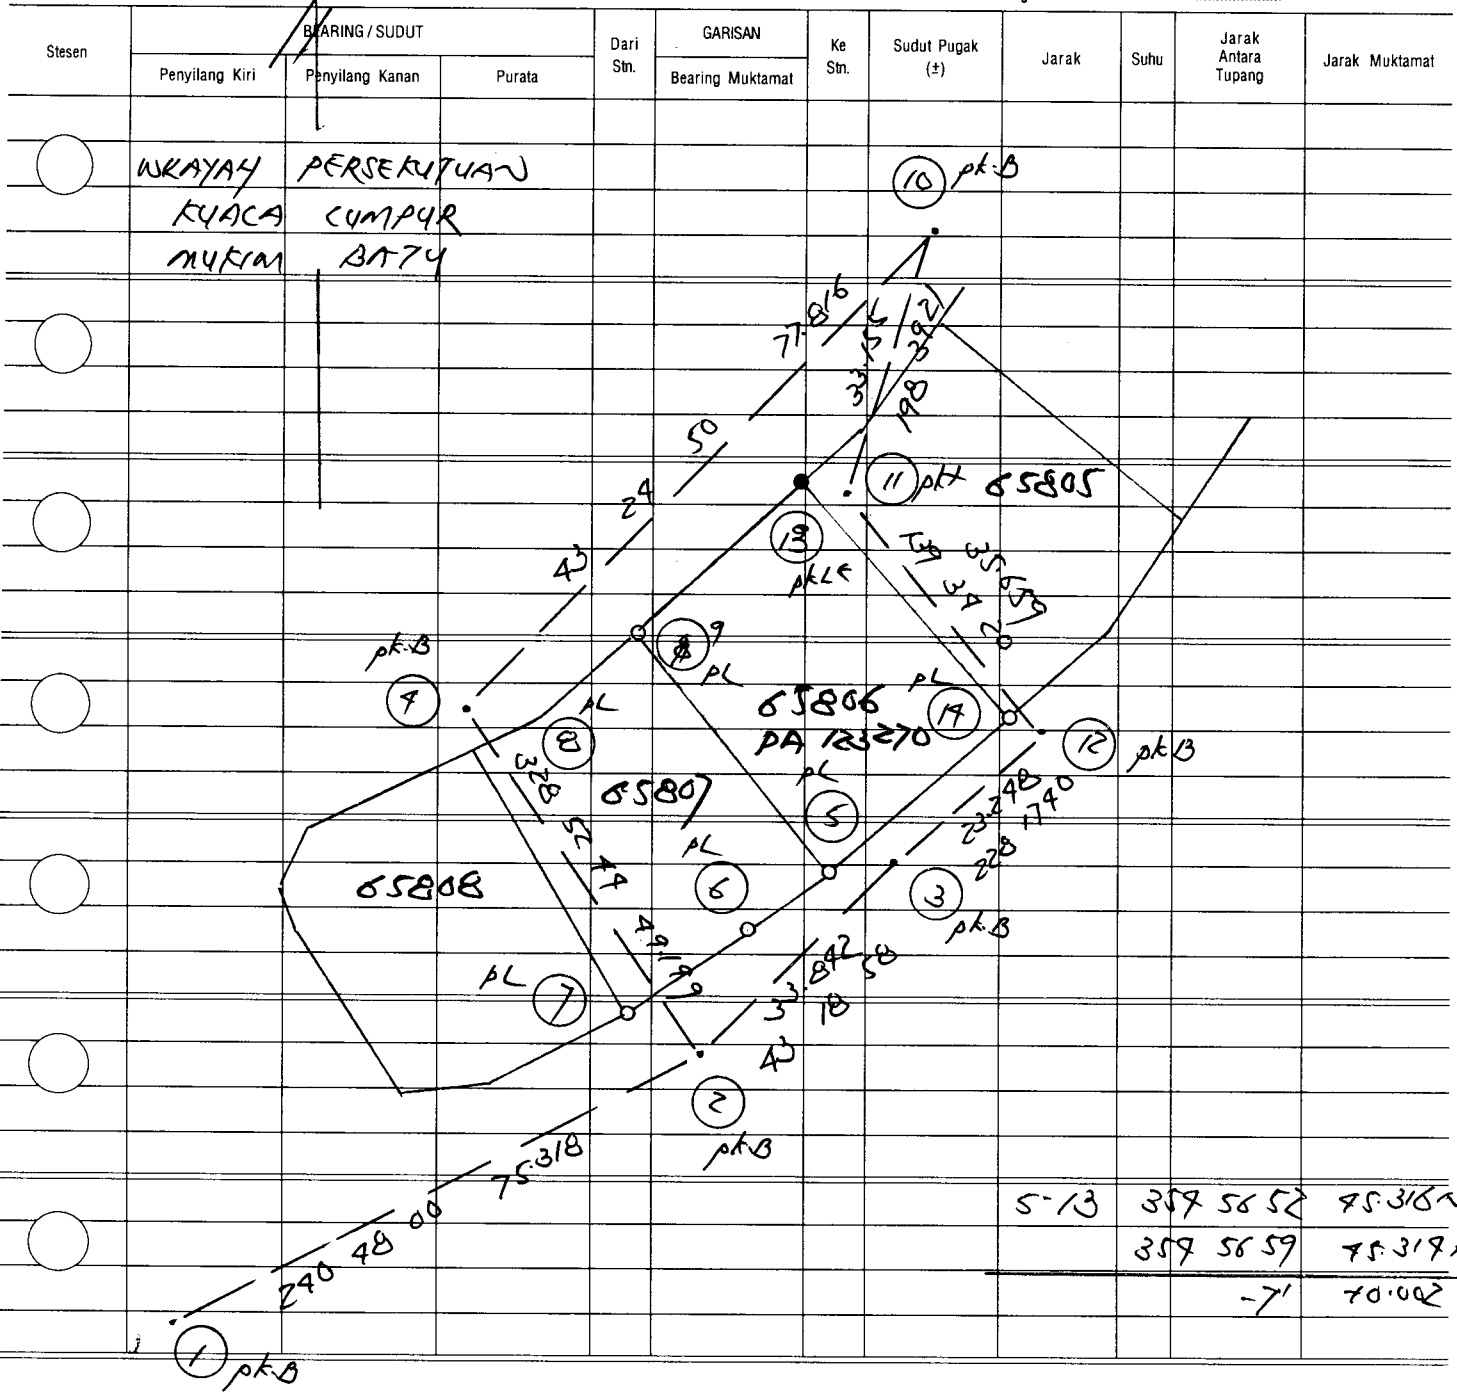

Tarikh Aras

Dibuat untuk

51

Daripada JM 1921 CM

Ke

Pandangan Belakang	Pandangan Antara	Pandangan Hadapan	Naik	Turun	Aras Yang Dilaras	Jarak	Catitan
0.210 (10.89)					158.522	78M 2808	F1575 (615) ²²⁵
0.257 (10.88)	2.875 (9.83)				155.857	F1003	RC: 166.009-015
0.076 (0.25)	3.321 (10.89)				152.793	6AS	
0.197 (0.98)	3.703 (12.15)				149.166		
2.710 (8.89)	3.867 (12.09)				145.996		
1.921 (9.86)					146.735	F2	
1.220 (9.00)					146.946	F3	
	1.028 (3.37)				147.128	78M 12809 AKJ 88.	Boleka 7701
1.798 (5.90)					53.323	CP 8M	Level on BM W 0088
	1.112 (8.365)				54.009	BM W 0088	Level on CP 8M W 0088
							GPS Level: 53.901m
							BM Level: 53.323m
							+ 0.078
							Level on GPS.
							GPS Level: 152.871m
							+ constant: -0.078
							152.793m