

No. Fail JM 1911 Teluk Gong.

No. Fail

Rajah di muka

[illegible]

2-14 296 42 20 88.857 PB (Re-fix)
 2-15 300 42 43 27.113 BKL (Re-fix)
 2-16 281 55 23 37.681 PB (Re-fix)


8

DAERAH KLANG.

No. Fail

Rajah di muka

MUKIM KLANG.

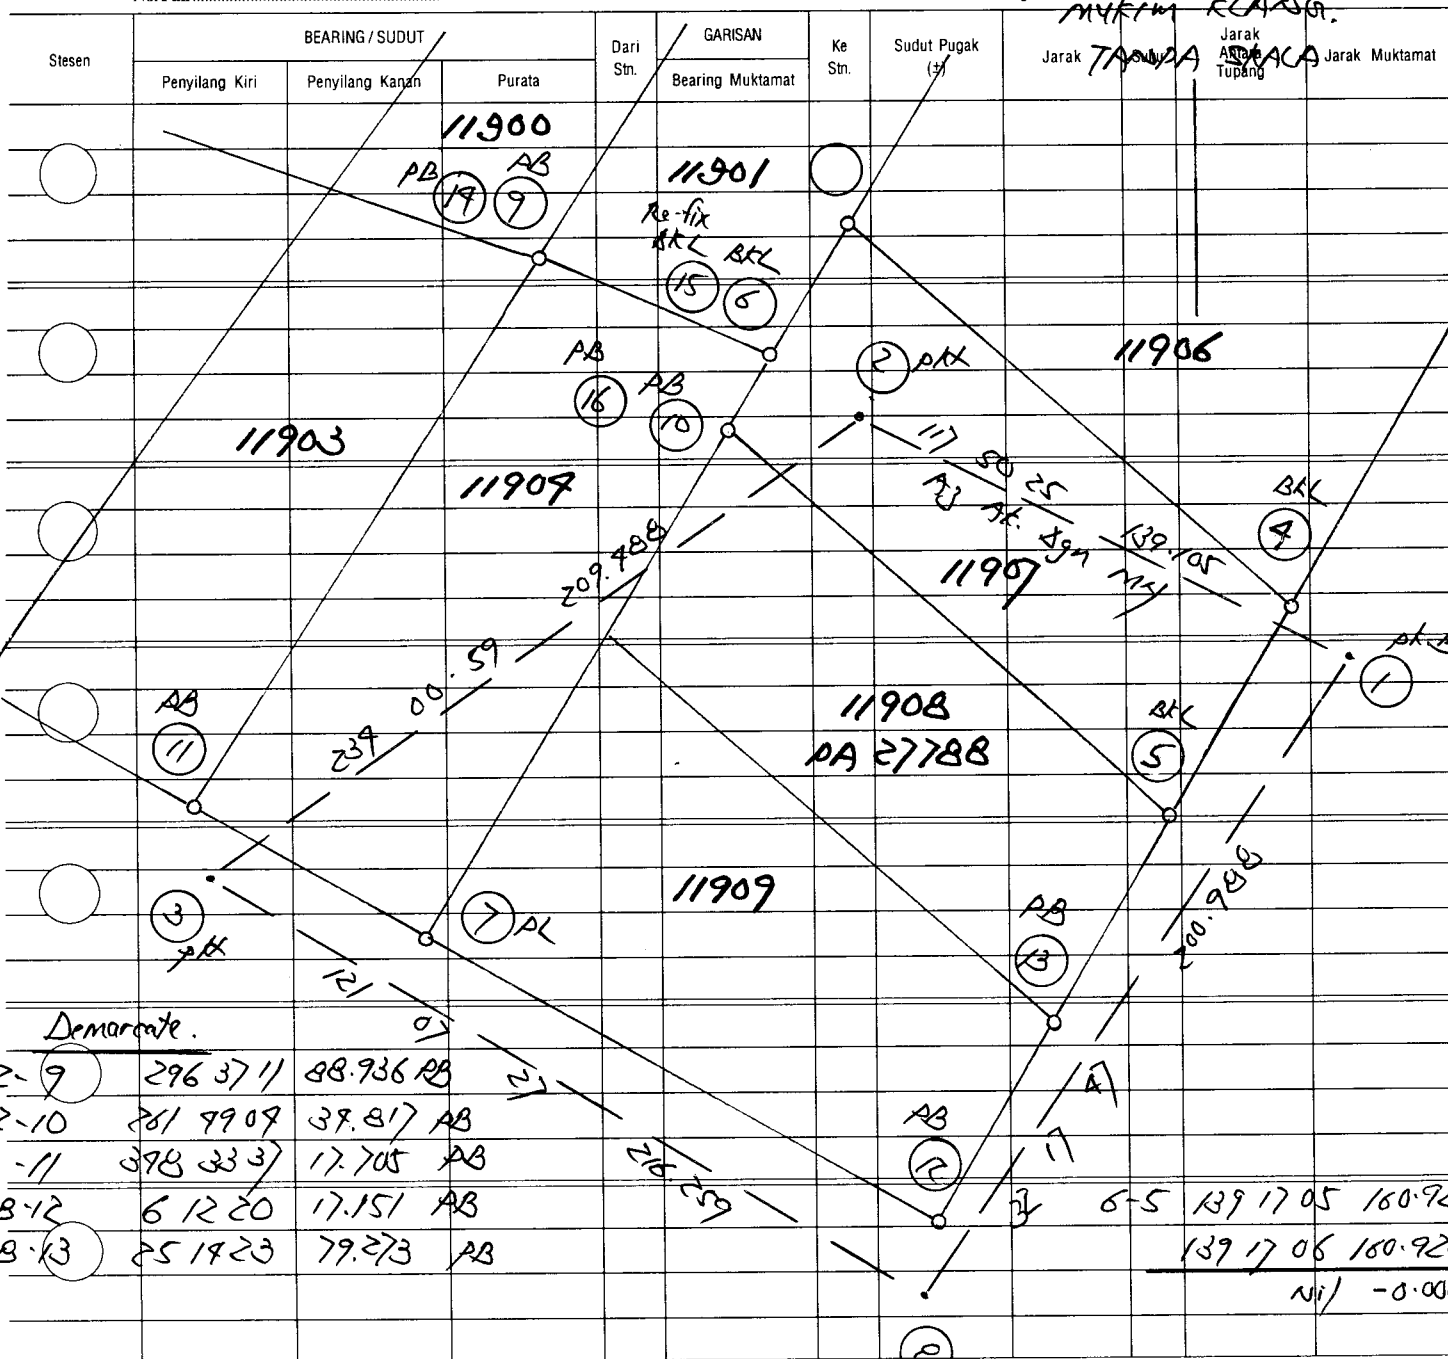

6-7 210 36 39 178.839 N
 210 37 05 178.846 P0
 -28" -0.006