


JN 2329

Wrigley.

Rajadimuka

No. of		Date		Time		Place		Remarks		Remarks	
1		10 09 95		2		10 09 95		1		4	
2		10 09 95		2		10 09 95		1		4	
DAERAH PETALING.
BANDAR SKENMARIE
TANPA SKALA

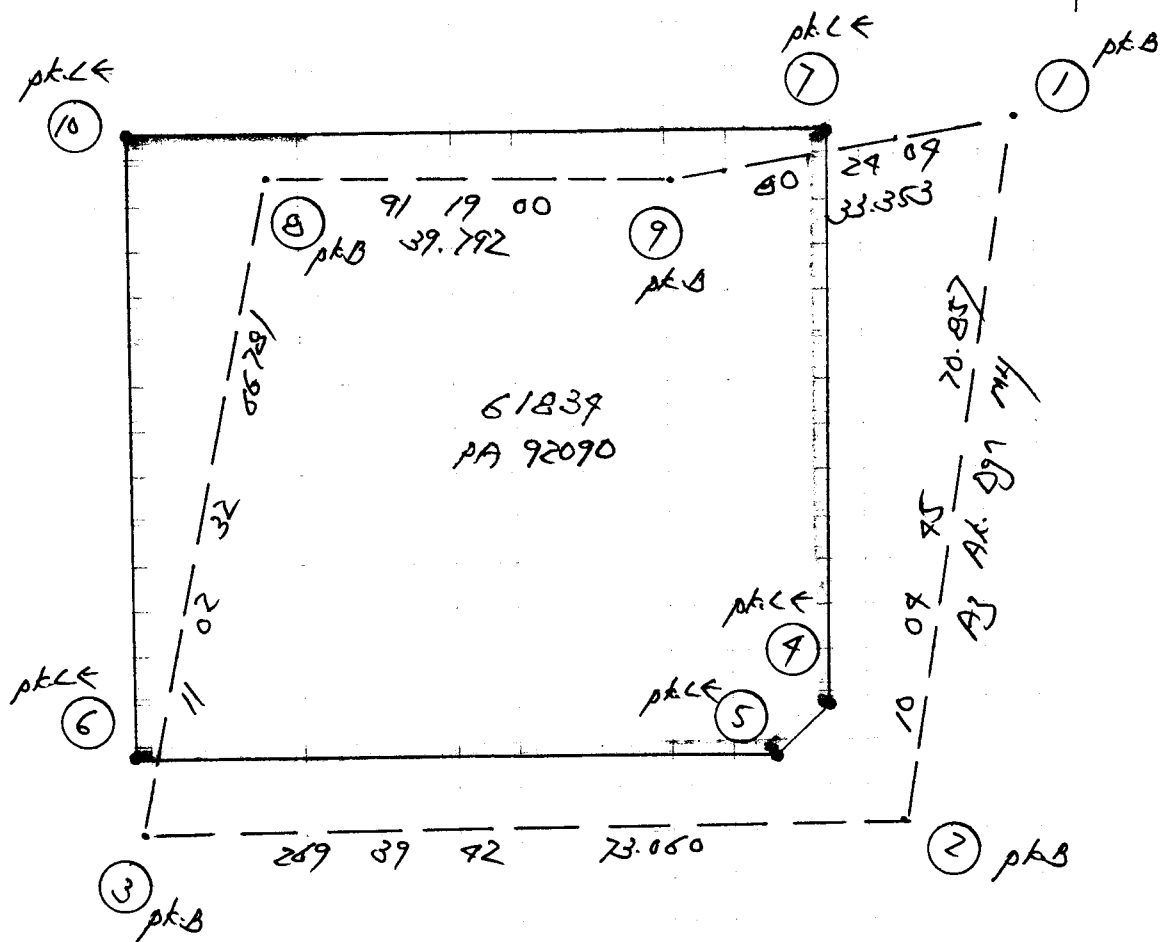

7m 2329

21

Client
Date 7th Nov 1965 Company (M) Sdn Bhd.

Location
Purpose

From	To	RL of Station	Inst. Ht.	Bearing	Vertical Angle + or -	Lower Wire	Middle Wire	Upper Wire	Gen. No.	Horiz. Dist.	Ht. Diff. + or -	RL of Inst.	RL Centre Reading	m	RL Object	Remarks
1.8546	0.3520					23.7120				7.8m 13174						
	1.7880					25.2196				7.8m 13175	1.91					
2.2657	0.8849					29.0786				F2						
2.9608	0.7786					29.8817				9.1						
	1.1956					26.3678				9.2						
						27.6337				9.1						
6.5811	2.6609									9.1						
										9.2						
										9.1						
										9.2						
										9.1						
										9.2						
										9						