

JM 025 Aler Gajah.

No. Fail	Station	Permanently	Temporarily	Remarks	Remarks	Remarks	Remarks
2	Datum Daripada	JM/ 321 09 92	2	H	70.187	40.187	
JM/							
2	321 09 92 191 09 92 68 59 10	JM/ 68 59 10 30	H	87.997	87.997		
JM/							
30	68 59 10 298 59 10						
	pk.B						
JM/	298 59 10 68 59 10 69 91 96 30	69 91 96 31	H	80.586	80.586		
30							
31	69 91 96 299 91 96						
	pk.						
JM/	Septi Di Atas 309 11 08 30	309 11 08 32	H	17.597	17.597		
30							
32	309 11 08 129 11 08						
	pk.B (GAS barik)						
JM/	Septi Di Atas 333 19 22 30	333 19 22 33	H	76.097	76.097		
30							
33	333 19 22 153 19 22						
	pk.						
30	153 19 22 333 19 22 273 95 15 33	273 95 15 37	H	56.506	56.506		
33							
37	273 95 15 93 95 15						
	pk.						
30	Septi Di Atas 226 52 90 33	226 52 90 35	H	99.583	99.583		
33							
2 35	226 52 90 46 52 90						


No. 1 pt


Ward. H. H. H. H.

33 76 52 90 226 52 90 19/0992 2 19/0992 JM/ Sila Liket m/s 3/ R/ 2
JM/ 19/0992 32/0992 Bering Tinitat.

Demarcate.

30-90	185 11 90	31.021	HW AB
30-91	158 17 97	23.695	AB
30-92	139 39 00	19.827	AB
30-93	116 10 26	23.919	AB
30-94	95 56 32	26.199	AB
30-95	83 27 06	35.872	AB
30-96	76 15 25	38.869	AB
30-97	71 15 49	49.946	AB
30-98	72 09 90	63.576	AB
31-49	339 11 94	40.021	BL
33-50	229 03 13	83.150	pk.B
33-51	229 28 96	88.836	AB
33-52	218 40 38	32.933	AB
33-53	67 49 55	81.296	AB
33-54	66 31 09	77.452	AB
33-55	49 52 06	80.753	BKL
33-56	33 12 49	89.206	AB
33-57	7 06 00	41.597	BL
34-58	217 13 15	32.976	AB
34-59	220 42 00	42.173	AB

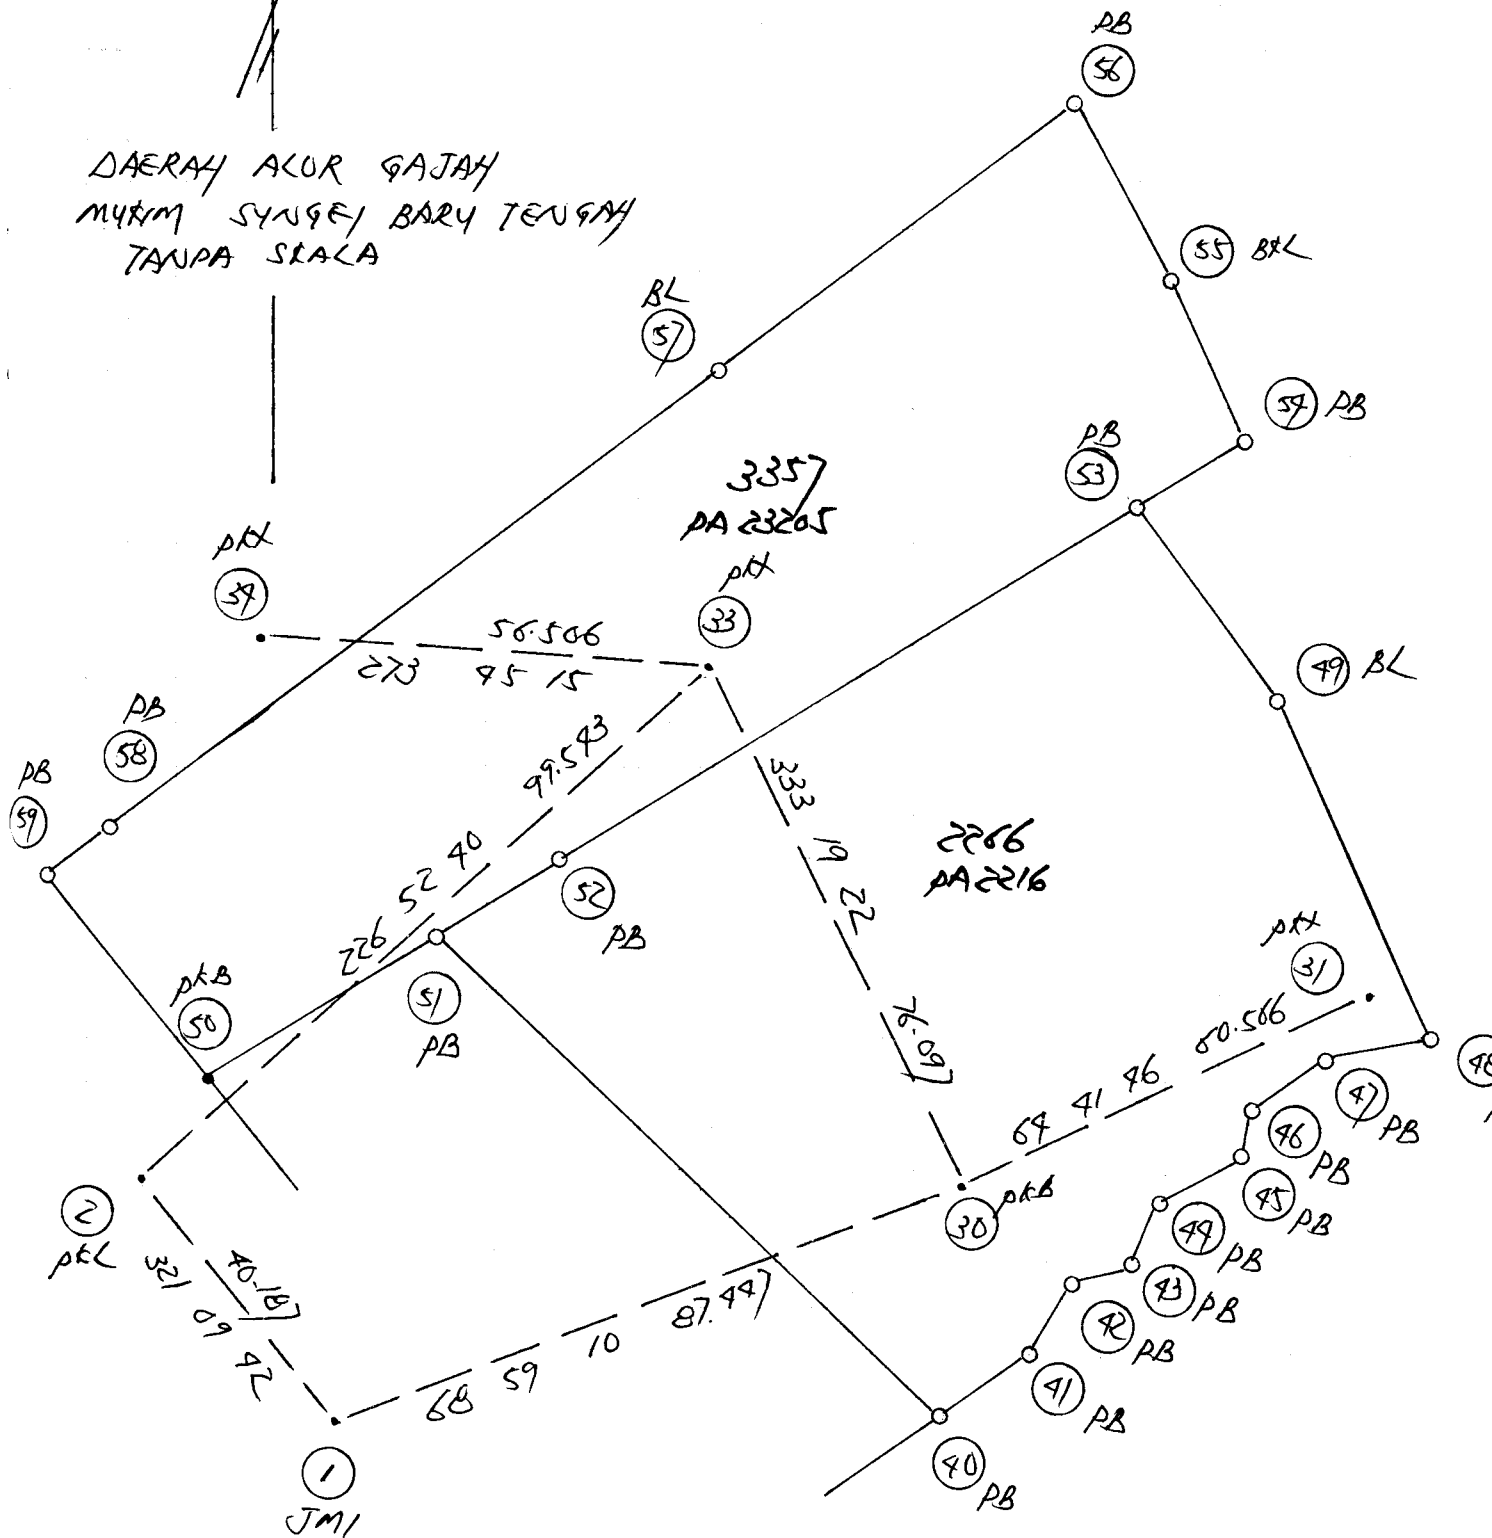

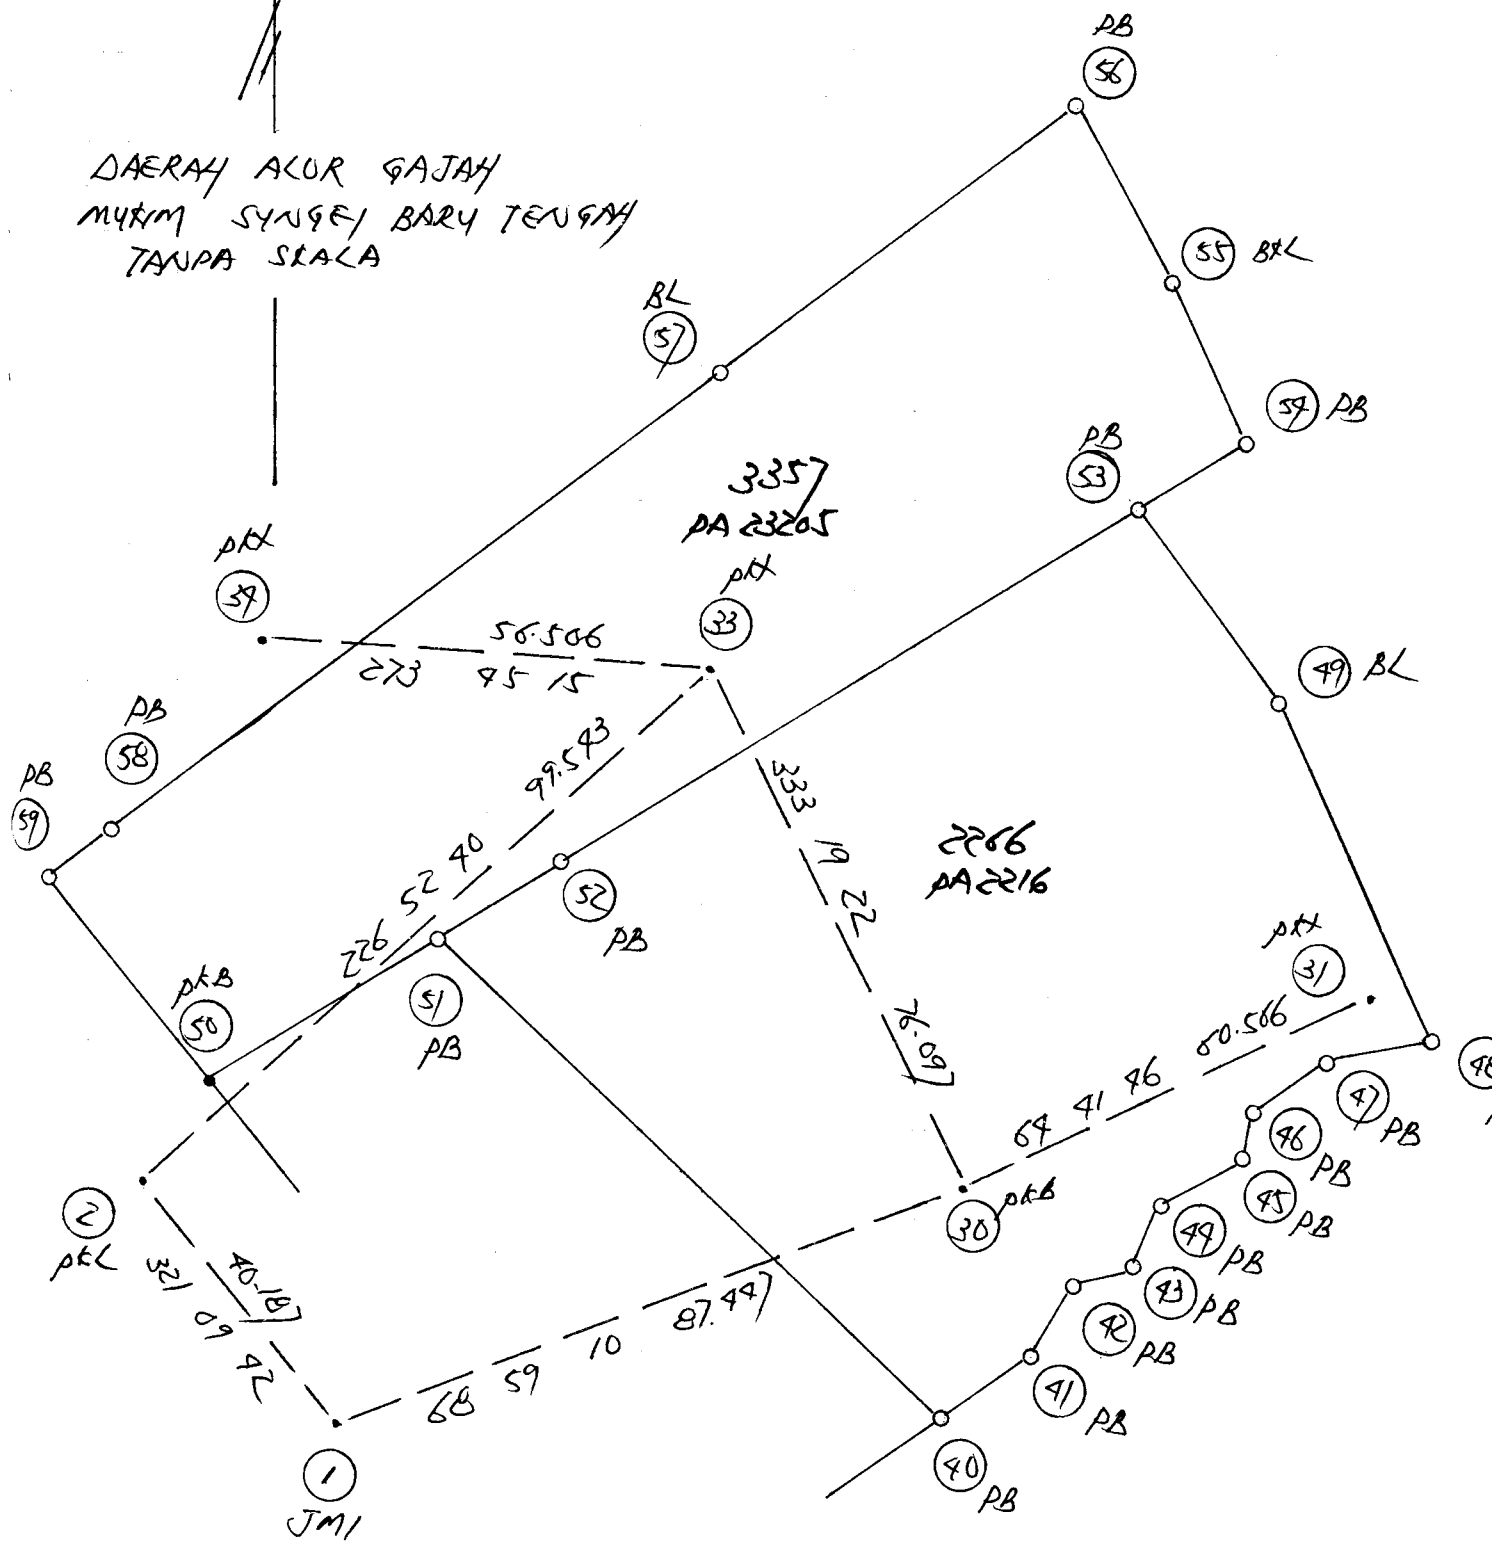

Location JM 0205
Purpose Alor Gajah

10

Purpose					Remarks	
Gen. No.	Horiz. Dist.	Ht. Diff. + or -	RL of Inst.	RL Centre Reading	m	RL Object
				3.61		JM 1
			2.7069	1.7561		F227
			1.1969	2.1635		TBM F 3277/JM 3
			1.4723	1.8876		F2000/GAS
			1.5357	1.0969	2.3135	CP F300
				1.4195	2.4297	TBM F3275/JM 7