


JM1938 U8 Asbuilt Road & Drain

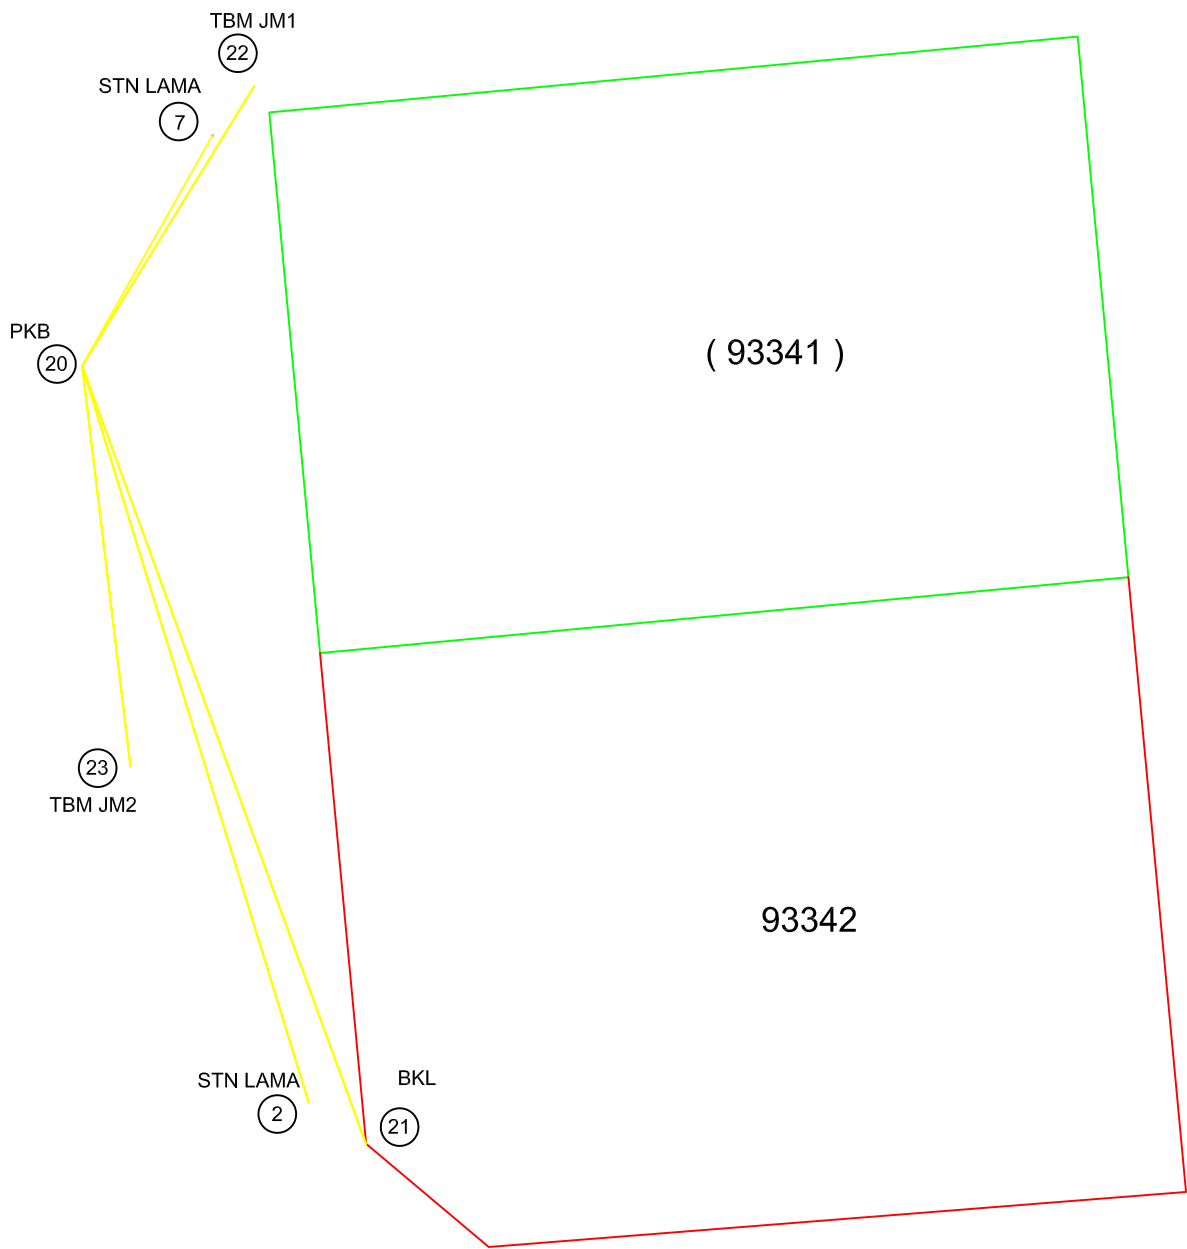

7-2	174 18 13	131.737(New)
	174 18 15	131.741(Po)

-2 0.004