

No. Fail JM3180 Grandword

Rajah di muka

Stesen	BEARING / SUDUT			Dari Stn.	GARISAN	Ke Stn.	Sudut. Pukak (±)	Jarak	Suhu	Jarak Antara Tupang	Jarak Mukamat
	Penyilang Kiri	Penyilang Kanan	Purata		Bearing Mukamat						
	Datum Danipadu			2	0 17 00	1	H	76.022			76.022
				pkB	A3 Ak.	pkB					
					Dgn Mk						
1	0 17 00	180 17 00	80 11 51	2	80 11 51	3	H	72.601			72.601
2											
3	80 11 51	280 11 51									
	pkB										
1	Sgudi Ny. Atas	178 51 32	2	178 51 32	7	H	76.792				76.792
2											
7	178 51 32	358 51 32									
	pkB										
4-5	79 39 01			9	79 39 01	5	H	7.097		pkL	7.097
3-6	9 59 06			3	9 59 06	6	H	2.137		pkL	2.187
3-7	0 13 20			3	0 13 20	7	H	21.913		pkL	21.913
	Demarcation										
24-10	7 49 37			2	7 49 37	10	H	8.872		pkB	8.872
2-11	1 50 32			2	1 50 32	11	H	28.585		pkB	28.585

JM3180 Grand Work.

1.9191

1.8307

1.8966

1.0890

35.5379 ~~628~~ / F1 / TAM

35.6283

F2207

35.8627

F2002

36.370 -

F2 / GAS
(BMJM)

BM B62032

GPS Level: 38.757

BM Level: 38.838

0.119

* BM B3063

GPS Level: 23.509

BM Level: 23.429

0.085


F2 / GAS

GPS Level: 36.755

0.085

36.370

JM3180 GrandWork

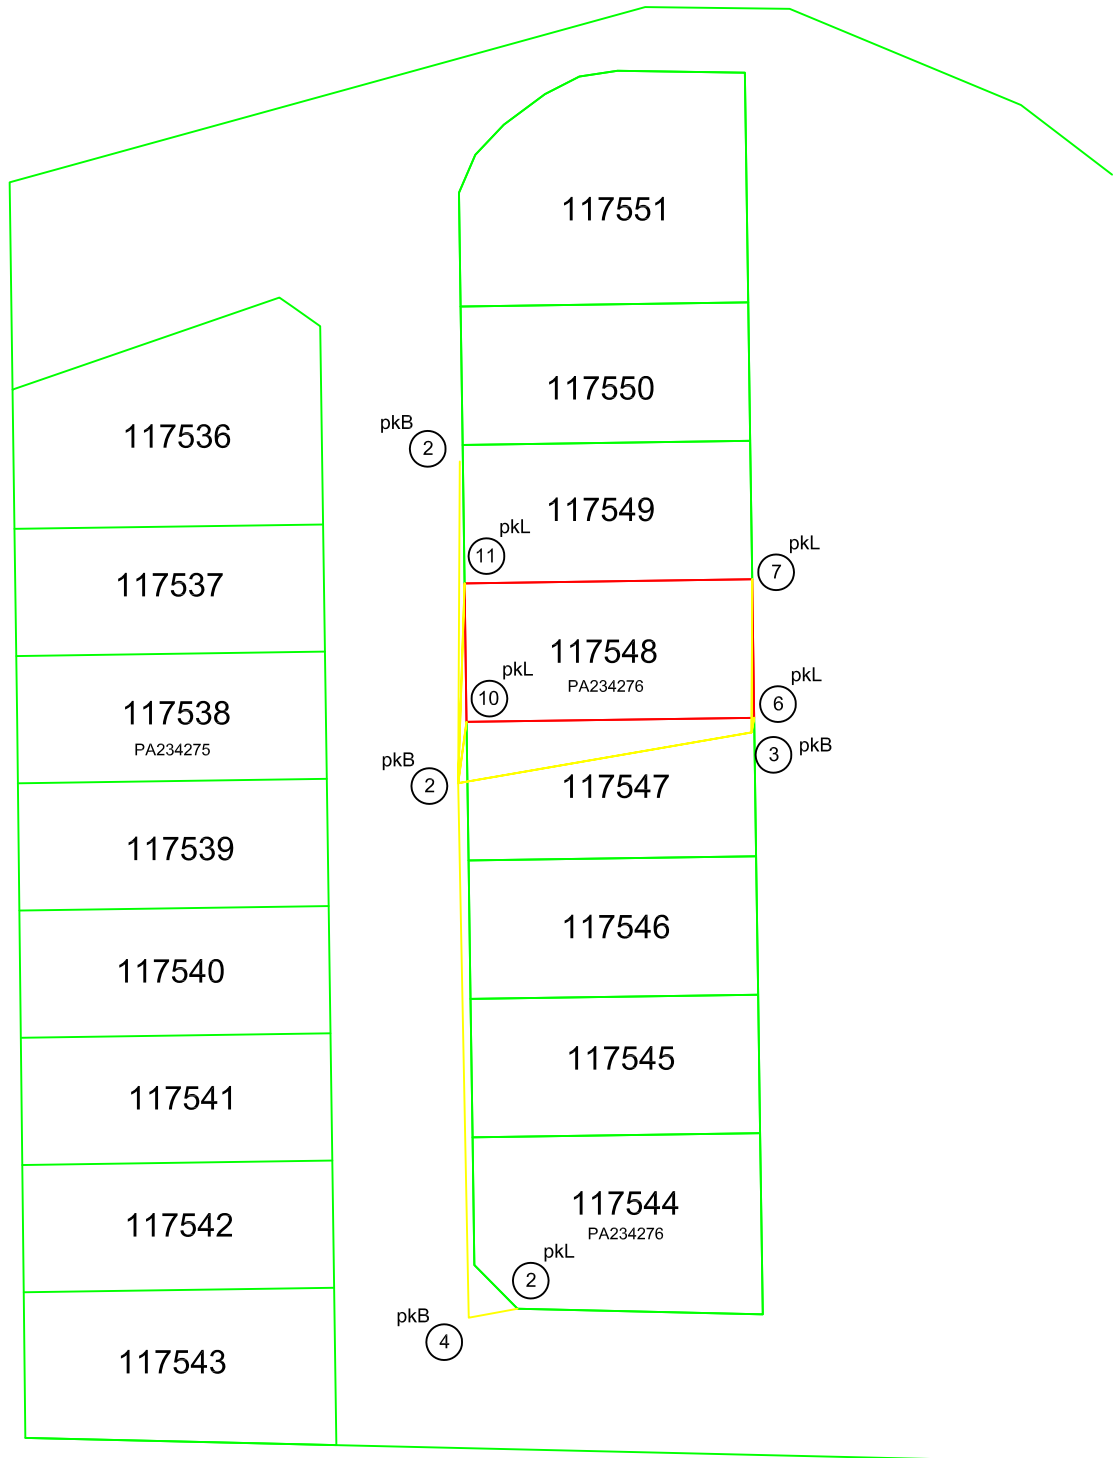

5-7	17 49 40	109.621(New)
	17 49 38	109.617(Po)

-02 0.004

Penilik: JM3180 Meranti Tarikh: 02/07/2024

Stn. 2 Koordinat: S24070 B5730 Selangor

T.R. 1 B.K. Ms.

Tiodolit Satu bah. aras ufuk:

Waktu	Sasaran	Ufuk	Gelembong	Puguk
	T.R.	46 00 00		
9 56	M.H.	108 58 19	52 12 21	Waktu purata 9 56 30
9 56	M.H.	108 15 46	52 05 49	Beza dari U.T. - 8 00 00
9 57	M.H.	288 13 10	308 01 39	U.T. 1 56 30
9 57	M.H.	288 50 56	308 08 31	Deklinasi 23 00 29
	T.R.	226 00 00		

	T.R.	46 00 00		
9 54	M.H.	109 09 15	52 45 45	Waktu purata 9 54 30
9 54	M.H.	108 27 42	52 40 16	Beza dari U.T. - 8 00 00
9 55	M.H.	288 25 00	307 26 56	U.T. 1 54 30
9 55	M.H.	289 02 47	307 33 27	Deklinasi 23 00 29
	T.R.	226 00 00		

	Set 1	Set 2
Sudut pugak	37 58 00	37 23 36
Pembetulan	- 0 01 00	- 0 01 02
Altitud	37 57 00	37 22 34
Jarak kutub	66 59 31	66 59 31
Latitud	2 57 23	2 57 23
Azimut M.H. yang dikira	62 52 02	63 03 36
Purata ke M.H.	108 34 33	108 46 11
Selisih:	- 45 42 31	- 45 42 35
Purata ke T.R.	46 00 00	46 00 00
Azimuth T.R. sebenar	0 17 29	0 17 25
Pembetulan aras	+ 0 00 00	+ 0 00 00
Tirusan	- 0 00 27	- 0 00 27
Bering grid T.R.	0 17 02	0 16 58
Purata bering grid T.R.	0 17 00	