
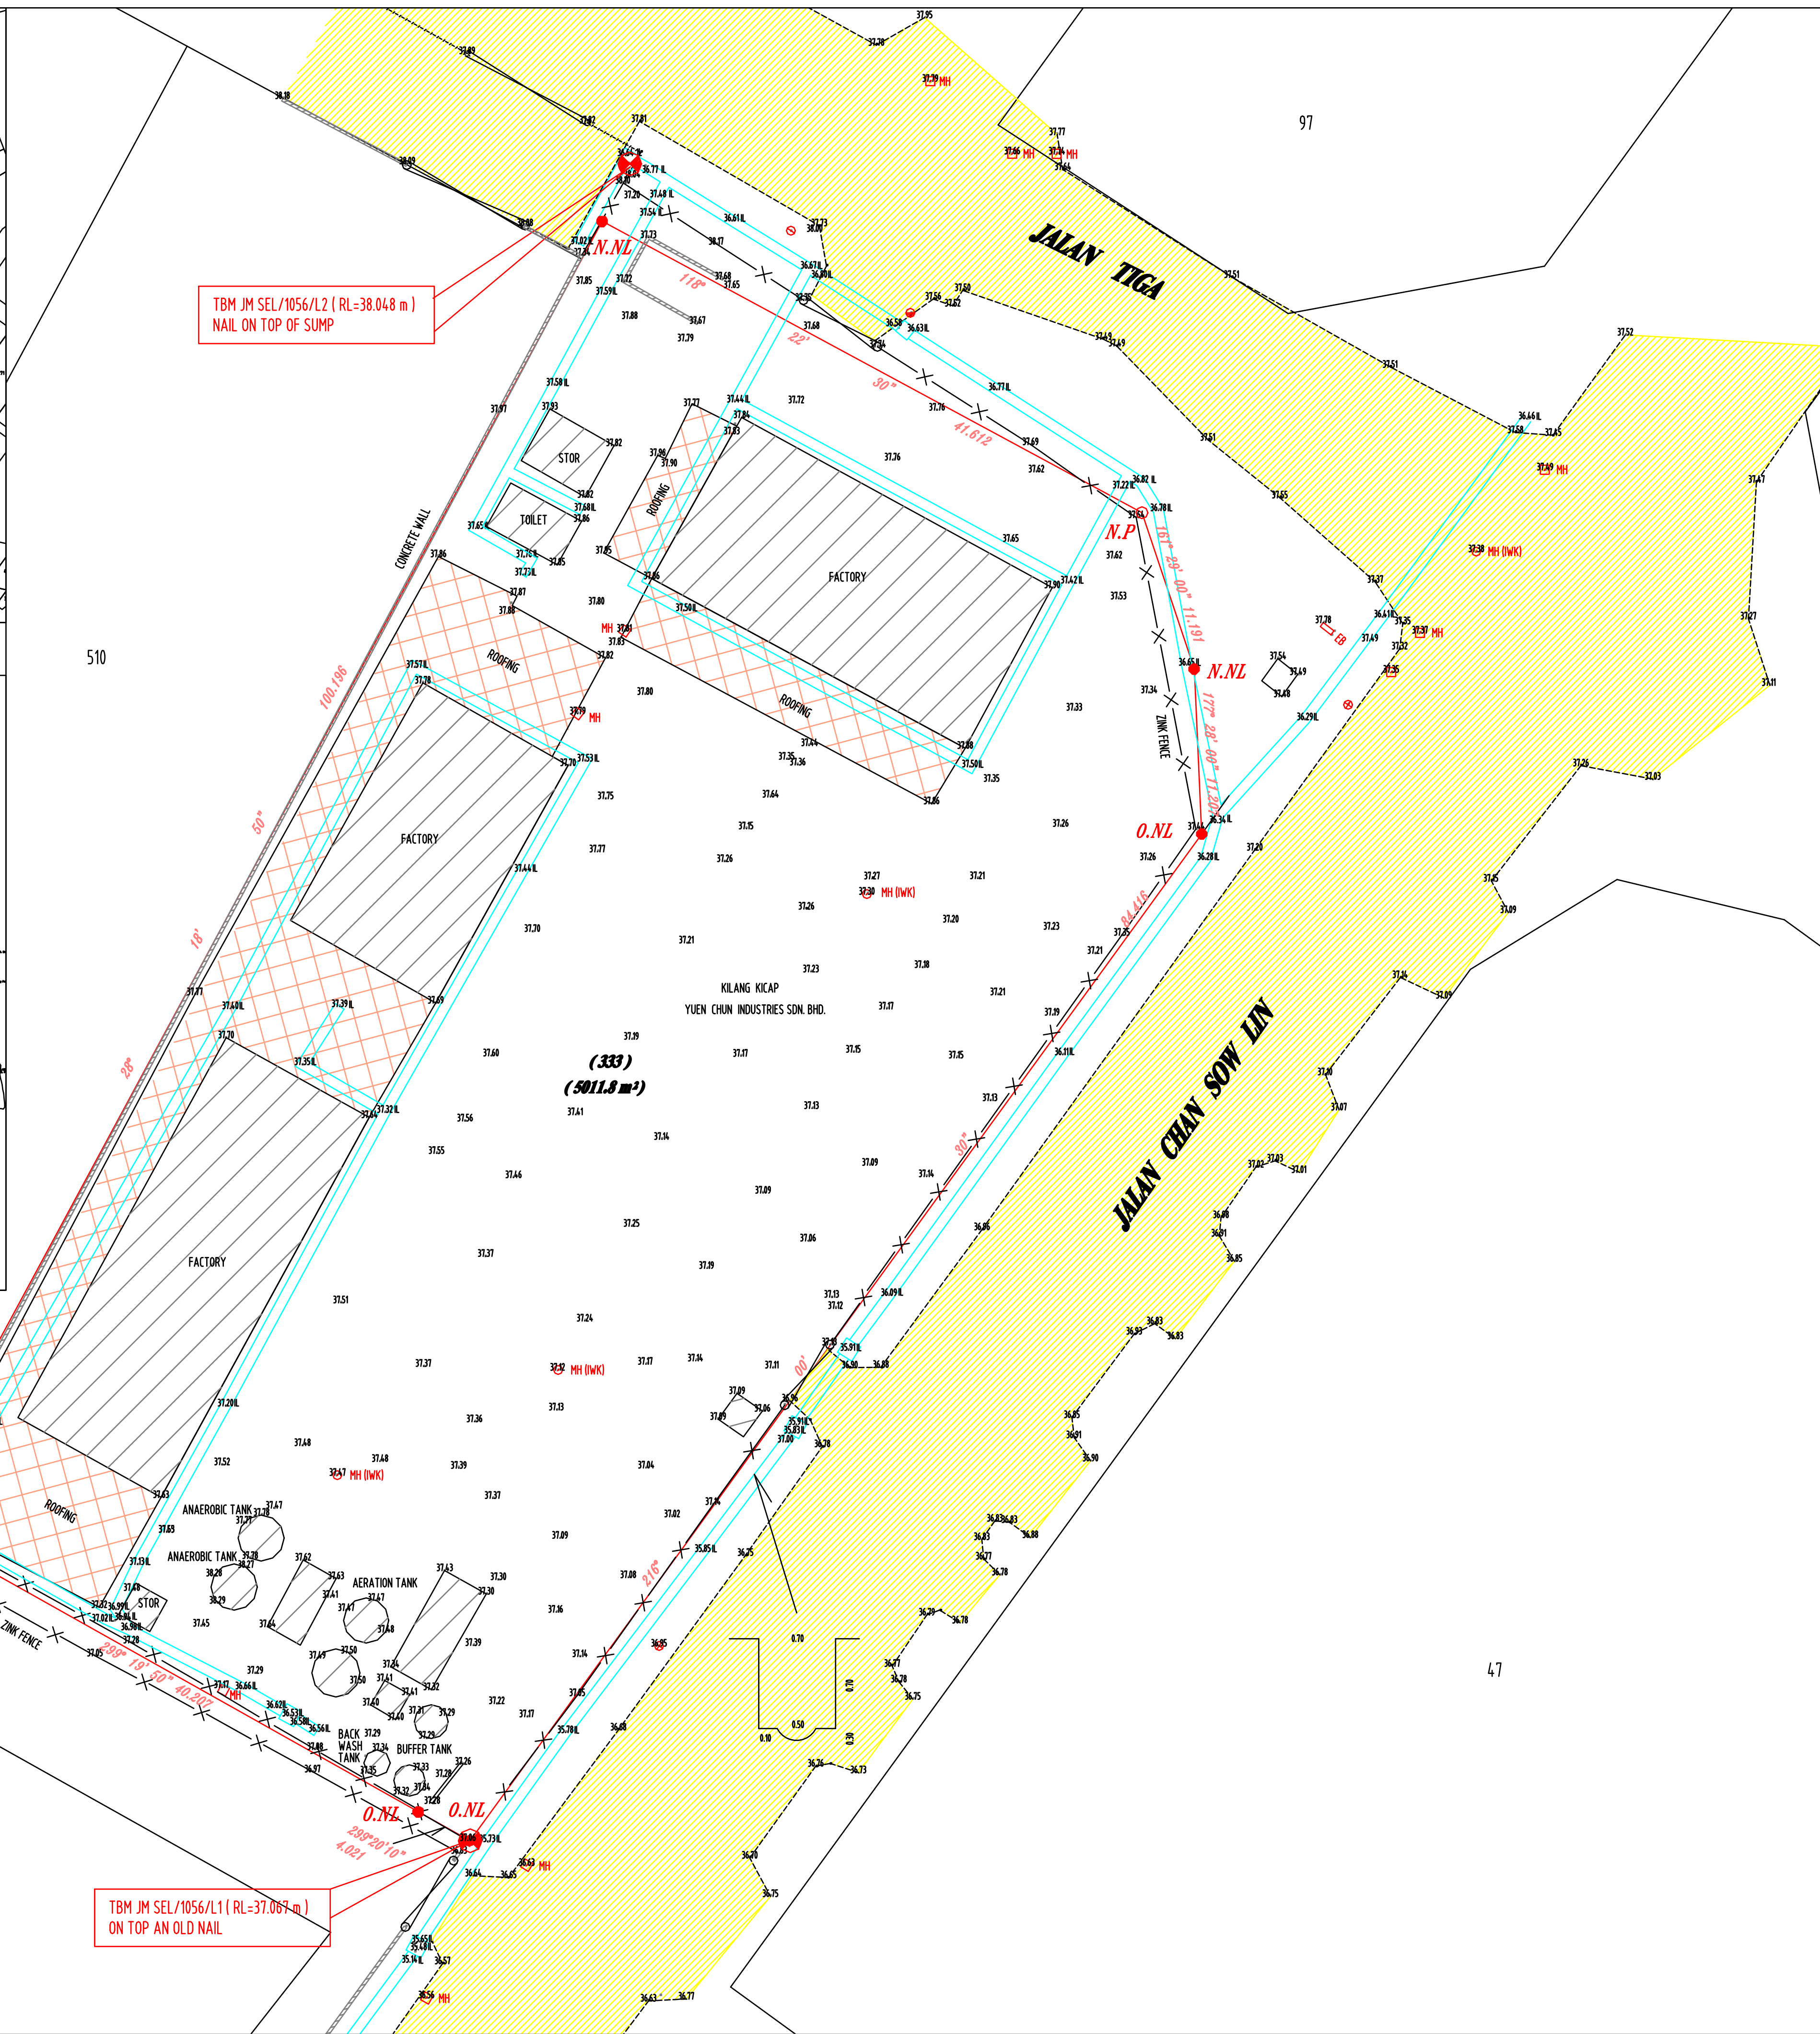


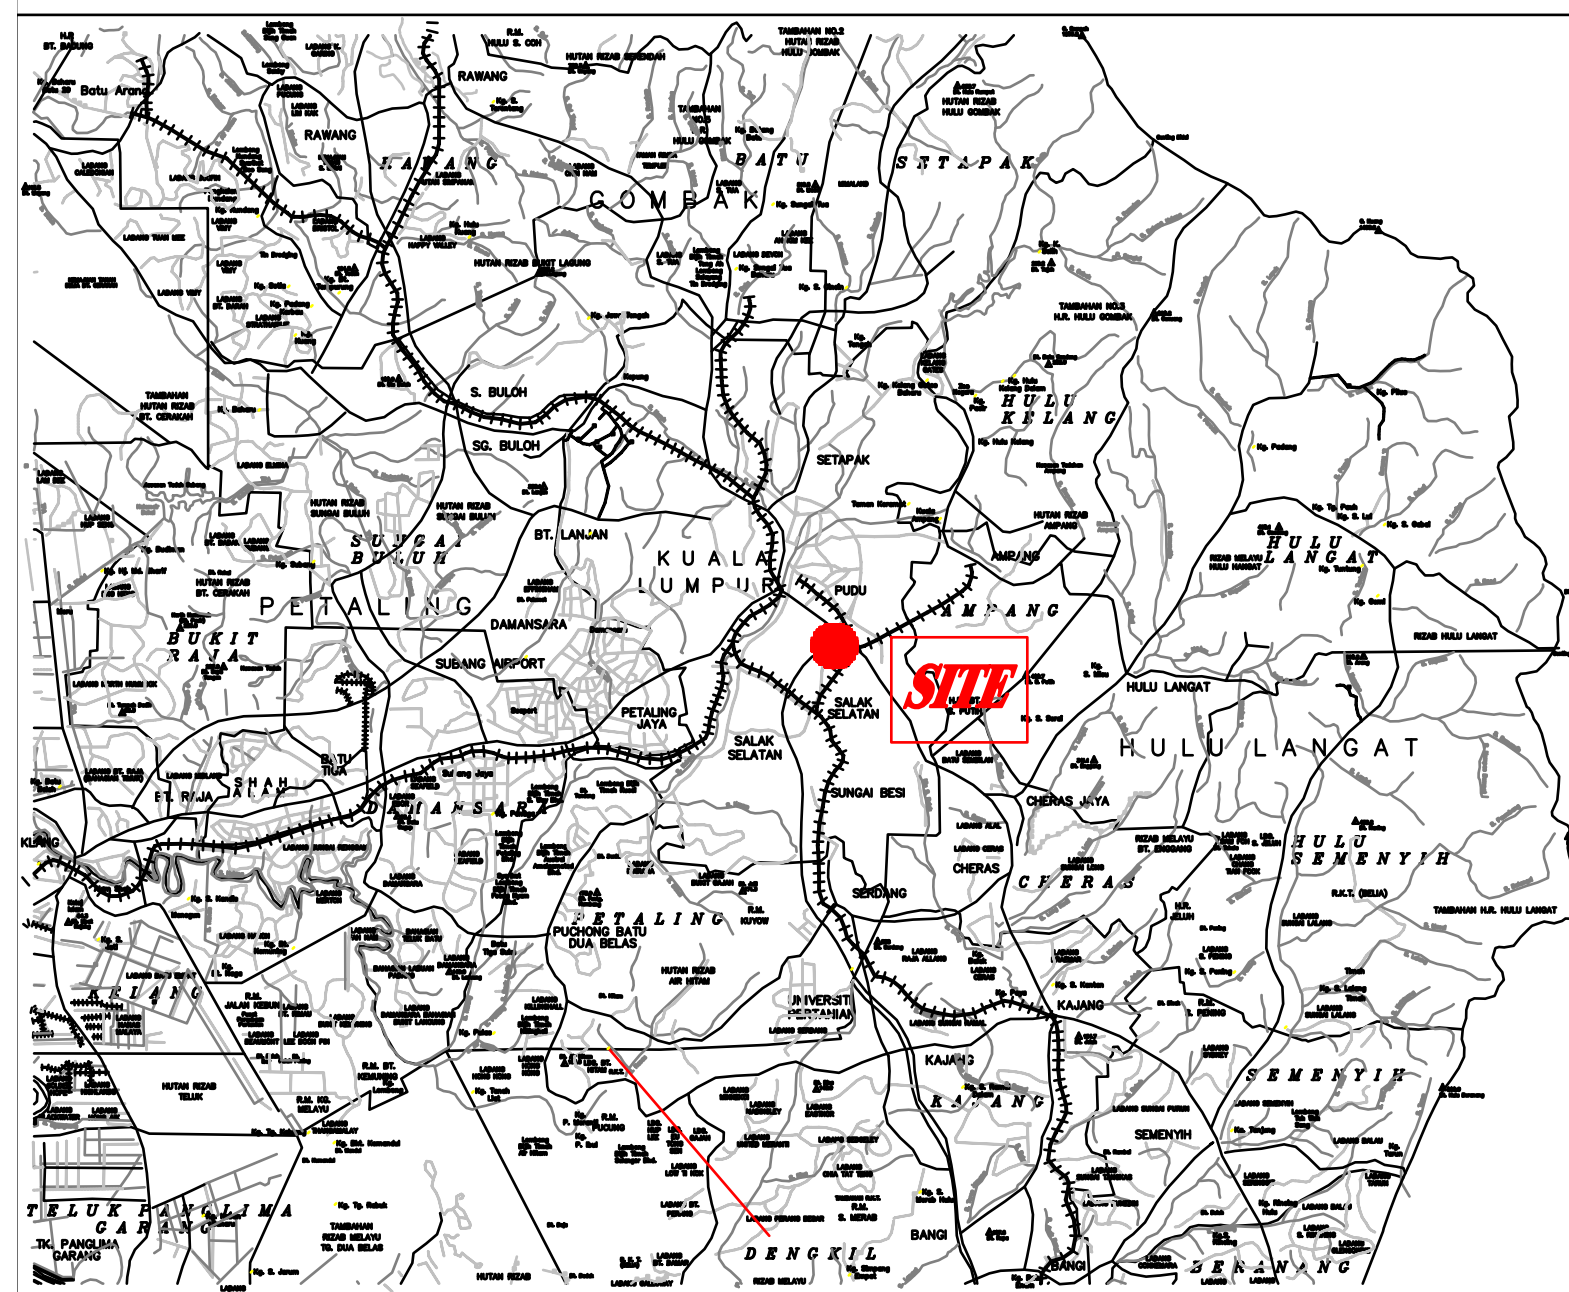

SCALE 1 : 250

STANDARD SHEET : 86 - C - I - 14

**TITLE**  
**DEMARCATON, DETAIL & SPOT LEVEL SURVEY**  
**ON LOT 333, SECTION 92,**  
**MALAN CHAN SOW LIN, TOWN OF KUALA LUMPUR**  
**MILYAH PERSEKUTUAN KUALA LUMPUR**

NOTE:

SEMUA ARAS ADALAH BERDASAR DARI BM W0320 (A.L.=36.419m)  
DI KIRI JALAN CHAN SOW LIN - PUDU  
DI SIMPANG JALAN EMPAT OFF JALAN TUN RAZAK  
DI TEPI KABEL TELEKOM DAN BERTENTANGAN KILANG ROTI

LEGEND:

|             |                        |
|-------------|------------------------|
| <i>N.NL</i> | - NEW NAIL             |
| <i>O.NL</i> | - OLD NAIL             |
| <i>N.P</i>  | - NEW PIPE             |
| MH          | - MAINHOLE ( TELEKOM ) |
| MH ( IWK )  | - MAINHOLE SEWERAGE    |
| EB          | - ELECTRIC BOX         |

FIELD BOOK NO F0147  
LEVEL BOOK NO L0092  
TACHY BOOK NO T0205

SURVEYED BY : LEOW

COMPUTED BY : ZUL / FRZ

DRAWN BY : ZUL 12/04/2010

CHECKED BY : HKP

H'NG KIM POR B.Sur. (Hons.) (Land) MIS (M)  
and Surveyor Licensed Under Act 458 (Revised 1991)

 **JURUKUR MURNI**  
**LICENSED LAND SURVEYOR**

No. 35-1, Jalan 16/155C Bandar Bukit Jalil  
57000 Kuala Lumpur, Malaysia  
Tel : 03-89940029/89940069  
Fax : 03-89940039  
Email : [jmurni@streamyx.com](mailto:jmurni@streamyx.com)/ [jmurni@gmail.com](mailto:jmurni@gmail.com)

**PLAN NO.: JME/10SEL/1056**

***DIGITAL FILE : JMSEL1056***