

ASM 123 Putra H/1/

No. Kaid

Rajah di muka

BEARING SUDUT			Dari Stn	DARIKAN		Ke Stn	Jarak Bujur	Jarak Lintang	Jarak Magnetik
1	2	3		4	5				
1	2	3	4	5	6	7	8	9	10
Datum	Danpada	282 0518	2	282 0739	1	4	36.226		36.226
PA	M- 39'	pk-B		SpL					
1	282 0518	102 0518	91 0372	2	91 0303	3	4	60.528	60.528
2			M- 39'						
3	91 0372	271 0372							
			pk-B						
1	Sprink. Di Atas	26 3833	2	26 3757	7	4	18.969		18.969
2			M- 39'						
7	26 3833	206 3833							
			pk-B						
2-5	272 5802			2	272 5523	5	4	57.981	BKL 57.981
2-6	270 0176			2	270 0107	6	4	57.903	SpL 57.903
2-7	258 1239			2	258 1155	7	4	21.219	BKL 21.219
2-8	256 1739			2	106 1700	8	4	16.905	BKL 16.905
2-9	95 0311			2	95 0232	9	4	52.520	BKL 52.520
2-10	391 2606			2	391 2527	10	4	7.998	BKL 7.998
2-11	290 0206			2	290 0127	11	4	22.175	BKL 22.175
4-12	18 5550			7	18 5511	12	4	22.301	BKL 22.301
7-13	332 1958			7	332 1919	13	4	23.811	BKL 23.811

No. Erid


Rajah di muka

Demarcation.
2-20 69 1696 17.971 PB.

1-10 89 5950 32.876 ~
89 5950 32.876 00
~
Nil Nil

10-12 30 5799 35.535 ~
30 5752 35.576 00
~
-8' -0.01'

DAERAH PETAKING.
MUKIM SUNGAI BUKUH
TANPA SKALA

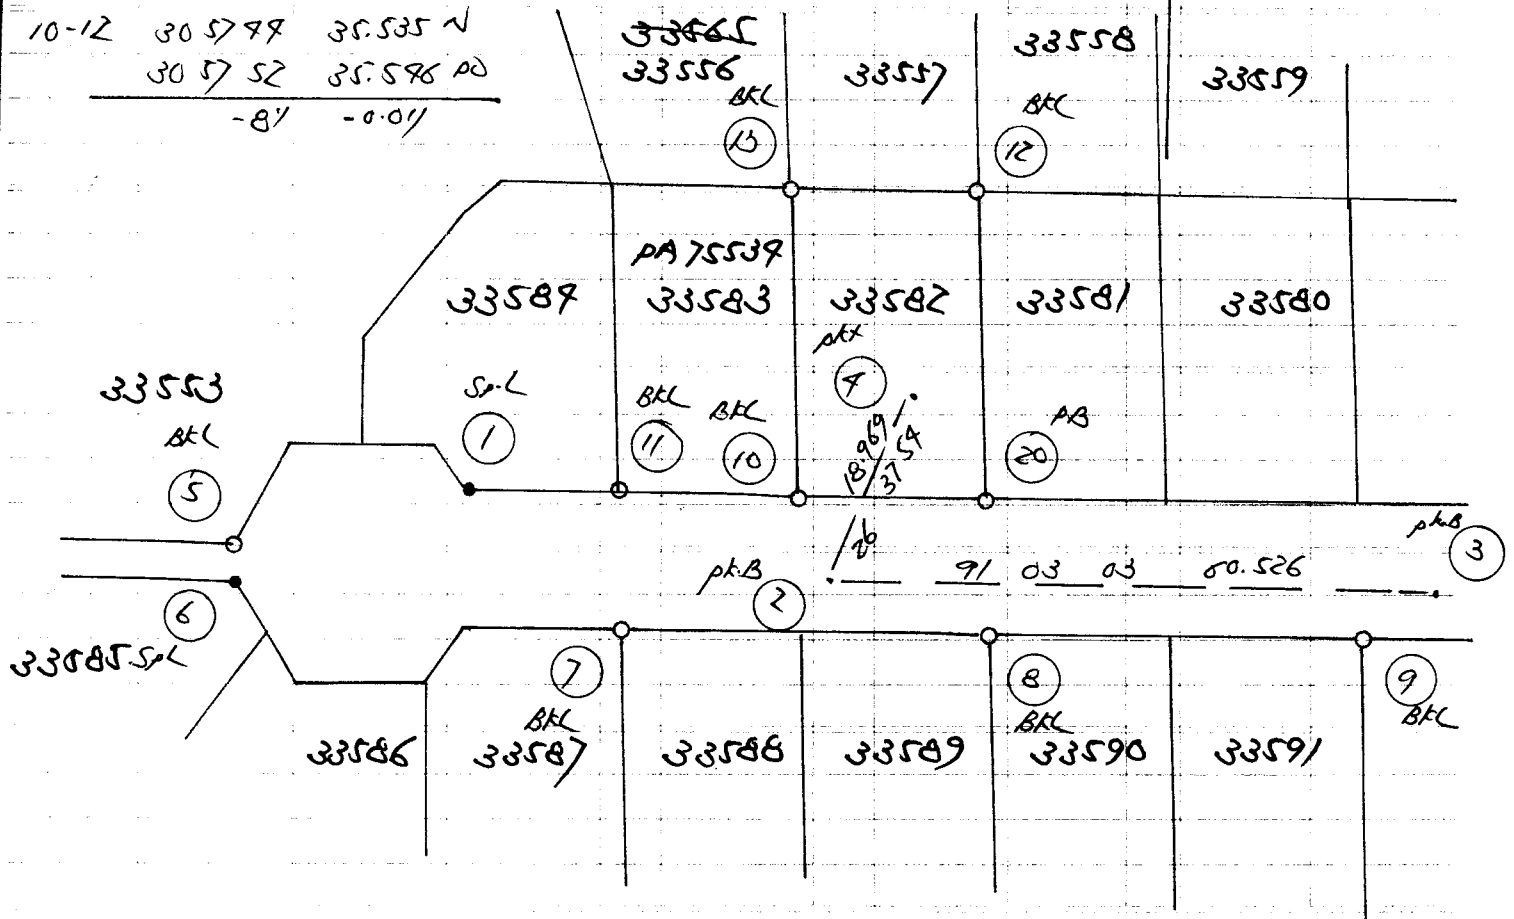

Tarikh Aras
 Daripada 15/11/15

Dibuat untuk 74
 Ke
 All the right hand
 on B/L B21R3

Pandangan Belakang	Pandangan Antara	Pandangan Hadapan	Naik	Turun	Aras Yang Dilaras	Jarak	Catitan
2.928	(9.59)				30.357	78m P47	RC: 30.357 P47 2059 M/S 66
3.191	(10.8)	0.237	(0.78)		33.088	78m P47	RC: 30.357
3.888	(12.62)	0.258	(0.83)		35.981		
3.319	(10.89)	0.168	(0.59)		39.685		
		2.087	(6.22)		70.937	P2 (0.14 sh)	P47 2059 boat type traffic light.
2.087	(6.12)				70.937	P2	
3.698	(12.11)	0.510	(1.62)				
2.858	(9.36)	0.238	(0.22)				
3.716	(12.19)	0.283	(0.86)				
3.786	(12.36)	0.130	(0.83)				
3.835	(11.27)	0.112	(0.37)				
0.299	(0.98)	2.819	(9.25)				
1.067	(3.56)	2.681	(8.80)				
		0.882	(2.93)		58.170		
20.878		7.681				78m P47 P1903	naif on traffic light boat di hadapan AS rumah perah air jln B/L P211, berthangas dgn guard house putra 4/1/15. B/L P212

Tarikh Aras

Dibuat untuk Ke

75

Daripada

Pandangan Belakang	Pandangan Antara	Pandangan Hadapan	Naik	Turun	Aras Yang Dilaras	Jarak	Catitan
0.892 (293)			(16.15)		58.170	78M F1903	
1.394 (195)		1.873	(16.63)				
1.795 (1573)		2.022					
1.829 (1600)		1.324	(18.38)				
2.986 (1978)		0.124	(10.80)				
2.957 (1976)		0.321	(11.05)				
3.997 (1295)		0.462	(1.52)				
1.713 (1562)		0.190	(10.02)				
17.457		1.703	(14.00)		63.908	F3	
1.403		7.719					
2.745					63.908	F3	
0.827 (221)		2.715	(18.71)		62.596	78M F1904 di. top. 12, 19th co.	
	0.919 (1302)				62.509	78M F1905 Atk Hydant.	
		1.670	(15.84)		61.753	F2	