

J2 - W029 77A1

Datum Stripack		2	88 78 95 1	4	93.510	5/1/2012	93.510
			Aj Ak.				
			Ag 114				
2-3	16 0753 19	2	16 0753 3	4	28.658	BKL	28.658
2-7	327 1652	2	327 1652 7	4	78.106	pkc	78.106
2 288 78 95 88 78 95 7 7736 1 7 7736 5				4	67.063		67.063
1							
5 7 7736 18 7736							
pkB							
1 187 7736 7 7736 318 1130 5 318 1130 6				4	79.625		79.625
5							
6 318 1130 138 1130							
pkB							
5 138 1130 318 1130 317 1195 6 317 1195 7				4	111.735		111.735
6							
7 317 1195 137 1195							
pkB							
6 137 1195 317 1195 316 9122 7 316 9122 8				4	108.989		108.989
7							
8 316 9122 136 9122							
pkB							
7-9	232 5350	7	232 5350 9	4	102.610	BKL	102.610
8-							
8-10	373 2099	8	373 2099 10	4	3.195	pkc	3.195

7 136 9122 369122 359 0958 8 359 0958 11 4 55.556 55.556

8
11 359 0958 179 0958

pk-8

11-12 123 8325

11-13 88 0950

11-19 358 8521

11 123 8325 12

11 88 0950 13

11 358 8521 19

4

6.586

4

55.200

4

57.299

pk-8

pk-8


pk-8

6.586


55.200

57.299

3-9 3151305 136.176 ✓
3151321 136.189 00
 -16" -0.008

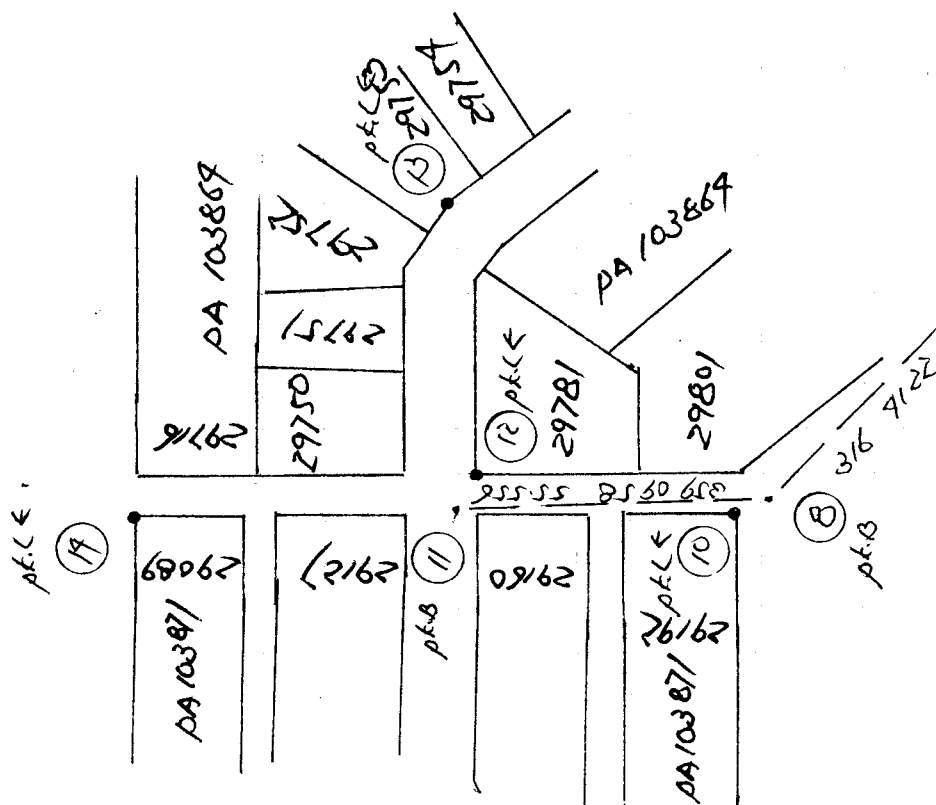

WIKAYAT PERSEKUTUAN
MUKIM KAYAKUMBAR
TANPA SKALA

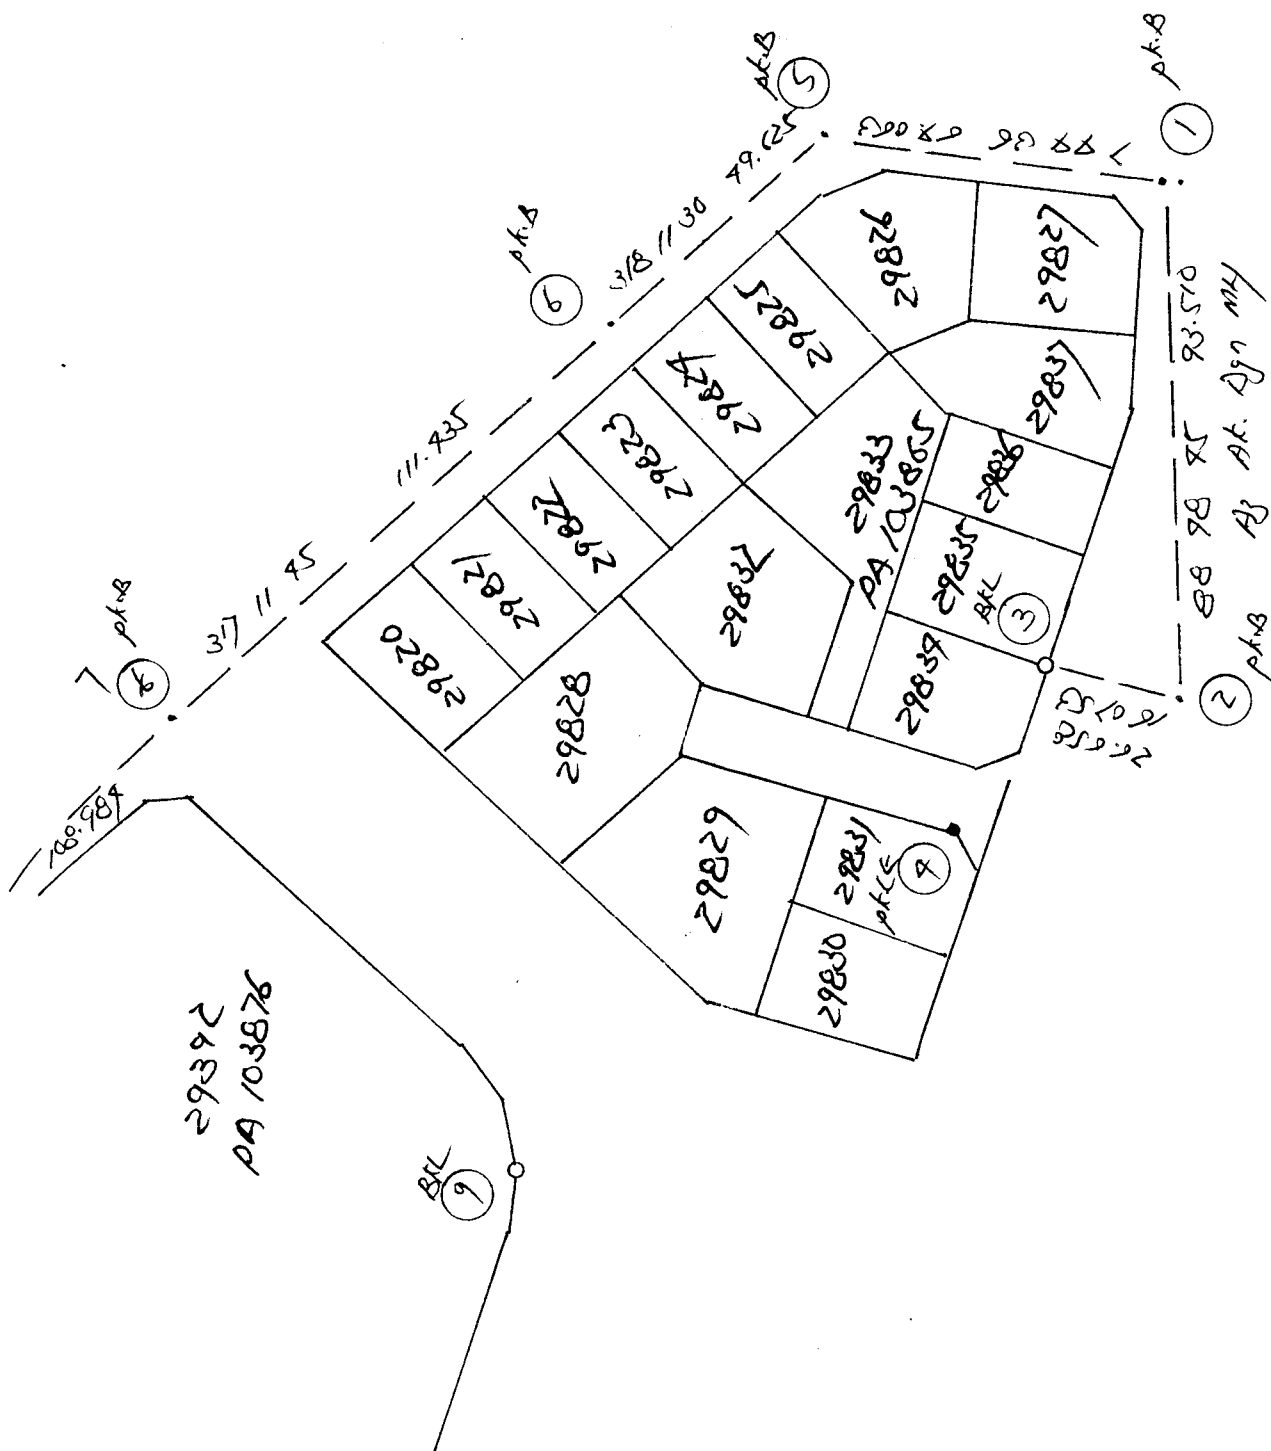

Stasiun: JZW029 TTDI Tarikh: 05/01/2012
 Puncak Koordinat: S3517 B8560 Selangor
 Puncak: K. Ms.
 Dataran: Satu bah. aras ufuk:

Ufuk	Basaran	Ufuk	Gelembong	Peguk		
	P.R.	85 00 00				
1.00	M.H.	110 18 55		78 51 27	Waktu purata	8 09 30
1.00	M.H.	109 46 30		78 45 06	Beza dari U.T. -	8 00 00
1.00	M.H.	289 47 49		281 20 30	U.T.	0 09 30
1.00	M.H.	290 21 47		281 25 08	Deklinasi	- 22 41 49
	P.R.	265 00 00				

	P.R.	85 00 00				
1.00	M.H.	110 22 34		78 26 39	Waktu purata	8 11 30
1.00	M.H.	109 50 04		78 22 01	Beza dari U.T. -	8 00 00
1.00	M.H.	289 51 18		281 43 42	U.T.	0 11 30
1.00	M.H.	290 25 18		281 47 37	Deklinasi	- 22 41 48
	P.R.	265 00 00				

	Set 1	Set 2
Waktu peguk	11 17 16	11 40 40
Waktu dikan	- 0 04 11	- 0 04 02
Waktu dikan	11 13 05	11 36 38
Waktu dikan	112 41 49	112 41 48
Waktu dikan	3 08 32	3 08 32
Waktu dikan M.H. yang dikira	113 52 55	113 56 25
Waktu dikan ke M.H.	110 03 45	110 07 19
Waktu dikan	3 49 10	3 49 06
Waktu dikan ke P.R.	85 00 00	85 00 00
Waktu dikan ke P.R. sebenar	88 49 10	88 49 06
Waktu dikan aras	+ 0 00 00	+ 0 00 00
Waktu dikan	- 0 00 23	- 0 00 23
Waktu dikan grid T.R.	88 48 47	88 48 43
Waktu dikan grid T.R.	88 48 45	

Tarikh Aras

Dibuat untuk 62

Daripada 02 0029 7701

Ke

Pandangan Belakang	Pandangan Antara	Pandangan Hadapan	Naik	Turun	Aras Yang Dilaras	Jarak	Catitan
1.950	(6.96)				53.215	78M 1990 F1991	
	2.193	(7.03)			53.022	FC	
	1.232	(4.04)			54.933	78M 1994 F1992	
	0.535	(1.18)			54.630	78M 1992 Apts Hydrant Di Atas Hadapan	
		0.386	(1.2)	54.779	8.572 /	94	79 & 77.
0.304	(1.06)			54.779	8.572	94	
	1.899	(6.0)				FI	
2.245	(7.32)	0.780	(2.49)				
2.987	(8.16)	1.210	(3.77)				
0.581	(1.91)	1.171	(3.39)				
1.715	(4.64)	3.983	(11.23)				
		1.208	(3.96)		54.009	BM W 0087 Bmbs Tmn Tm.	
7.021		7.802				RC: 54.009 m	