

No. Fail 78 W086 CHO Lot 85792


No. 1-211

Rajah di muka

[illegible]

No. Fail

Rajah di muka

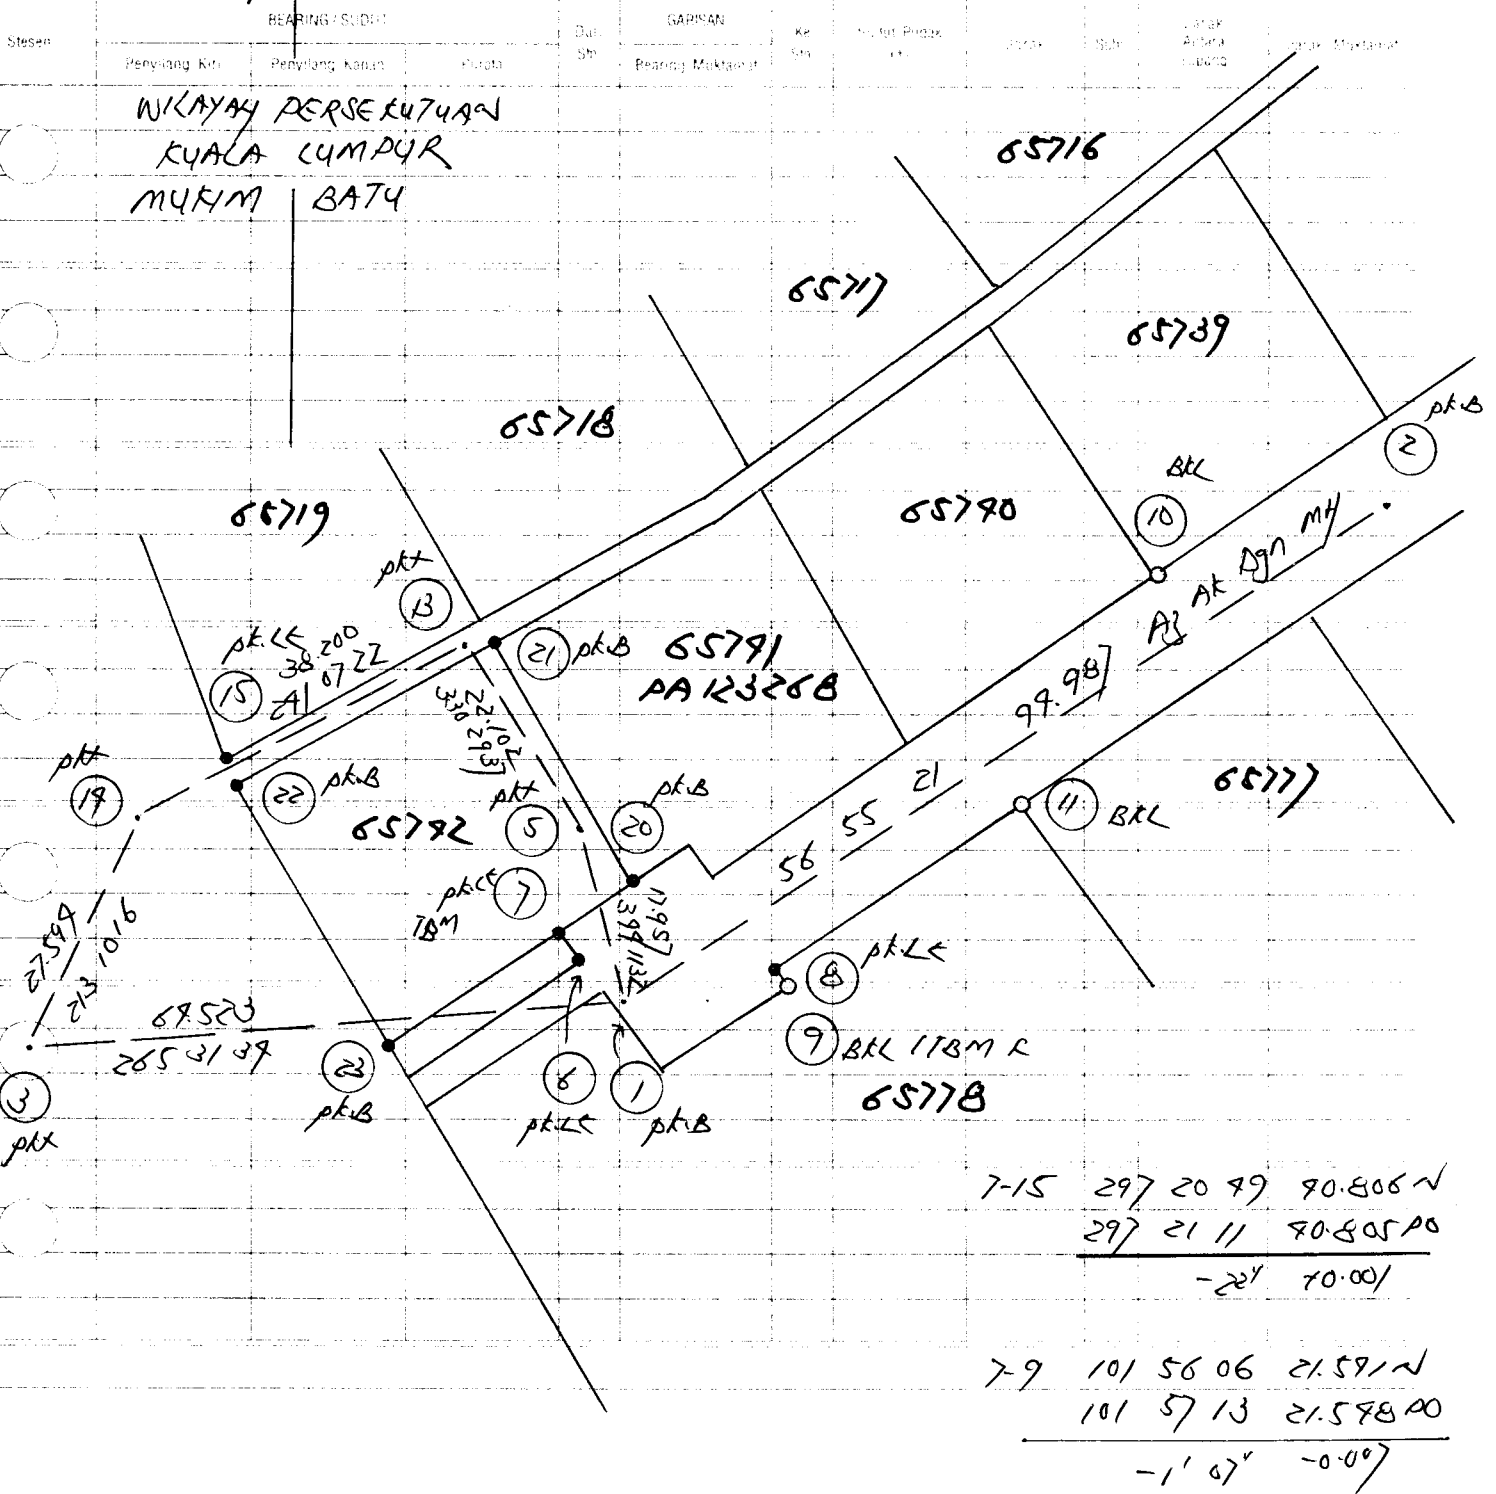

Tarikh

02-0006

Aras

Dibuat untuk

61

Daripada

Ke

Pandangan Belakang	Pandangan Antara	Pandangan Hadapan	Naik	Turun	Aras Yang Dilaras	Jarak	Catitan
1.332	(1837)				171.368	78m km W/O7	RC: 171.368
0.908	(297)	2.850	(19.35)		171.065	786	Don 52/111/WO/12/14/1
1.765	(188)	1.628	(15.38)		169.850	F2	
	(139)	(1872)			169.387		
	(1903)	(1860)			169.126		
		1.442	(14.73)		169.294	78m F2218	Atu 211/
3.761		5.920			169.188	F1	
					169.199	78m F2219	Atu 211 (Town lot).

All the rights reserved
Don WO/86 RC: 62/11/17