

JZ 08/W Ayr Anas.

No. Fail

Rajah di muka

Stesen	BEARING / SUDUT			Dari Stn	GARISAN		Ke Stn	Sudut Pukak (*)	19/10/2012 19/11/2012		Jarak Muktamat
	Penyilang Kiri	Penyilang Kanan	Purata		Bearing Muktamat				Jarak Sulu	Jarak Antara Tumpang	
	Datam Daripada			2	873529	1	4	47.101		47.101	
				pk.B	Aj Ak.	pk.B					
					Dgn m/j						
2-3	1913035			2	1913035	3	4	11.755	Sp.L	11.755	
2-4	1017937			2	1017937	7	4	11.898	Sp.L	11.898	
2-5	897757			2	897757	5	4	36.952	pk.L	36.952	
1	873529	2873529	132189	2	132189	6	4	33.216		33.216	
2											
6	132189	1332189									
	pk.B										
1-7	311896	131189		1	311896	7	4	15.690	PL	15.690	
1-8	3361130			1	3361130	8	4	33.116	pk.L	33.116	
1-9	237950			1	237950	9	4	36.530	BKL	36.530	
1-10	717900			1	717900	10	4	39.597	BKL	39.597	
2	2873529	873529	11806	1	11806	11	4	79.119		79.119	
1											
11	11806	1811806									
	pk.B										
1	1811806	11806	2517100	11	2517100	6	4	71.138		71.138	
11											
6	2517100	717100									
11	717100	2517100	1932189	6	1932189	2		Sila Lihat Atas Ruang			
6											
2	1932189	132189									
					Bering Tertutup						

Bering 6-2 Di Baca 1932189

Sepertinya Di Baca 1932189

Titik-titik

Ni/


Am betul-betul

Ni/

WIKAYAH PERSEKUTUAN
MUKIM SETAPAK.
TANYA SAKA

Rajah di muka

Stasiun	BEARING / SUDUT			Dari Stn	GARISAN	Ke Stn	Sudut Pukak	Jarak	Subu	Jarak Antara Papan	Jarak Muktamat
	Penyilang Kiri	Penyilang Kanan	Perata		Bearing Muktamat						
<u>Demarcatan 15/10/92</u>											
11-20	159 59 16	35.560	PB		11-1E	167 20 41	30.977	4WP			
11-21	161 02 29	38.015	PB		11-2E	166 21 00	28.791	4WP			
11-1A	197 05 39	33.551	4WP		11-9E	169 06 36	20.552	4WP			
11-2A	200 19 29	29.730	4WP								
11-9A	207 00 37	29.269	4WP								
11-1D	185 18 03	31.933	4WP								
11-2D	187 09 58	27.317	4WP								
11-9D	191 01 39	21.238	4WP								

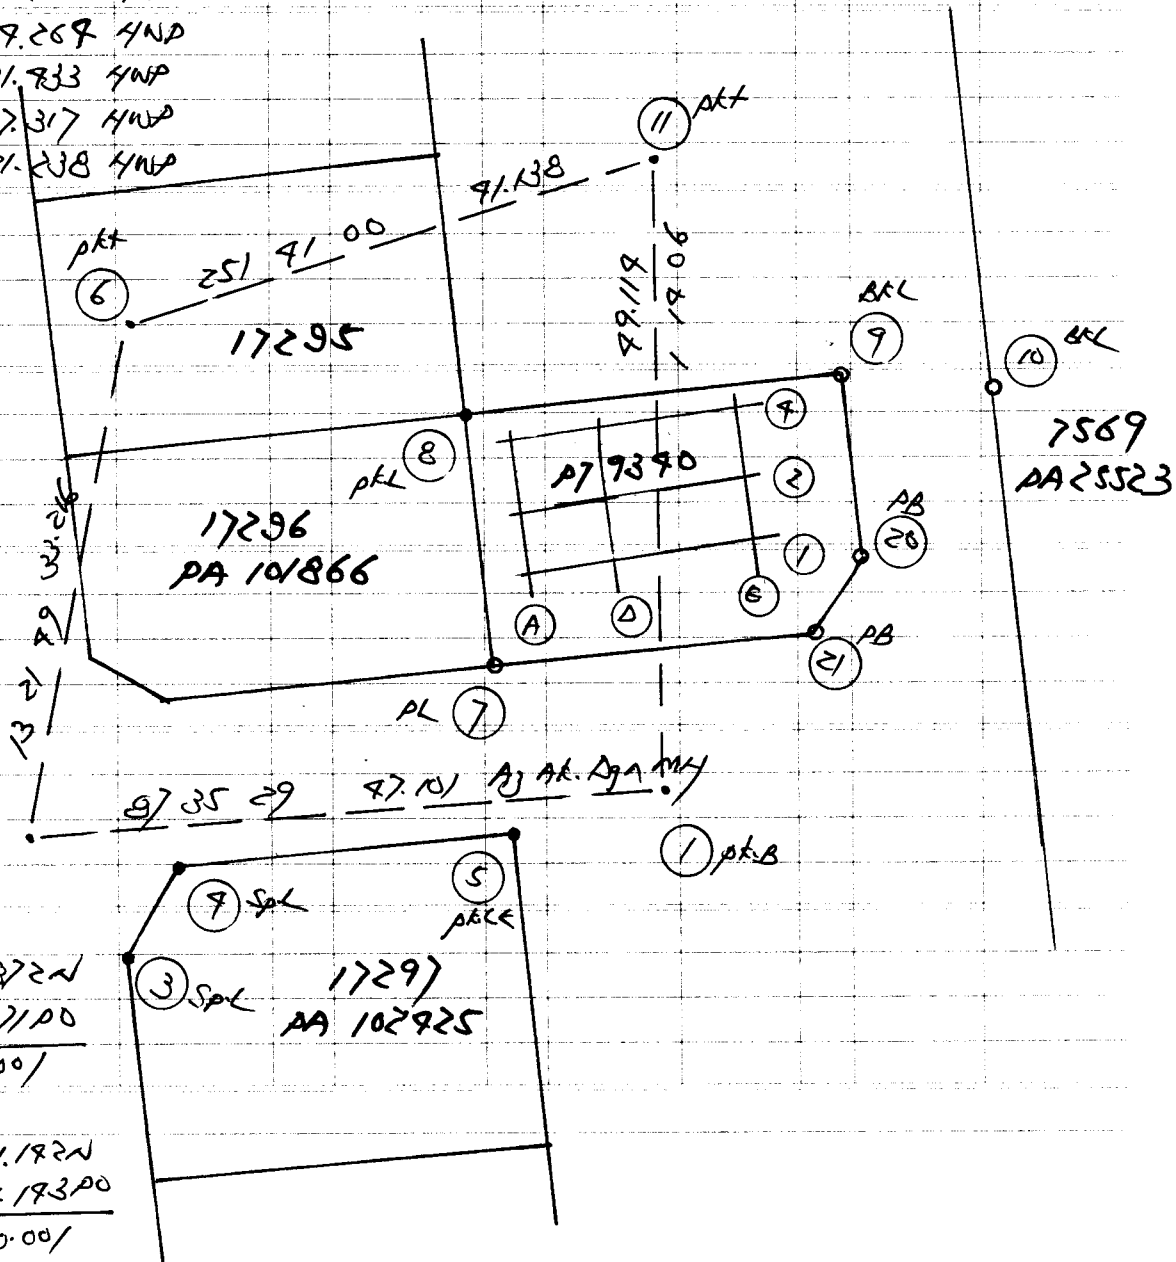

7-9 53 0057 62.8722 ✓
53 0102 62.87100

-5" +0.00/

7-8 32 28 56 91.182N
32 28 92 91.193P0

+19" -0.00/