

D. J20995 Putra Hills

No. Fail

Rajah di muka


Stasiun	BEARING SUDUT			Dari Sta	GARISAN		Ke Sta	Sudut Pukak (°)	Jarak	Subj	Jarak Antara Stasiun	Jarak Muktamat
	Pem. lang. Kiri	Pem. lang. Kanan	Putra		Bearing Muktamat							
	Datum Daripada			3	271 03 03	2	4		50.526			50.526
3	271 03 30	91 03 30	89 36 18	3	89 36 18	20	4		56.876			56.876
20	89 36 18 289 36 18											
	pt-B											
3	289 36 18	89 36 18	65 31 50	20	65 31 50	21	4		33.762			33.762
20	21 65 31 50 295 31 50											
	pt-B											
3	Sports Di Atas		90 32 46	20	90 32 46	22	4		29.839			29.839
20	22 90 32 46 270 32 46											
20-23	99 49 29			20	99 49 29 23		4		19.925	BKL		19.925
20-29	75 15 28			20	75 15 28 29		4		32.289	BKL		32.289
22-25	115 49 41			22	115 49 41 25		4		31.269	BKL		31.269
22-26	129 20 37			22	129 20 37 26		4		29.127	BKL		29.127
22-27	160 52 55			22	160 52 55 27		4		30.897	BKL		30.897

No. Fail

Rajah di muka

Stesen	BEARING / SUDUT			Dari Stn	GARISAN Bearing Muklamar	Ke Stn	Sudut Pukak (*)	Jarak	Sudut	Jarak Antara Tupang	Jarak Muklamar
	Penyilang Kiri	Penyilang Kanan	Purata								

DAERAH PETALING.
MUKIM SUNGAI BUCHAH
TANPA SKALA

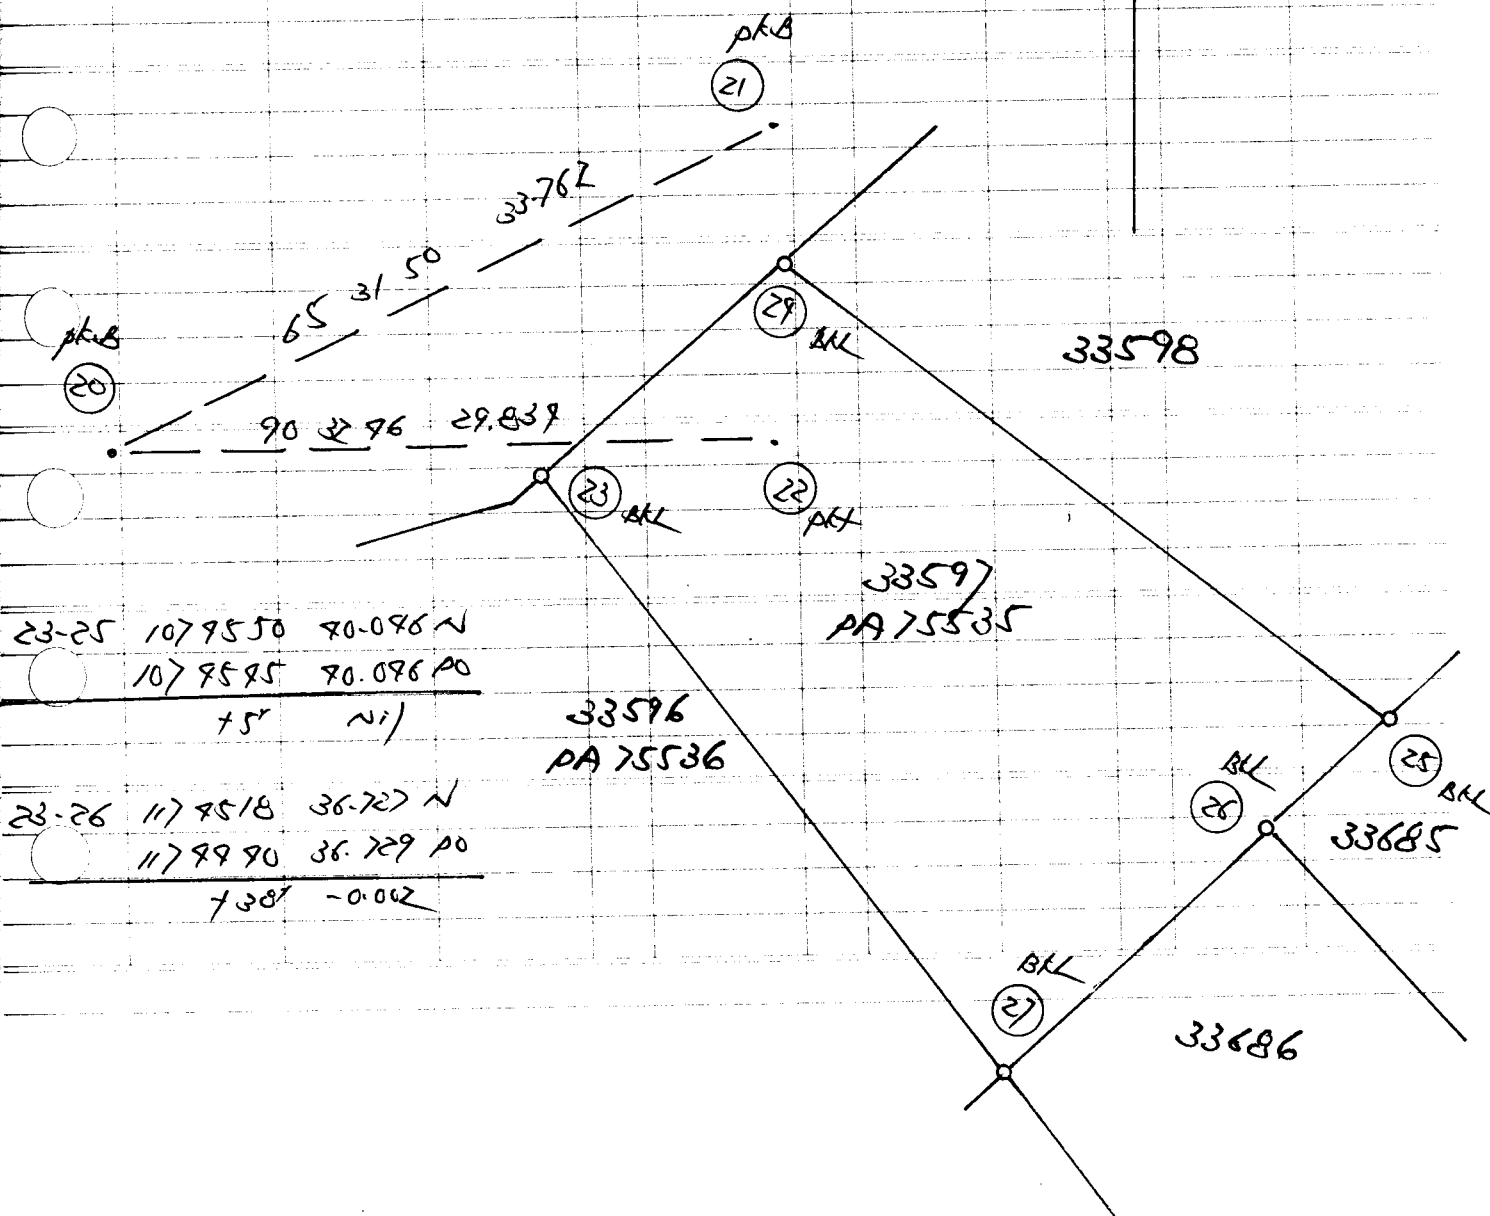

Tarikh Aras

Dibuat untuk

TBM F2222
24

Daripada VZS098 Putra 11/15.

Ke

Pandangan Belakang	Pandangan Antara	Pandangan Hadapan	Naik	Turun	Aras Yang Dilaras	Jarak	Catitan
2.823	(1926)				62.586	TBM F1908	Aku Longkong R: 62.586m
	1.508	(985)			63.911	F3	
0.297	(1097)	2.787	(19.01)		62.672	F201/F2001 / F20	
	1.958	(978)			61.511	TBM F2222	Aku Longkong.
0.912	(1155)	2.117	(7.18)		60.792	F2003	1/F21
	1.911	(6.27)			59.353	TBM F2223	Aku Longkong tapi PA.
		1.889	(6.07)		59.7 59.915		
3.592		6.783					By the right based on BM 82183