

No. Fail JZ 116 W Sekia tarik Lot 45992 & 45993


No. Fail

Rajah di muka

[illegible]

No. Fail

Rajah di muka

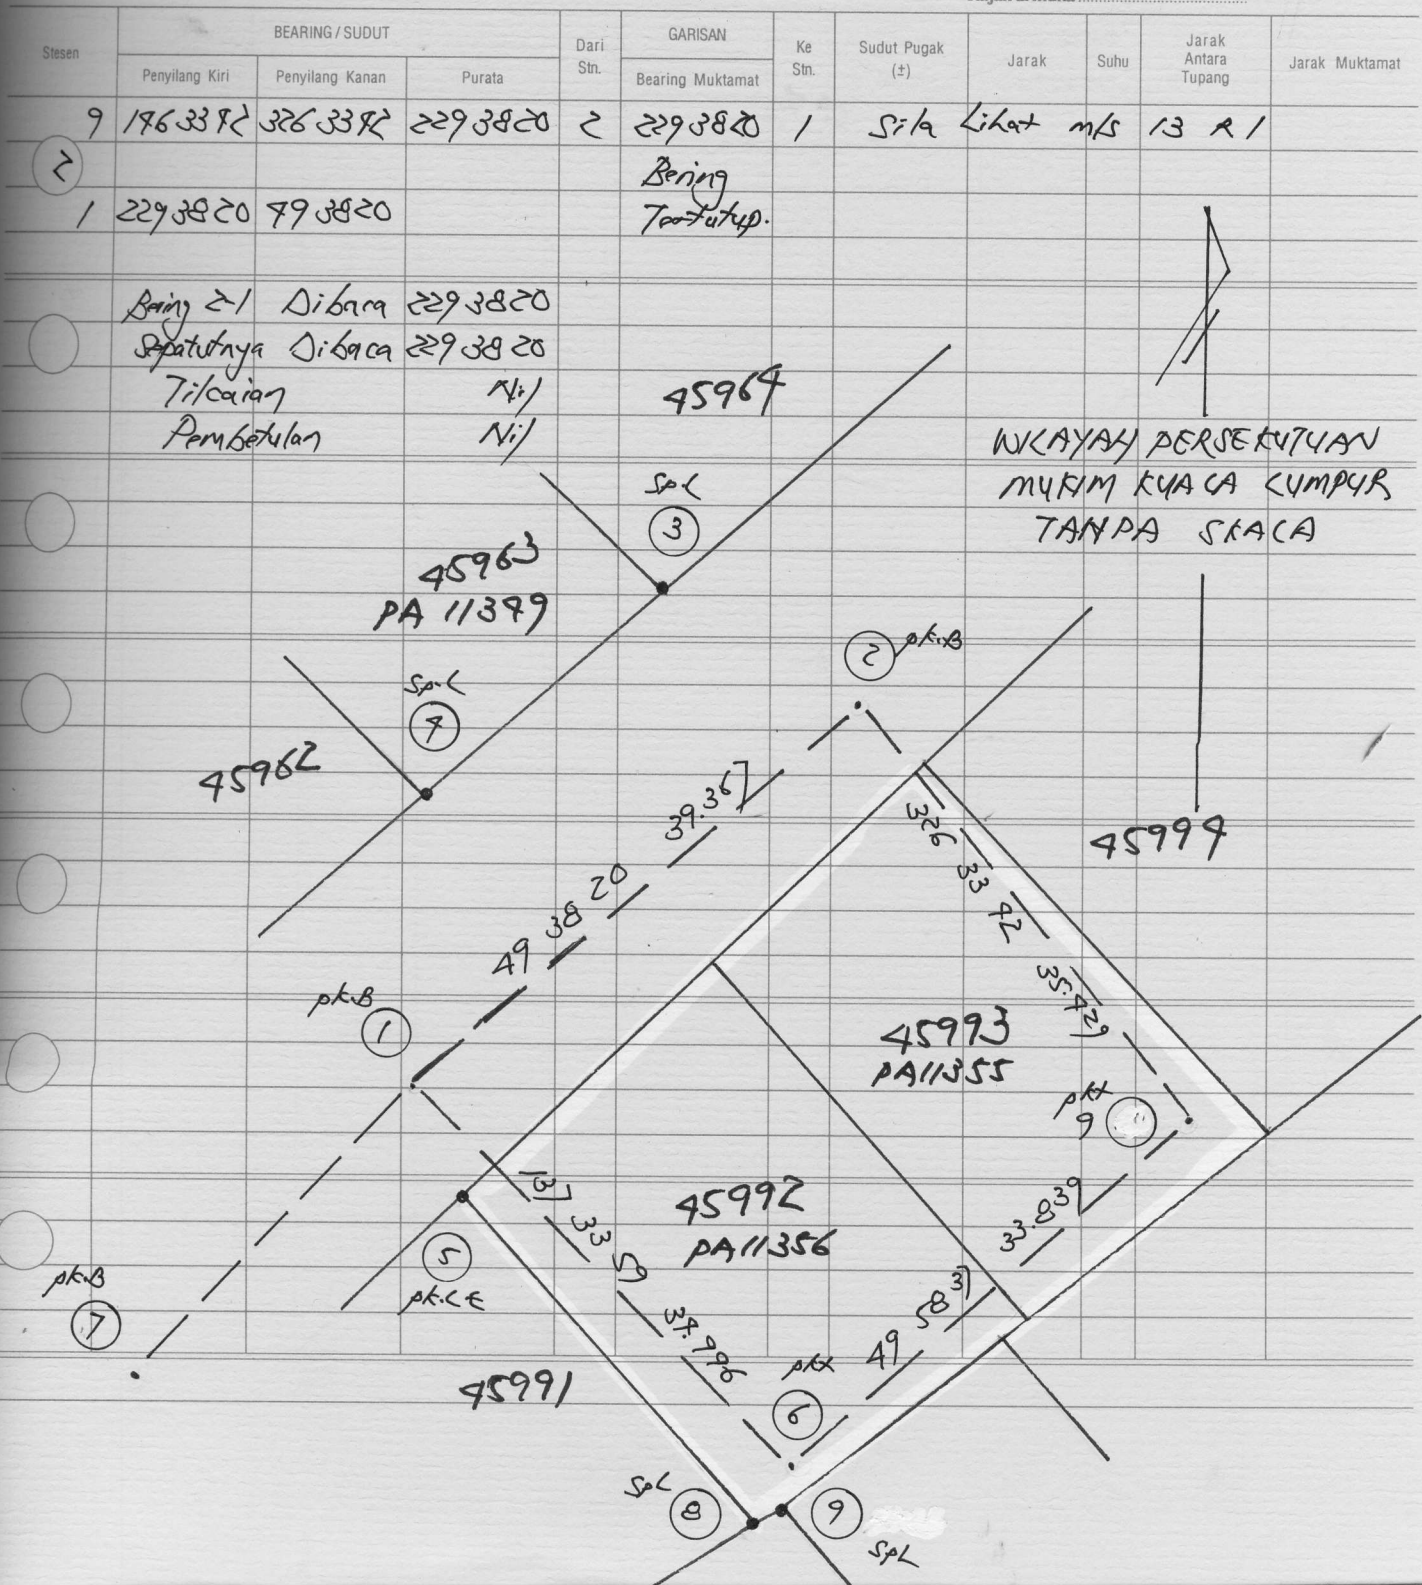

Tarikh 07/10/2019
 Daripada 07/2 1160

Dibuat untuk 47

Ke

Pandangan Belakang	Pandangan Antara	Pandangan Hadapan	Naik	Turun	Aras Yang Dilaras	Jarak	Catitan
0.870	(1285)	0.387 (112)			86.989	78m F2233	Ahu Longkong (pt.8)
		1.950 (16.90)			85.859	F2	
0.618	(12.4)	3.309 (10.88)			84.500	F1	
	0.251 (10.82)	3.351 (10.99)			84.863	78m F22318	Hypert
1.889		6.660			81.783	CP1	
0.297	(0.97)	3.37.			81.783	CP1	
8.100	(10.33)	3.333					
0.857	(11.50)	3.333					
1.909	(8.62)	2.392			73.557		
	1.263 (8.19)				73.783	Ahu mly	
	1.335 (8.34)				73.631	STN Kang	
2.283	2.283 (7.36)				72.723	78m F2233	RC: 72.723 78m /
	1.889 / 1.883						ASM 1160

All the heights based on
 BM W0062