

Rajah di muka

[illegible]

Offset Building (Furniture Store).

9-20 7 2755 7.589

9-21 792800 13.781

15-22 307 1680 80-290

Offset Handling

15-23 283 52 75 30.38

15-27 290 12 14 32.717

15	25	300	39	18	39	777
----	----	-----	----	----	----	-----

15-26 306 31 1/ 37.527.

Armarate

9-30 39 7935 6.012 AB
 9-31 36 0339 9.070 AB (Rm)
~~9-32~~
 15-32 300 2708 33.896 AB (Rm)
 15-33 18 5957 5.722 AB
 15-34 209 5331 1.028 AB
 15-35 205 3825 7.773 AB.

4-10 288 7555 25.950 N
 288 7629 25.951 PO


 +26' -0.001

4-13 319 3856 22.909 N
 319 3807 22.919 PO

 +49' -0.005

4-8 236 2820 31.817 N
 236 2827 31.820 PO

 -11' -0.003

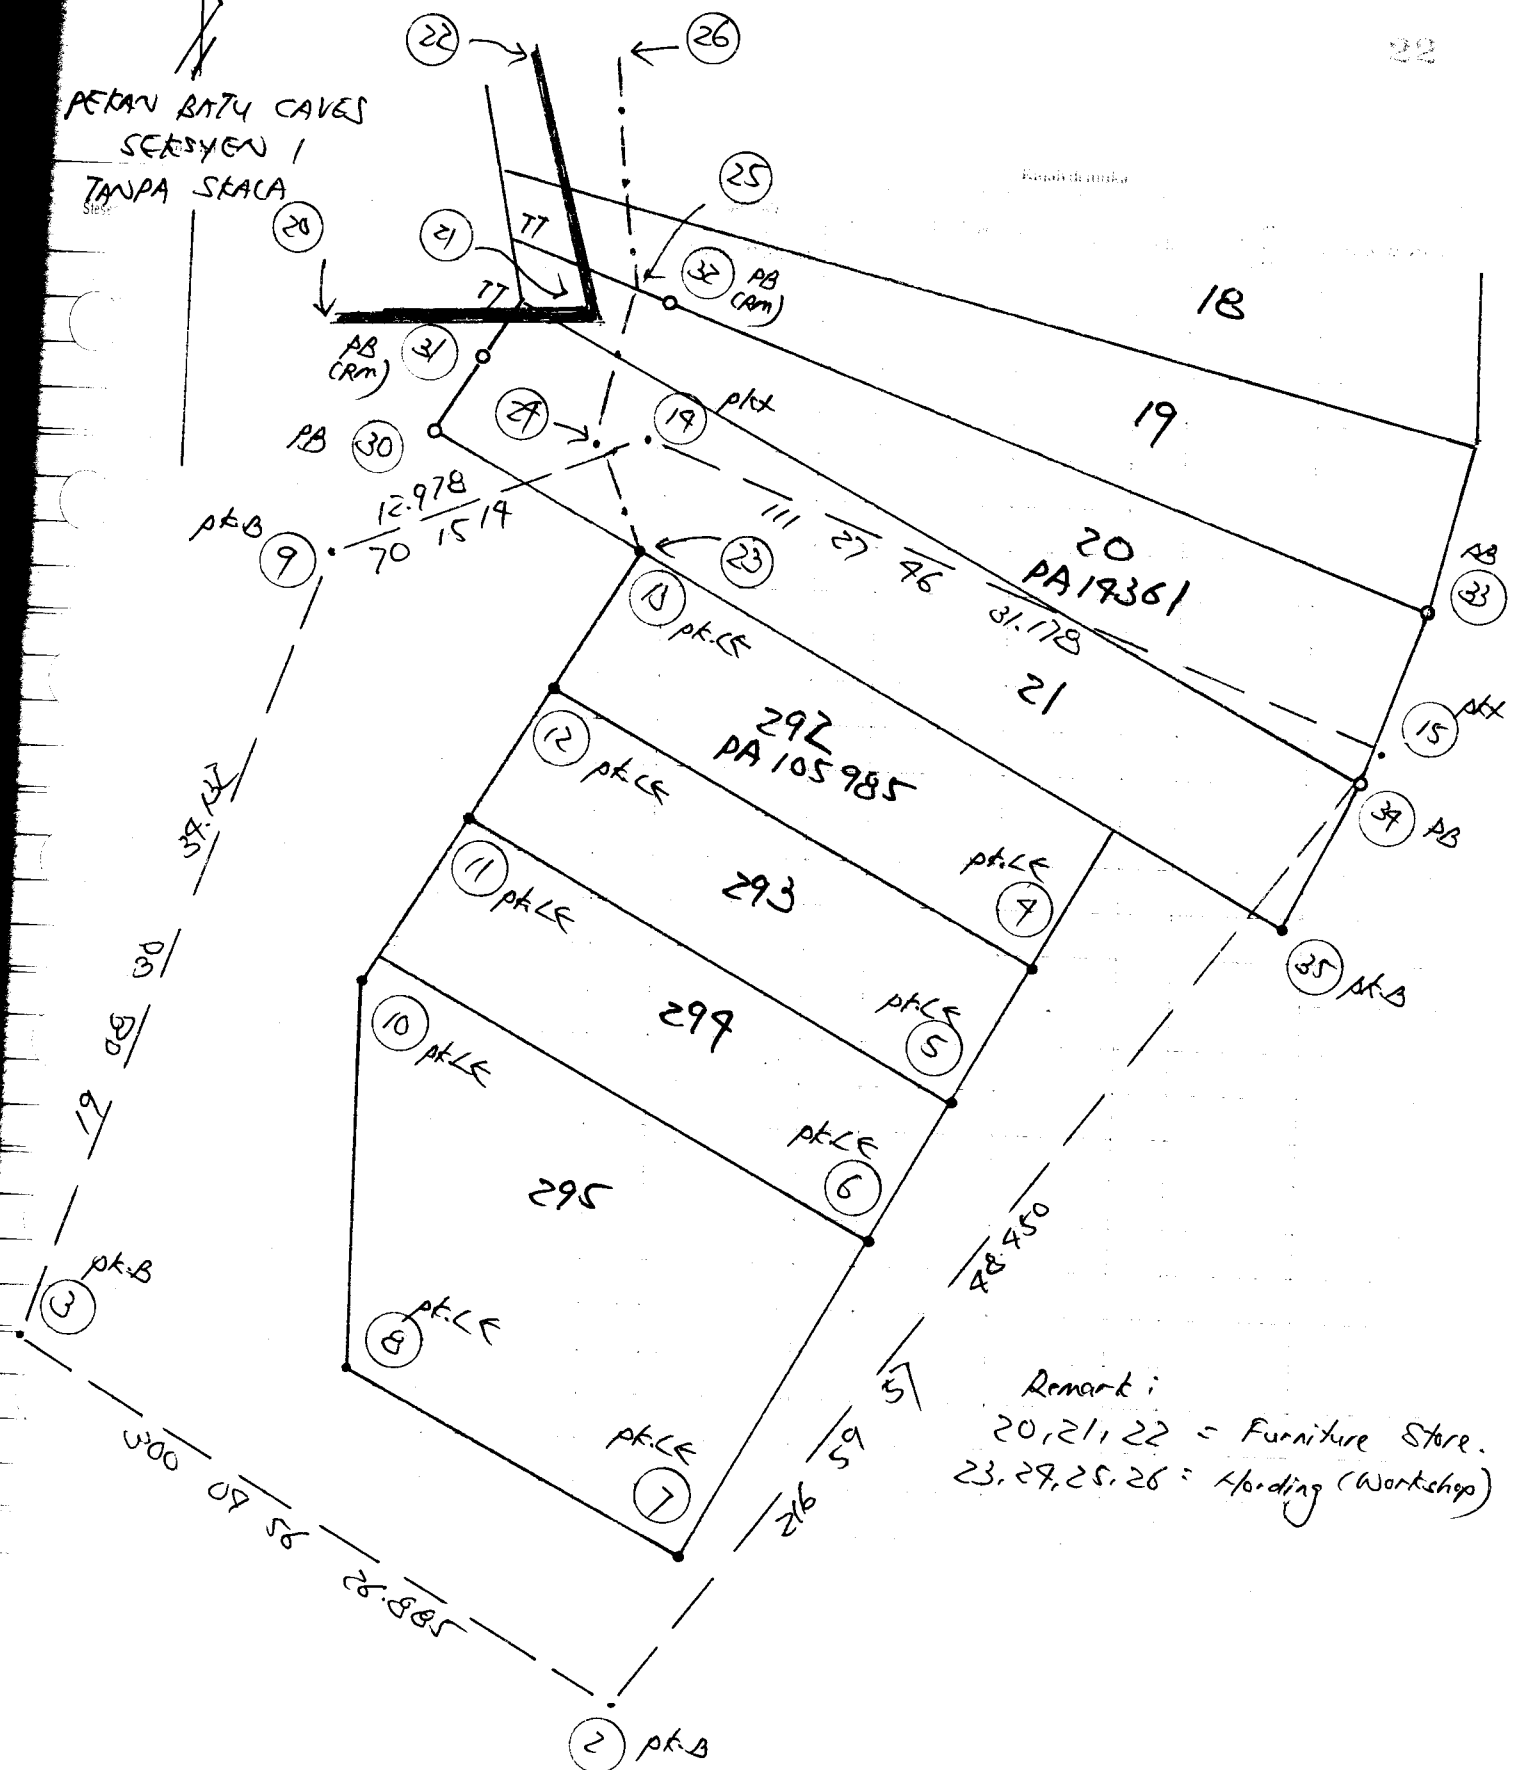

Remark:
20, 21, 22 = Furniture Store.
23, 24, 25, 26 = Hording (Workshop)