

JE/S/S Sayana Aq/m View.

No. Lab

Kaschidim

8/10/2003

Datum Saypacte.

2 102 0638 1 H
pk A3 Ak. pk LK
Dgn my

99.233

99.233

1 102 0638 282 0638 173 3153 2 173 3153 3 H 39.03/

39.03/

2
3 173 3153 353 3153
pk B

2-4 139 3820

2 139 3820 4 H

29.639

BKL

29.639

2-5 206 3916

2 206 3916 5 H

15.077

pk L

15.077

2-6 322 1925

2 322 1925 6 H

8.739

pk L

8.739

3-7 190 3859

3 190 3859 7 H

73.751

pk-B (RM)

73.751

3-8 71 5538

3 71 5538 8 H

29.906

TBM

29.906

3-9 66 1922

3 66 1922 9 H

59.903

pk-B (RM)

59.903

Dmar rate.

2-10 189 9638

2 189 9638 10 H

39.908

pk-B

39.908


2-11 56 0501

2 56 0501 11 H

20.503

AB

20.503

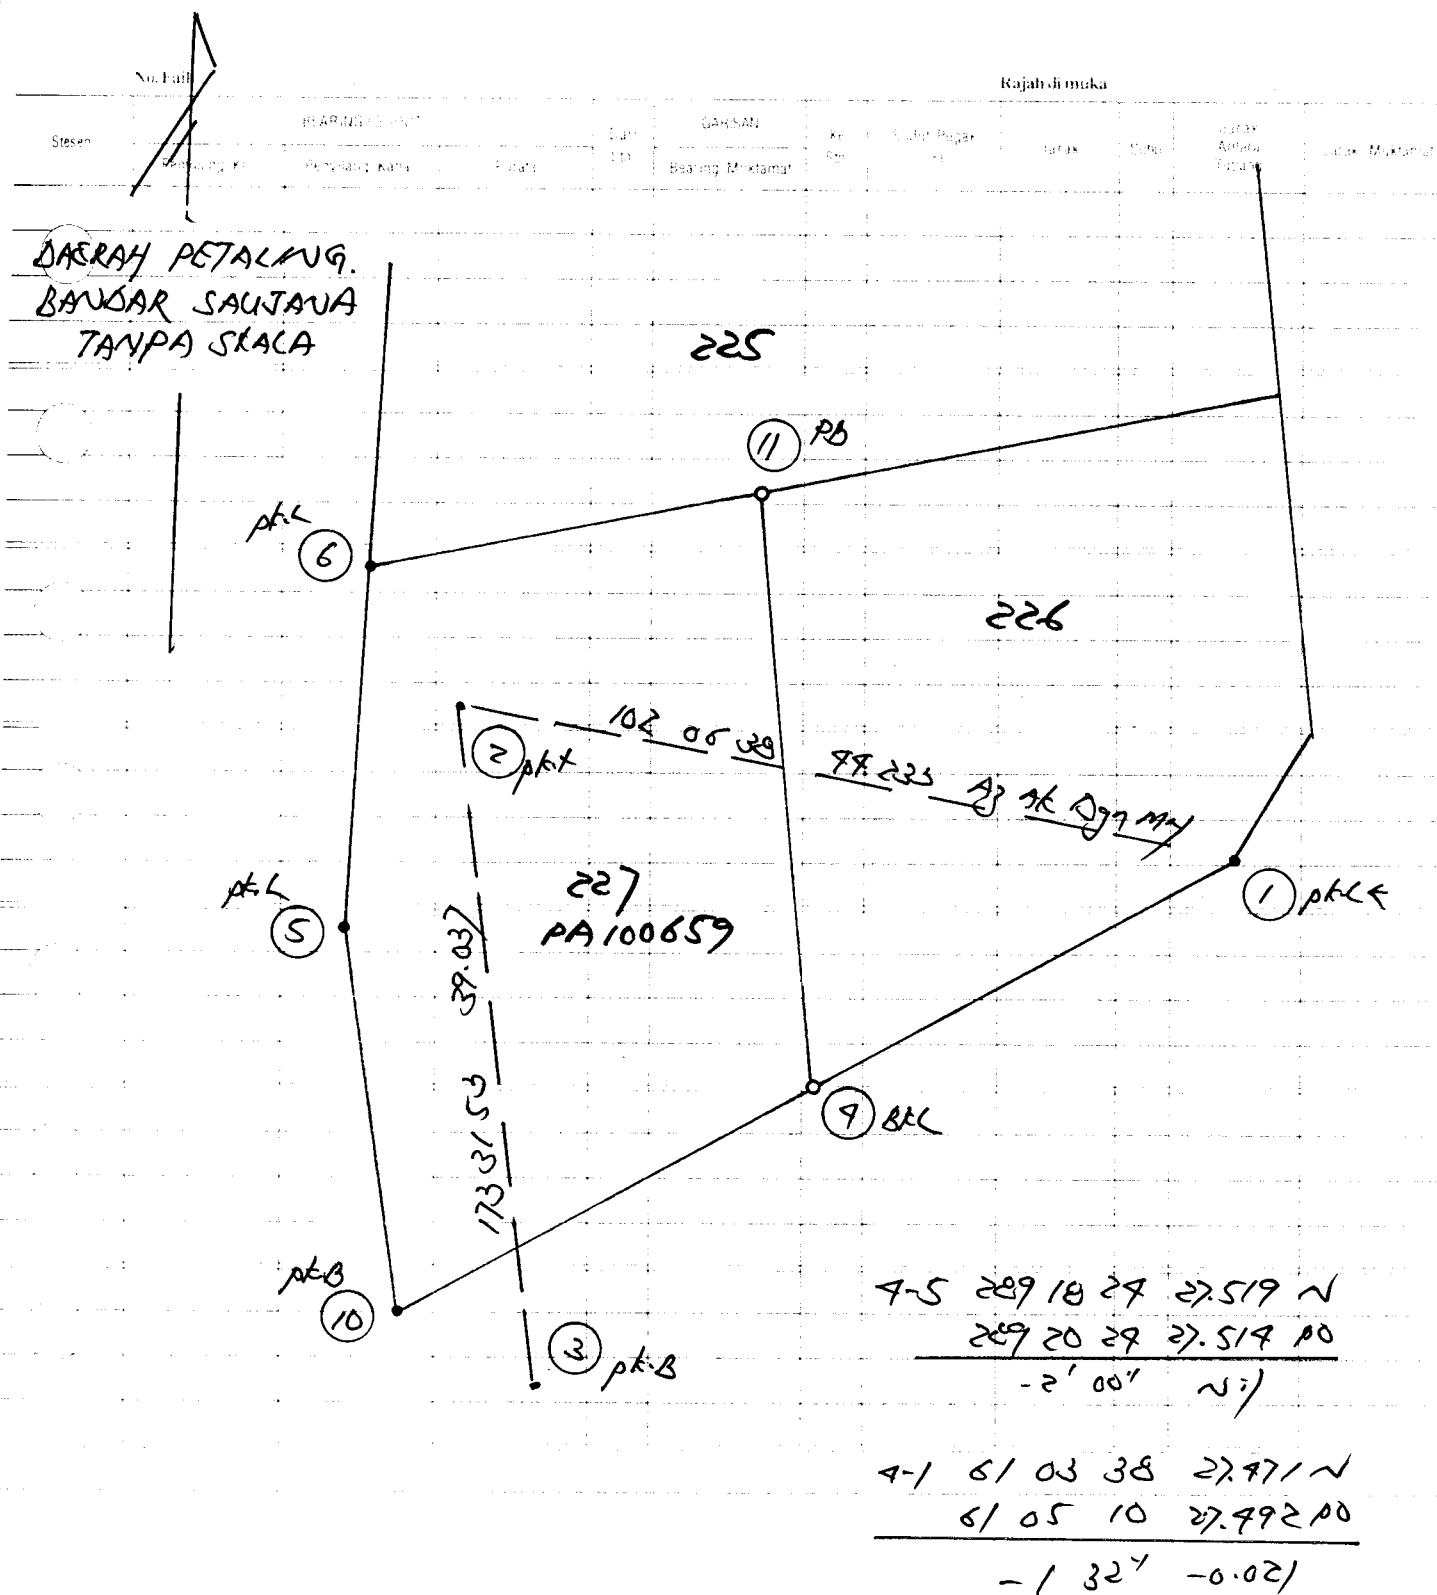

30

.....**Ke**

Pandangan Belakang	Pandangan Antara	Pandangan Hadapan	Naik	Turun	Aras Yang Dilaras	Jarak	Catitan
1.153 (1378)	1.497 (1475) 0.763 (223)	0.986 (317)			79.098 78.809 79.598 79.285	BM F2220 F1120 BM F2221 F2	BM B2131 GAS Level : 22700m BM Level : 22802m constant - 0.002
							BM F2. GPS Level : 79.183m constant + 0.102 79.285m