


No. Fail J2261 Planter Haven.

Rajah di muka _____

Stesen	BEARING / SUDUT			Dari Stn.	GARISAN	Ke Stn.	Sudut Pukak ($\pm$)	Jarak	Suhu	Jarak Antara Pukang	Jarak Mukamat
	Penyilang Kiri	Penyilang Kanan	Purata		Bearing Mukamat						
	Datum	Danjada		2	23 53 29 A3 Ak. Dgn MY	1	4	79.012			79.012
2-3	208 30 31			2	208 30 31	3	4	52.359		BAL	52.359
2-4	222 10 55			2	222 10 55	4	4	30.990		BAL	30.990
2-5	0 29 21			2	0 29 21	5	4	49.700		BAL	49.700
2-6	15 02 13			2	15 02 13	6	4	72.589		BAL	72.589
2	203 53 29	23 53 29	395 29 33	1	395 29 33	7	4	112.576			112.576
1											
7	395 29 33	165 29 33									
	pk										
1-8	293 57 31			1	293 57 31	8	4	21.937		7BM	21.937
1-9	67 47 19			1	67 47 19	9	4	22.169		7BM	22.169
1-10	120 13 02			1	120 13 02	10	4	18.679		RM	18.679
7-11	31 43 44			7	31 43 44	11	4	27.989		PL	27.989
7-12	30 51 46			7	30 51 46	12	4	21.826		PL	21.826
7-13	216 16 25			7	216 16 25	13	4	57.262		AB	57.262
1-14	329 39 09			1	329 39 09	14	4	10.373		AB	10.373
1-15	59 28 07			1	59 28 07	15	4	17.301		AB	17.301

No. Fail _____

Rajah di muka _____

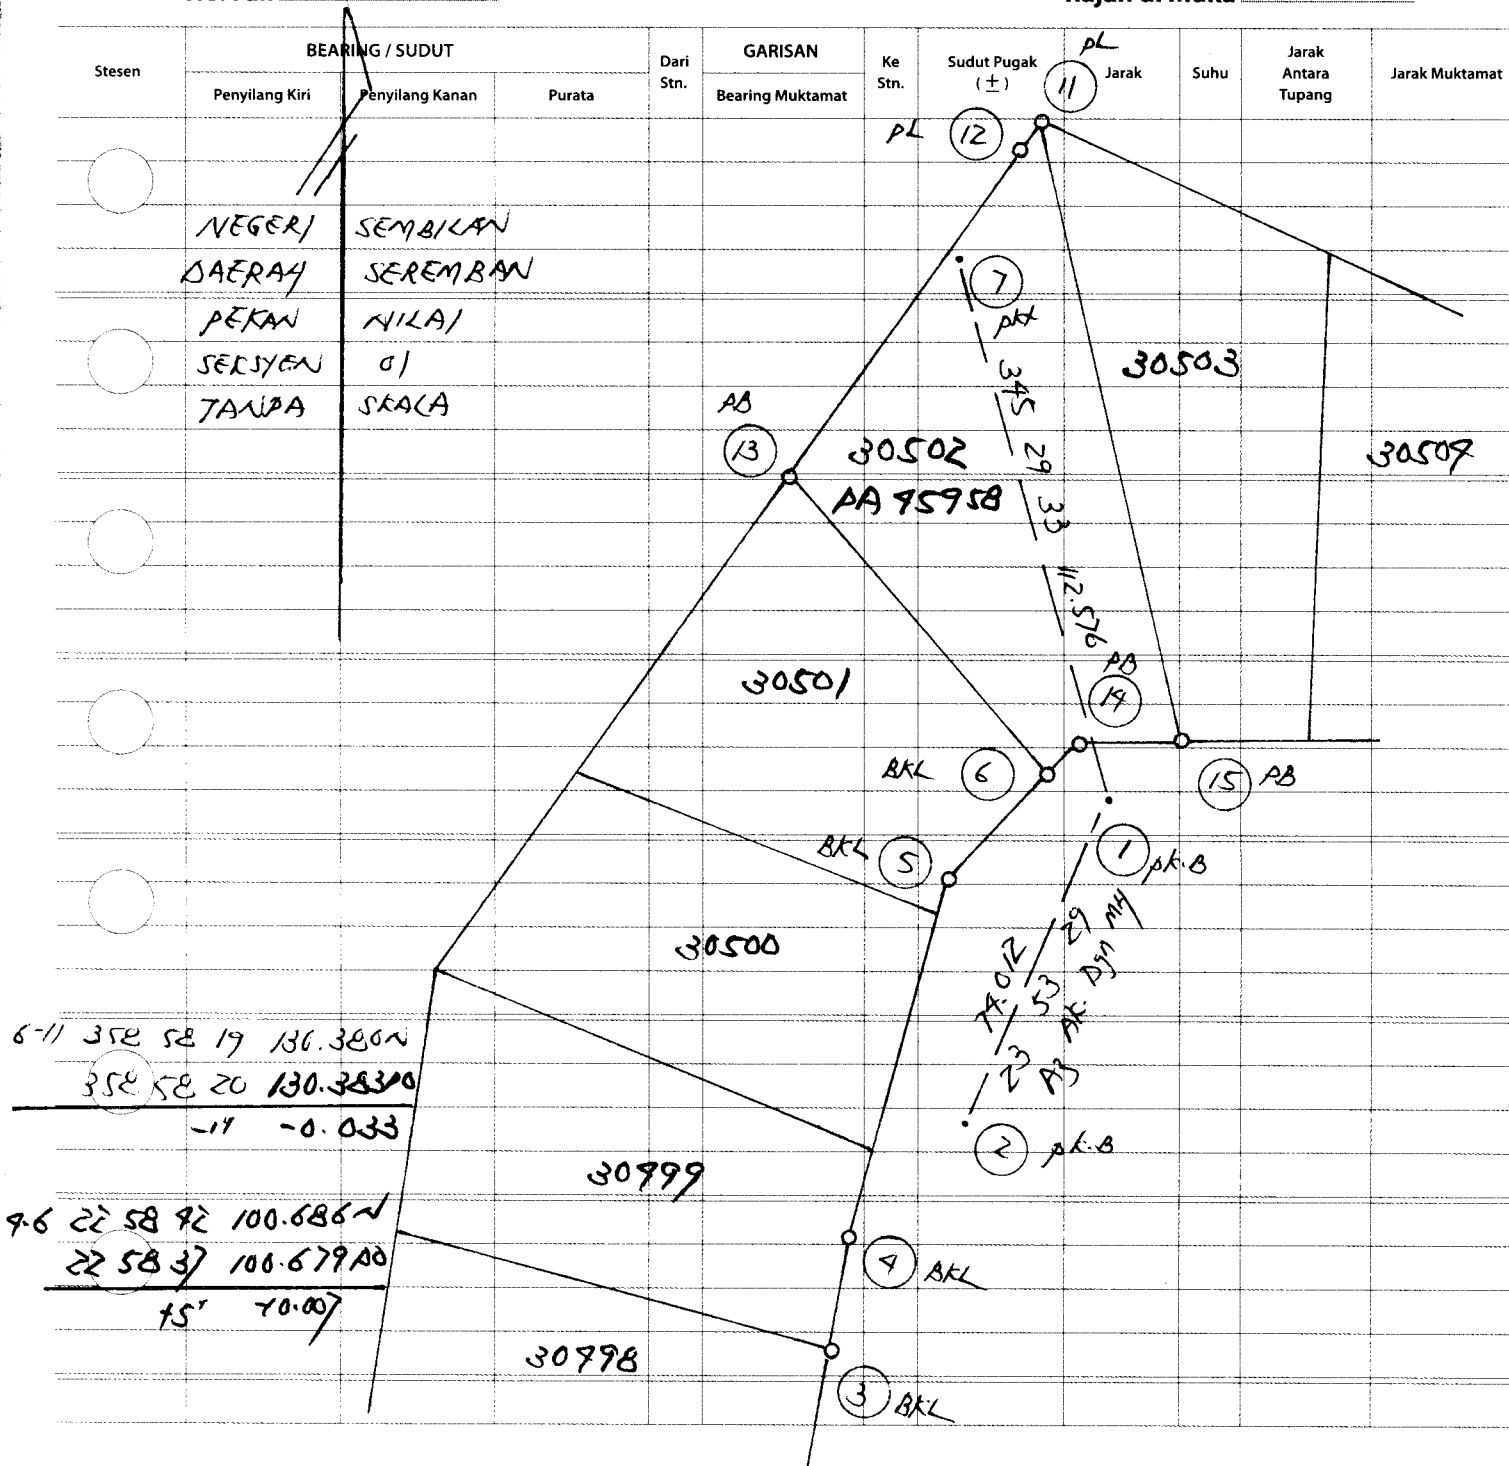

Client: JT 9/11/13
Date: Please Have Fun Almondg

Location

Purpose

[illegible]