

J2377 Bandar Botanic Ambang Botanic

Rajah di muka


SARAWAK		SARISAN		Ke Stn	Sudut Pukak (°)	Jarak	Suhu	Jarak Antara Tupang	Jarak Muktamad
Daerah	Daerah	Dari Stn	Bearing Muktamad						
Datum Daripada		2	89 85 22	1	4	86.275	18/9/17		86.275
2-3	289 20 39	2	289 20 39	3	4	81.286		BKL	81.286
2-7	85 06 06	2	85 06 06	7	4	107.753		BKL	107.753
1-5	27 00 26	1	27 00 26	5	4	96.359		BKL	96.359
1-7	189 97 53	1	189 97 53	7	4	31.089		BKL	31.089
1-8	159 29 23	1	159 29 23	8	4	73.031		BKL	73.031
1-9	156 09 06	1	156 09 06	9	4	95.212		BKL	95.212
1-10	171 16 57	1	171 16 57	10	4	66.167		BKL	66.167

No. 1.111

Kajah di muka

Stasiun	Bearing Sudut	Pelata	Dari Sisi	Uraian	Ke	Sudut Bujur	Uraian	Sudut	Uraian
Stasiun	Stasiun dan Kiri	Bearing Kanan	Pelata	Dari Sisi	Bearing Muka	Ke	Sudut Bujur	Uraian	Sudut

DAERAH KLANG.
MUKIM KLANG.
TANPA SKALA

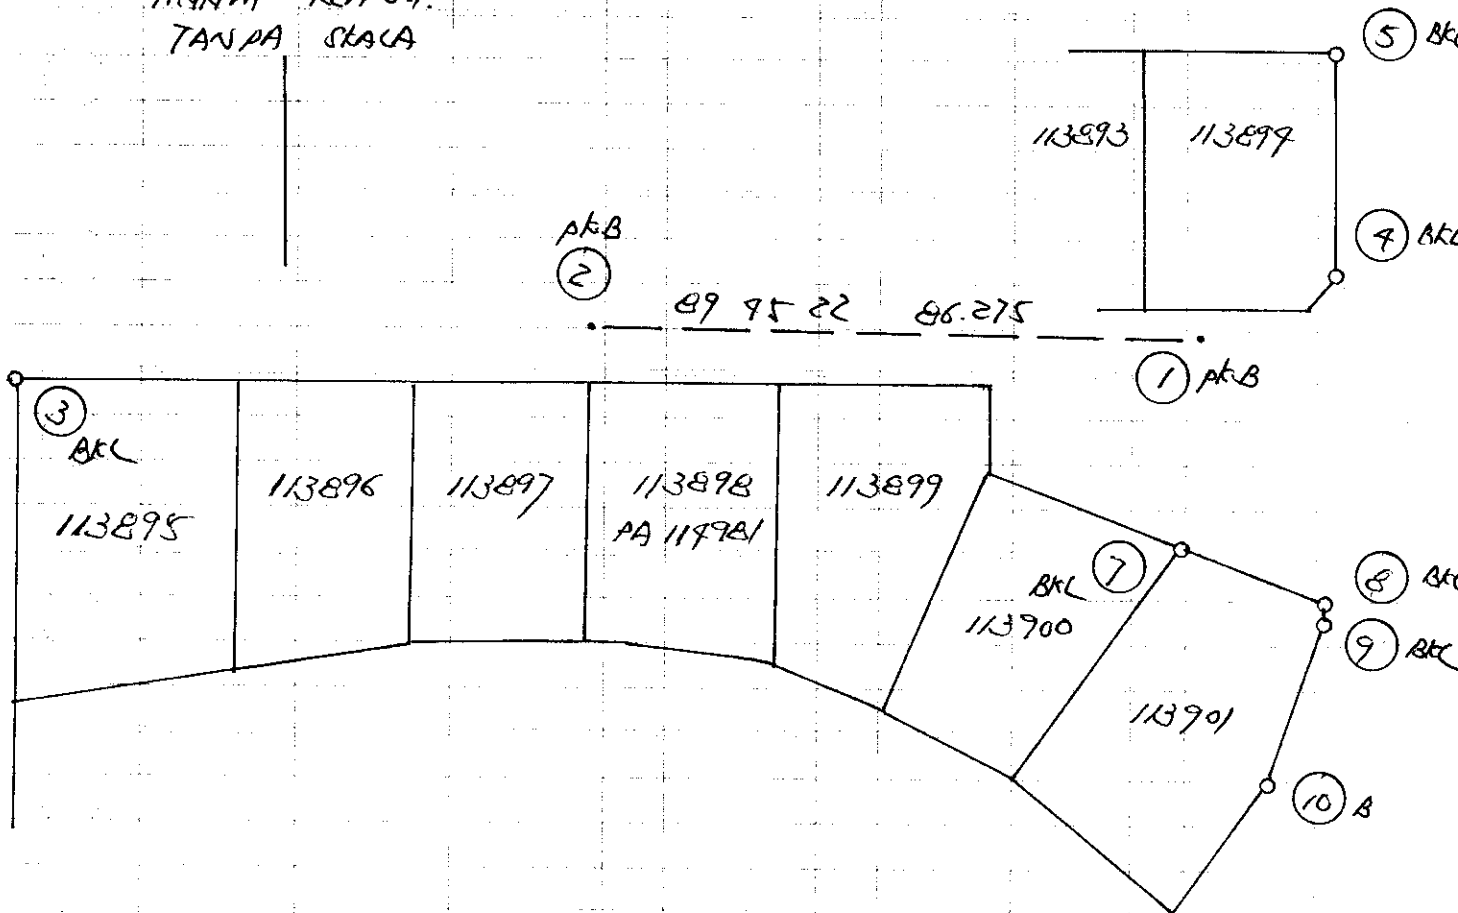

3-7 89 4633 189.035 N
89 4634 189.023 PO
Nil 70.012