

J2395 T/m Anjung

Datum Daripada

1 11 57 12 2 H

51.667

17/4/17

51.667

2 11 57 12 25 57 12 278 03 22 / 278 03 22 20 H

89

86.939

86.939

20 278 03 22 98 03 22

pt.B

1 98 03 22 278 03 22 262 13 30 20 262 13 30 21 H

50.333

50.333

20

21 262 13 30 22 13 30

pt.B.

21-22 5 09 59 185 09 59

21 1 5 09 59 22 H

52.241 7BM F

52.241

21-23 282 39 36 102 39 36

21 282 39 36 23 H

56.977 7BM F

56.977

21-29 399 46 59 169 46 59

21 399 46 59 29 H

51.899 BKL

51.899

21-25 333 17 39 153 17 39

21 333 17 39 25 H

67.718 BKL

67.718

21-26 295 58 11 115 58 11

21 295 58 11 26 H

52.698 BKL

52.698

21-27 301 52 01 121 52 01

21 301 52 01 27 H

31.367 BKL

31.367

21-28 310 30 21 130 30 21

21 310 30 21 28 H

23.919 BKL

23.919

21-29 330 52 10 130 52 10

21 330 52 10 29 H

23.329 BKL

23.329

No. 122

Rajah di muka

Lot 122

Lot 122

Ke


Lot 122

Lot 122

Lot 122



DAERAH PETALING
MYKIM DAMANSARA
TANPA SKACA

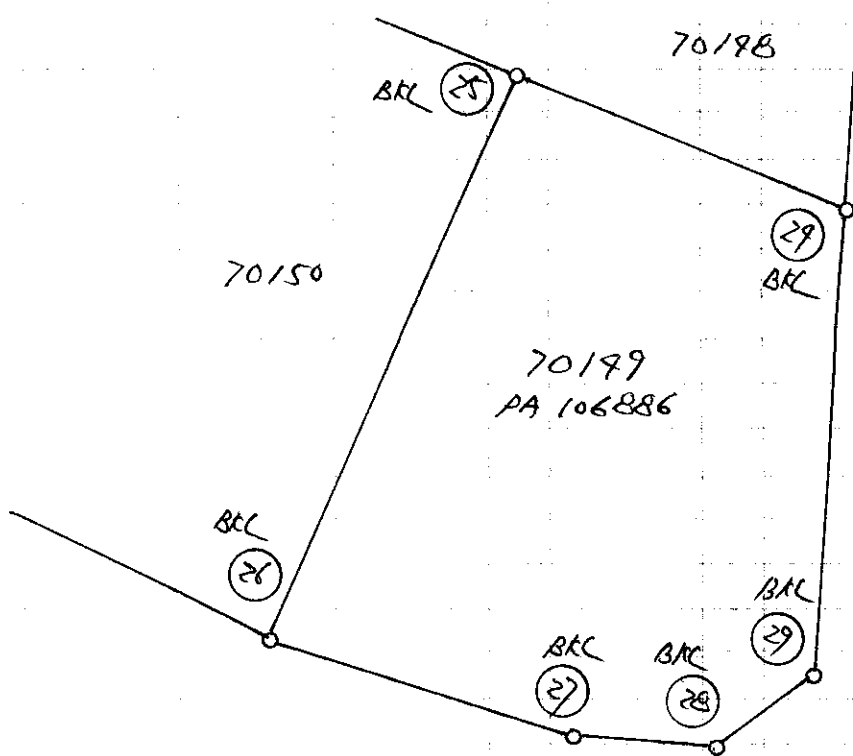

25-28	169 2503	97.010 N
	169 2506	96.995 PO
31	70.015	

28-26	289 5390	30.599 N
	289 5392	30.611 PO
-21	-0.012	

		50.333
	282	13 30
(21)		
pk.B		

Purpose

Gen No	Upper Wire	Middle Wire	Lower Wire	Vertical Angle + or -	Bearing	Inst. Ht.	RL of Station	To	From
	43.515	47.672						1.821 (18.13)	2.978 (18.13)
	47.279	45.089						1.719 (15.82)	2.059 (16.25)
	46.329 -							0.885 (12.90)	2.125 (18.97)
								3.853 -	6.662 -

[illegible]