

Registo di musica

READINGS		DATE		TIME		LOCATION		WIND		TEMP		PRESS		HUMID		VISIB		CLOUDS		REMARKS		
NO.	TIME	DATE	TIME	DATE	TIME	DATE	TIME	DATE	TIME	DATE	TIME	DATE	TIME	DATE	TIME	DATE	TIME	DATE	TIME	DATE	TIME	DATE


No. 10

Rapat di muka

10	1052200	2852200	2901317	11	2901317	3	4	35.157		35.157
"										
3	2901317	801317								
11	801317	2901317	1307	3	1307	1		Sila	Lihat m/s	21 R 2
3										
1	1307	181307								
1	1307	181307	1270733	3	1270733	12	4	67.920		67.920
3										
12	1270733	3070733								
12-13	370607			12	370607	13	4	9.502	pk.L	9.502
9-17	55995			9	55995	17	4	10.797	BAL	10.797

Demarcate.

3-15	1081322			3	1081322	15	4	25.067	AB	25.067
3-16	611978			3	611978	16	4	17.137	pk.B	17.137
3-17	251690			3	251690	17	4	20.908	PB	20.908
1-18	1705721			1	1705721	18	4	22.597	PB	22.597

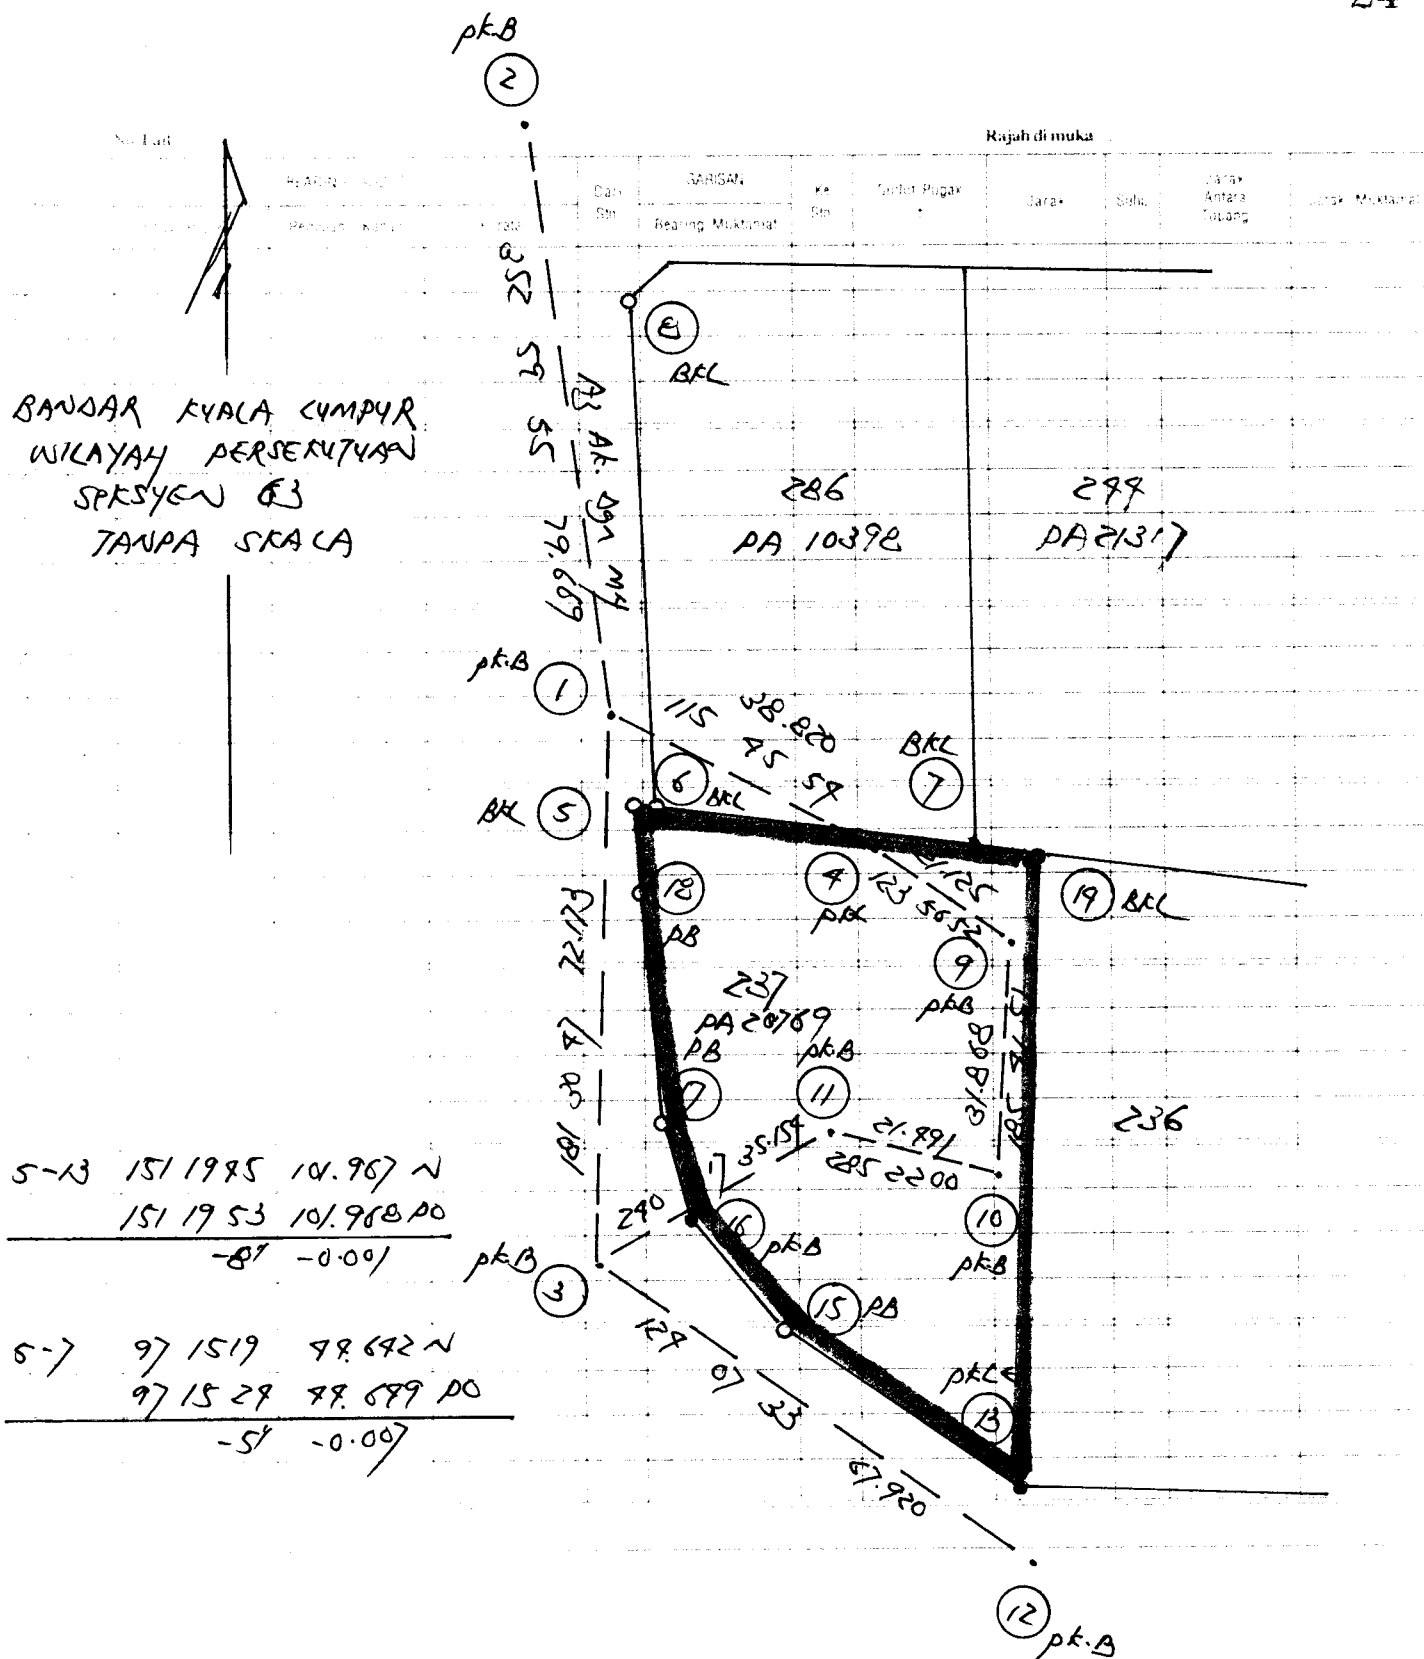

5237

Changkat Ksa Pans.

Location

Tom Kiser

53

Location

Purpose

[illegible]