


J2399 Data 4/11 Lot 33508

Datum Danpeta		2 270 9109	1	4	25/5/17	62.100	62.100
		pkB	pkB				
1	270 9109 90 9109 177 1598	2	177 1598	3	4	19.688	19.688
2							
3	177 15 98 357 1598						
	pkB						
2-4	95 275 1927	2	275 1927	7	4	76.11	BKL 76.11
2-5	53 2923	2	53 2923	5	4	72.352	BKL 72.352
2-6	151 0013	2	151 0013	6	4	3.657	BKL 3.657
2-7	290 0739	2	290 0739	7	4	11.373	BKL 11.373
2	357 1598 177 1598 179 5737	3	179 5737	8	4	11.995	11.995
3							
8	179 57 37 357 5737						
	pkB						
3	357 5737 179 5737 189 5000	8	189 5000	9	4	25.299	25.299
8							
9	189 5000 950 00						
	pkB						
9-10	66 4593	9	66 4593	10	4	33.970	BKL 33.970
9-11	68 5233	9	68 5233	11	4	32.996	pkB (RM) 32.996
9-12	287 1320	9	287 1320	12	4	39.773	pkB (RM) 39.773
Demarcate.							
9-13	337 9137	9	337 9137	13	4	17.607	AB 17.607

DAERAH DETALING.
MUKIM SYUGAI BULUH
TANPA SKAKA

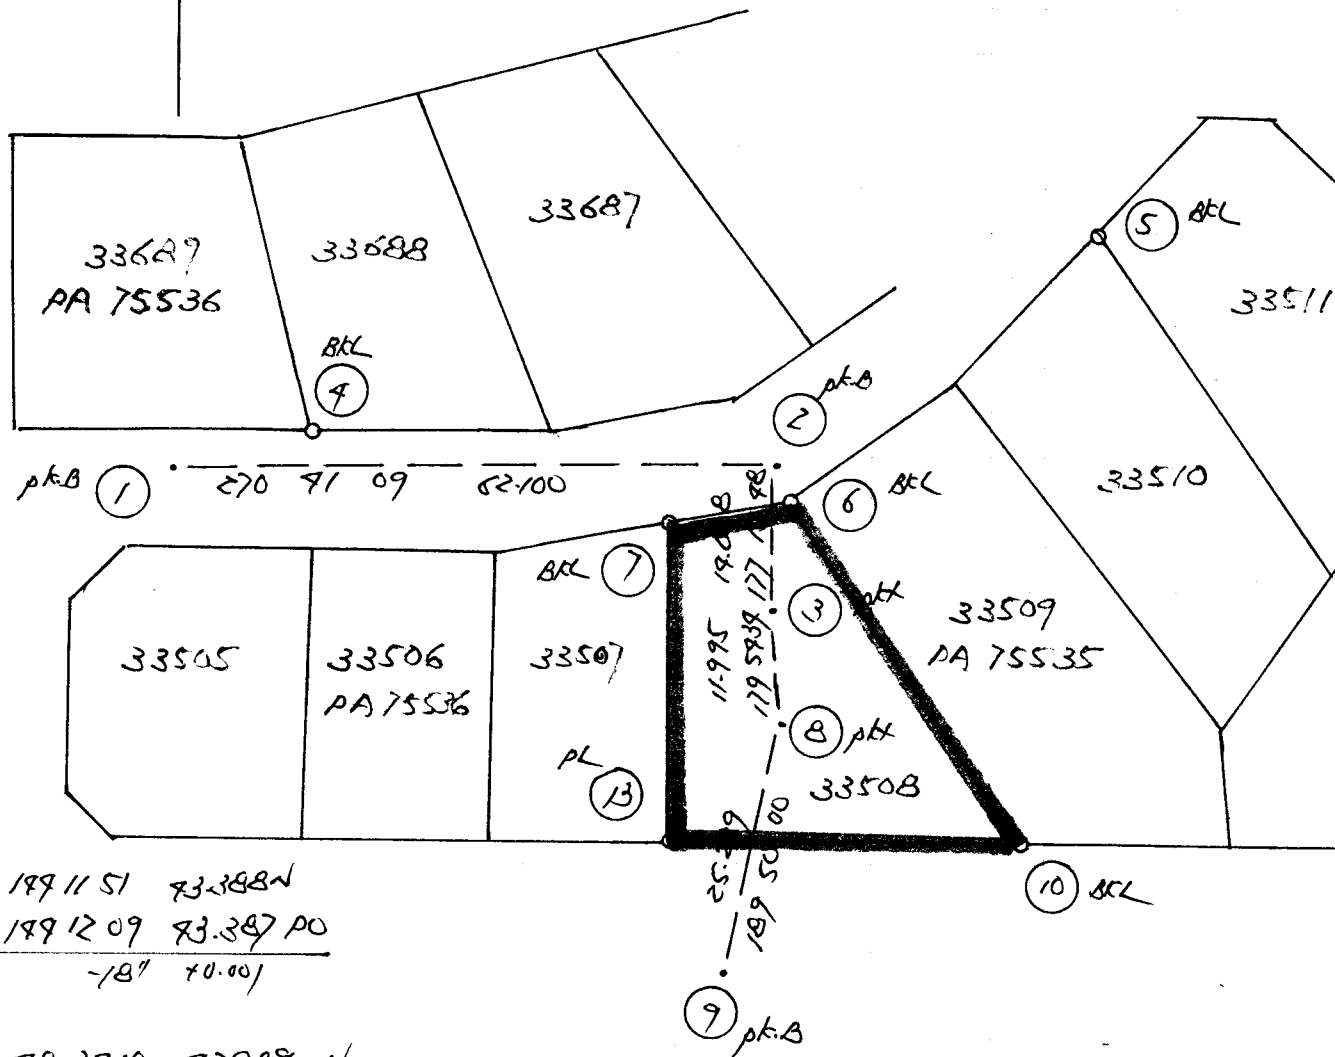

6-10 1891151 73.388N
1891209 73.387 PO
-18" +0.001

6-5 783910 72989 N
783908 72.991 PO
+2" -0.002

J2398

Client
Date *After 4/1/1* lot 33508

54

Location
Purpose

From	To	RL of Station	Inst. Ht.	Bearing	Vertical Angle + or -	Lower Wire	Middle Wire	Upper Wire	Gen. No.
1.9944						71.210			
	1.3785					71.8279			
	1.6389					71.5655			
	2.7433					70.461			
		4.2079				68.9965			

Horiz. Dist.	Ht. Diff. + or -	RL of Inst.	RL Centre Reading	m	RL Object	Remarks
GPS						BM 85426
78m	13128	(Hydant)				GPS level : 30.477
F1109						BM level : 30.435
FE						40.092
78m	13129	(chain)				

Level on GPS
GPS level : 71.252m
constant : -0.042
71.210