

No. Laili J2396 Bk Gasig.

Rapi di muka

30/4/18

Datun Danipada

2 1751202 1 H
pkB A3 Ak. pkB
Dgn 925

178.270

178.270

1 1751202 3551202 789028 2 789028 3 H

78.050

78.050

2

3 789028 2589028

pk-B

2-4 929620

2 929620 4 H

13.270

BKL

13.270

2-5 559390

2 559390 5 H

15.590

pk-L

15.590

3-6 1169790

3 1169790 6 H

21.690

Sp-L

21.690

3-7 972830

3 972830 7 H

20.270


BKL

20.270



Rajah di muka

TOWN OF AJ
DISTRICT OF AJ

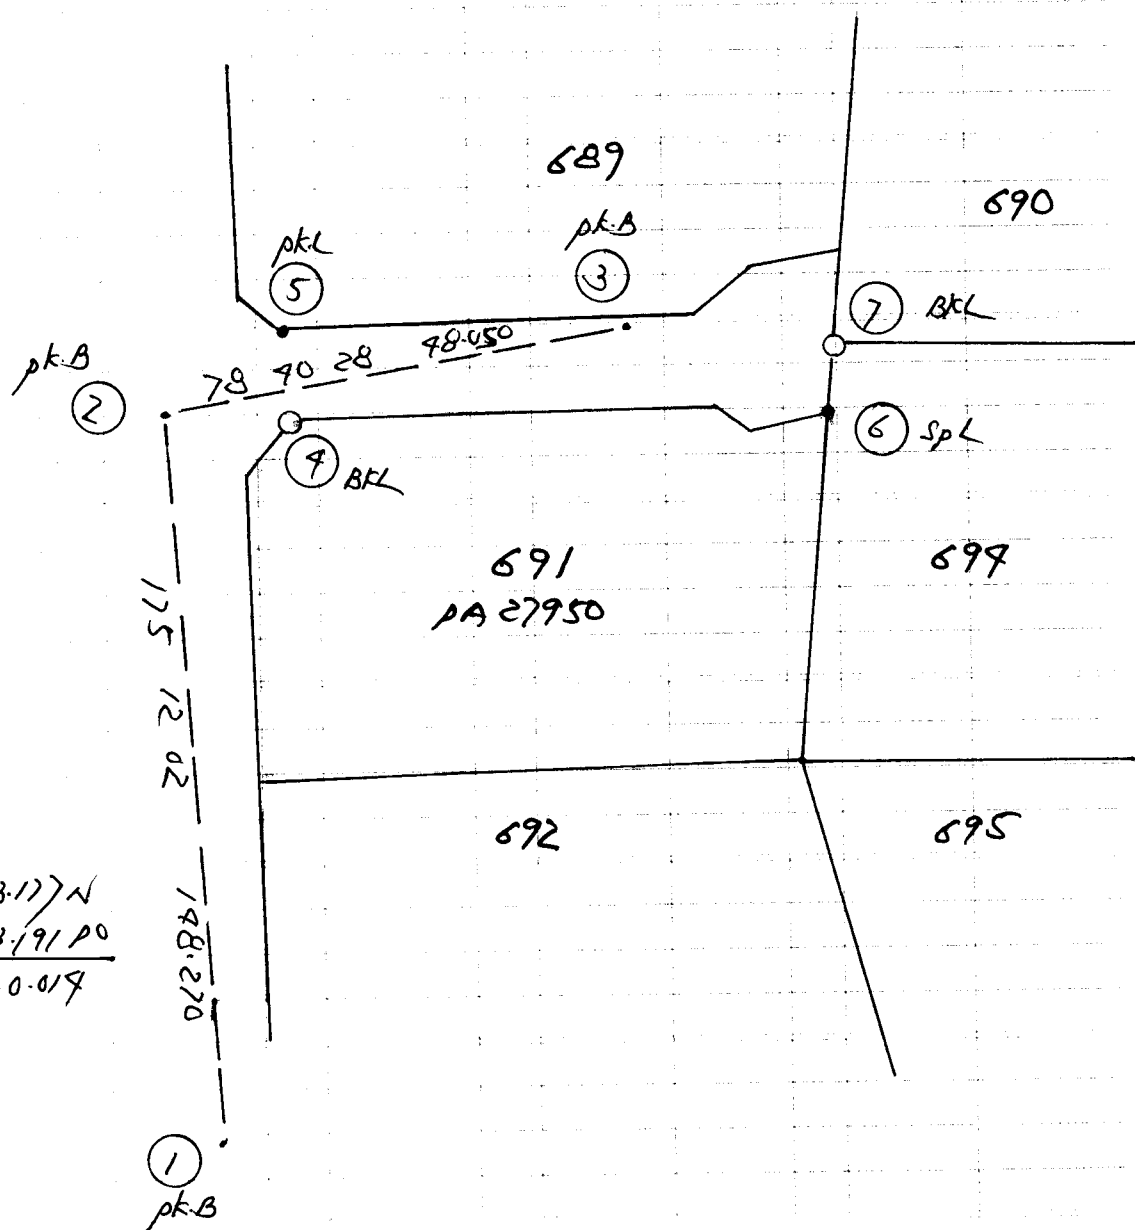

6-9 269 3907 53.177N
269 3906 53.191P0
-1" -0.019

✓ 2396 Rtx Gearing.

Purpose

[illegible]