


JF 707 AJ Sec 3

No. Tail

Rajah di muka

No. Tail	BEARING - SURUT			Dai Sur	DARAN		No. Surut di muka	Jarak	Jarak Antara Surut	Jarak Muktamad
	Surut Kiri	Surut Kanan	Pusat		Bearing Muktamad	pk				
	Datum Daripada			2	139 7357	1	4	27.657		27.657
				pk.B	A3 Ak.	pk.B				
					Agg 605					
1	139 7357	319 7357	173 1318	2	173 1318	3	4	32.786		32.786
2										
3	173 1318	353 1318								
	pk.B									
2-7	175805			2	175805	7	4	2.150	BK	62.150
2-5	28 57 50			2	28 57 50	5	4	39.690	BK	39.690
2-6	1701179			2	1701179	6	4	113.238	BK	113.238
2	353 1318	173 1318	96 1298	3	96 1298	7	4	39.150		39.150
3	96 1298									
7	175095	276 1298								
	pk.B									
	Demarcate.									
2-10	1261037			2	1261037	10	4	23.796	pk.B	23.796
2-11	1532518			2	1532518	11	4	72.971	pk.B	72.971
7-12	1515902			7	1515902	12	4	1.837	pk.B	1.837
7-13	2 9137			7	2 9137	13	4	18.097	pk.B	18.097
7-14	2 0729			7	2 0729	14	4	22.773	pk.B	22.773

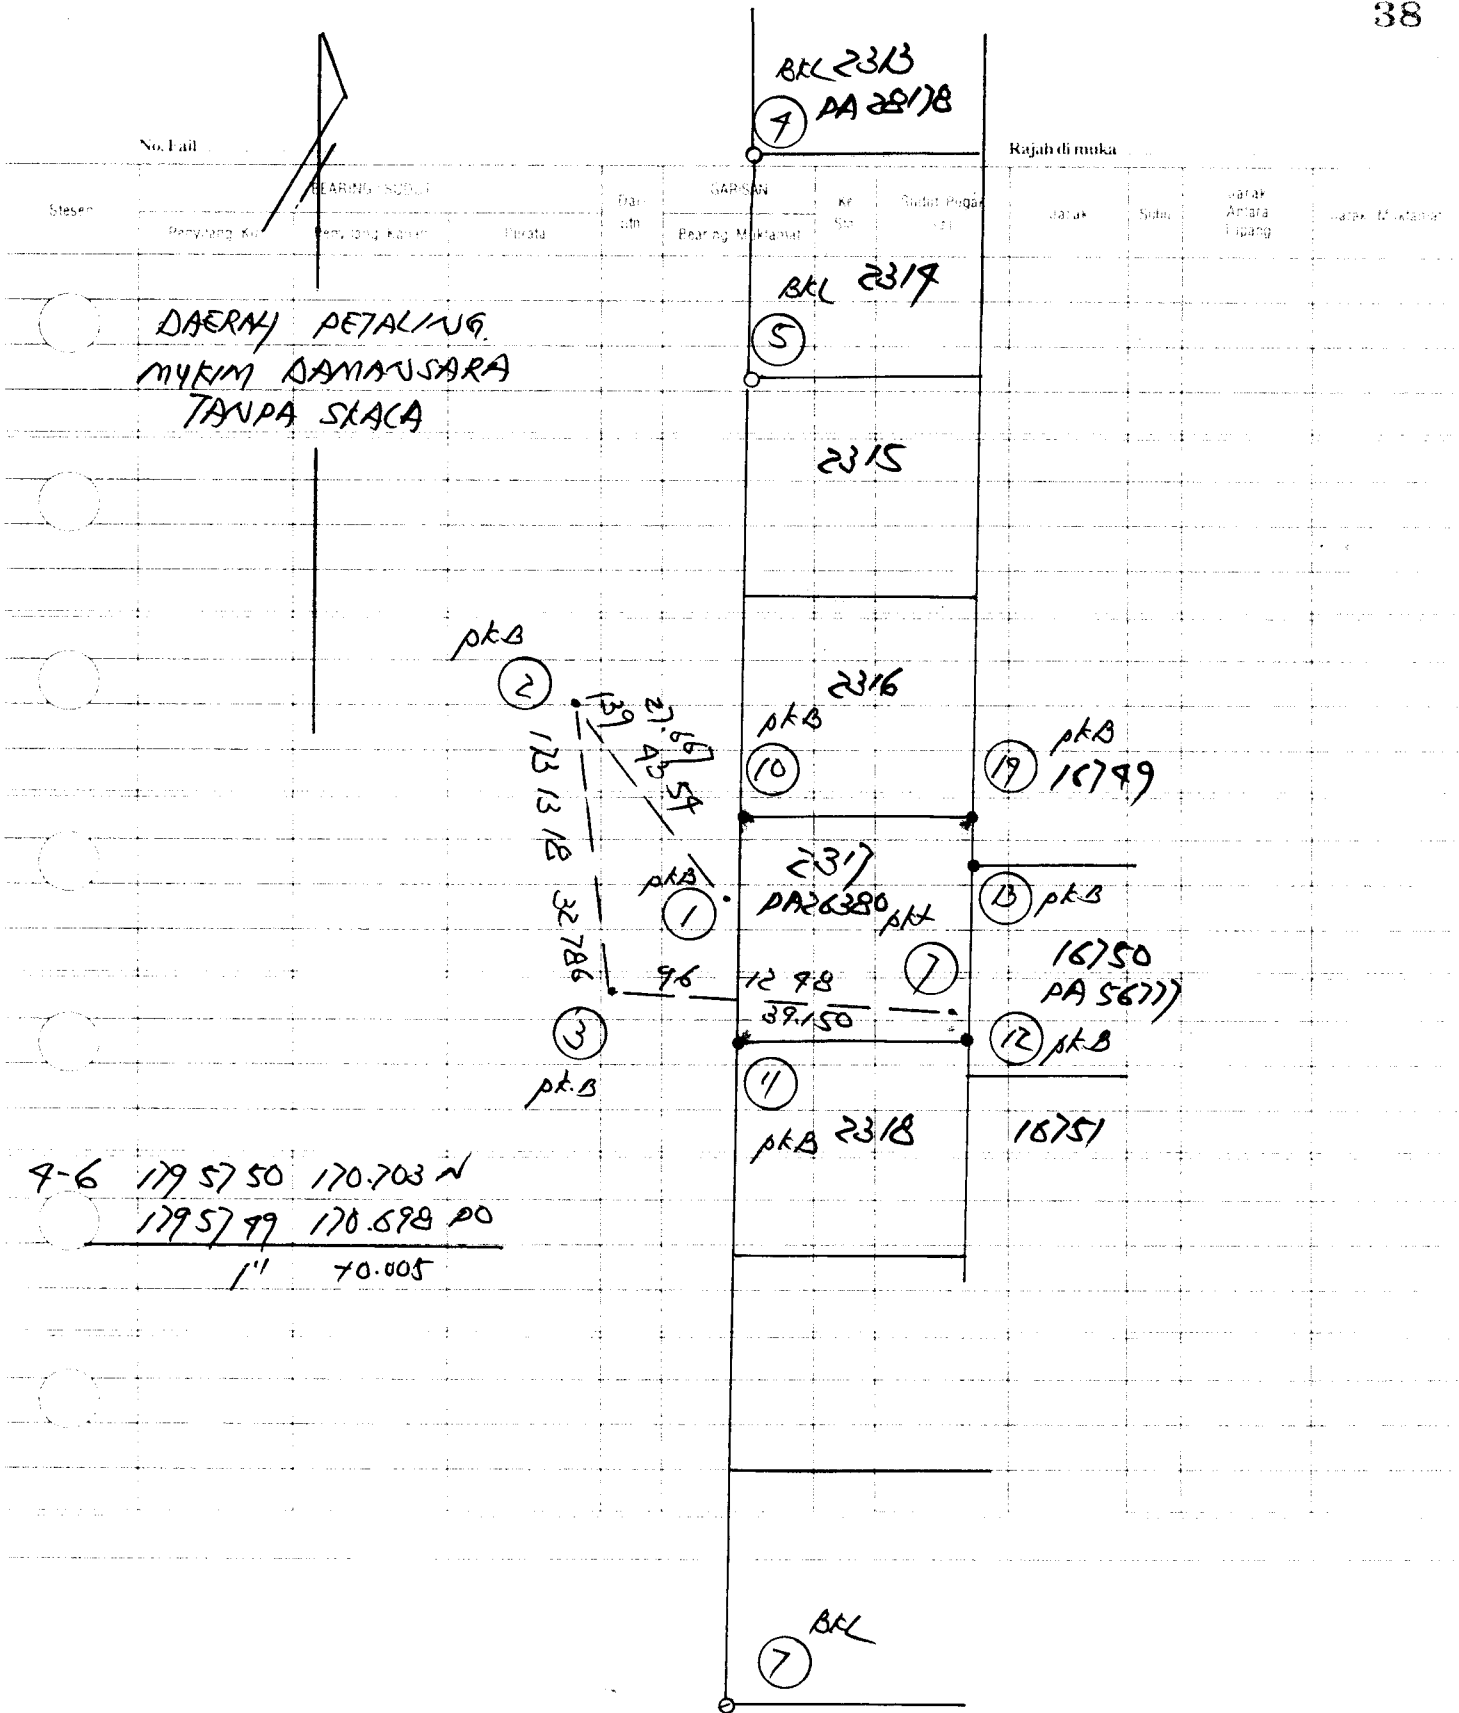

Date _____

Client

52407

AJ Sec 3

Location

21

Purpose

From	To	RL of Station	Inst. Ht.	Bearing	Vertical Angle + or -	Lower Wire	Middle Wire	Upper Wire
1.5225	0.8232					787.9332	787.9332	787.9332
	1.5783					787.9332	787.9332	787.9332
	0.7087					787.9332	787.9332	787.9332

Horiz. Dist.	Ht. Diff. + or -	RL of Inst.	the Centre Reading	m	RL Object

3

Object

Remarks

87672
CH50 sec)

605 km / : 45.758

BM Level: 45.773

10.0/5

FD-302 (Rev. 11-27-70)

Gas km : 48.552

constant : 70.0/5

98.537