

JZ 452 JAI Duckong


Rajah di muka

No. Fail		SEKING		KEL		KEL		KEL	
Stesen	Posyong Kiri	Posyong Kanan	Posyong Kiri	Posyong Kanan	Posyong Kiri	Posyong Kanan	Posyong Kiri	Posyong Kanan	Posyong Kiri
	Datum Daripada		2	359335/1	1	4	103.575	103.575	6/4/2019
				A3 Ak.					
				091 625					
1	359335/1	179335/1	92 2436	2	92 2436	3	4	67.639	67.639
2			3	92 2436	272 2436				
	pkB								
1	Septi	Si Ak	270 4795	2	270 4795	8	4	100.780	100.780
2									
	7	270 4795	90 4795						
	pkB								
3-5	1682220			3	1682220	5	4	66.129	PL 66.129
3-6	2153703			3	2153703	6	4	51.385	pk.LK 51.385
3-7	2992051			3	2992051	7	4	32.201	pk.LK 32.201
3-8	2821613			3	2821613	8	4	39.709	pk.LK 39.709
4-9	552853			4	552853	9	4	37.996	PL 37.996
4-10	2692128			4	2692128	10	4	158.090	PL 158.090

No. 101

Ruang 101

DAERAH DETALING.
DEKAT PUCHONG JAYA
TANPA SKALA

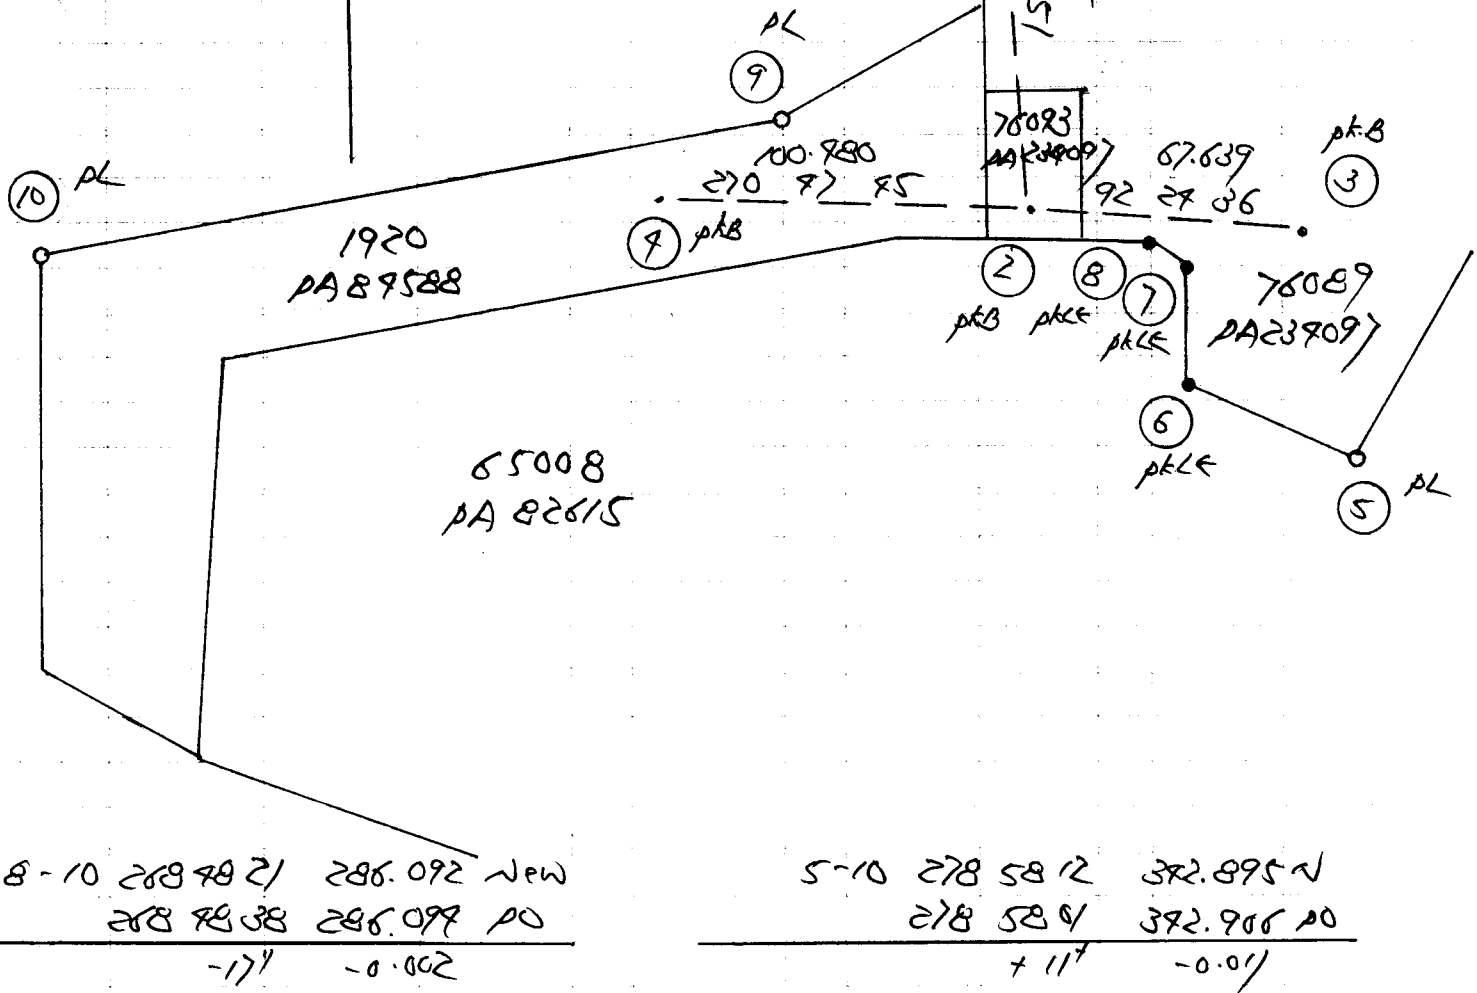

Purpose

[illegible]