

No. Fail J2 478 4551

Rajah di muka

Stesen	BRANCH 2000			Dist. Sta.	BRANCH	Mile	Dist. From	Dist. To
	Dist. into Km.	Dist. along Route	Route		Branch, Markman			
	Datum Sanjapats			2	112 2987	1	4	73.993
					pkB Ag At. pkB			
					Dgn 44/GRS			
1	112 2987	292 2987	116 9330	2	116 9330	3	4	126.101
2								126.101
3	116 9330	296 9330						
	pkB (RM)							
2-4	198 1150			2	198 1150	4	4	39.187
2-5	223 5835			2	223 5835	5	4	72.125
2-6	247 9693			2	247 9693	6	4	22.001
2-7	267 5353			2	267 5353	7	4	17.273
2-8	352 5250			2	352 5250	8	4	32.400
2-9	37 0057			2	37 0057	9	4	29.611
2-10	235 5395			2	235 5395	10	4	8.990

Dymarcate.

2-11	219 4928	15.413	AB
2-12	191 5749	14.902	AB

Grid Line Setting Out.

2-20	203 5535	15.678	HWP	(SA1)
2-21	203 1826	23.102	HWP	(SA)
2-22	202 5858	30.725	HWP	(SC)
2-23	202 5025	35.939	HWP	(SD)
2-24	218 0320	37.397	HWP	(1A)
2-25	220 3621	32.415	HWP	(1C)
2-26	226 0721	25.305	HWP	(1A)
2-27	235 2531	18.775	HWP	(1A1)

No. 101

Rajabul Huda

M. K. H. 1993

793

19/

125

00/


22/

700

6/

990

DAERAH DETALING
DEKAT DENAGA
TANPA SKALA

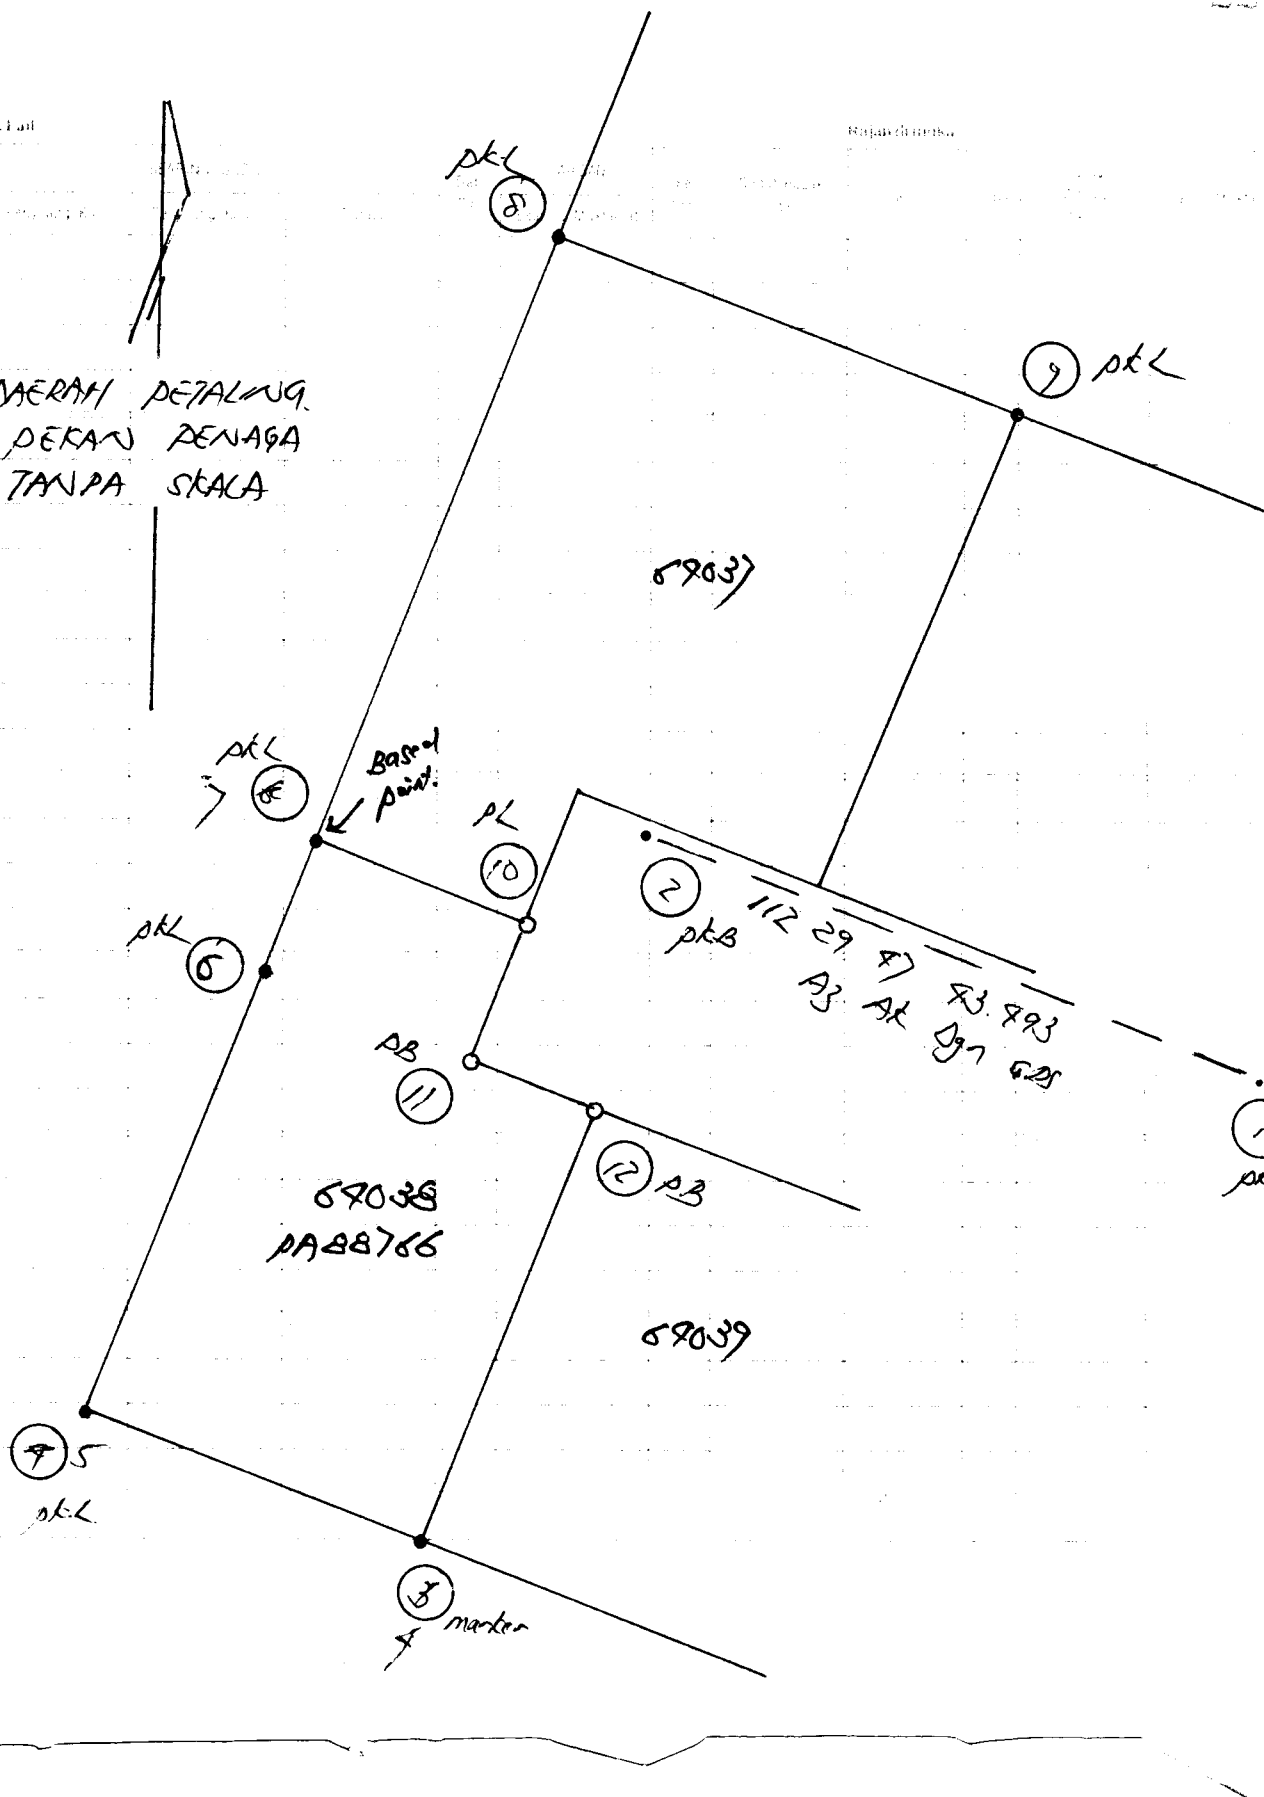

Location JZ 478 457 /

Location JF 4/8 ASD /

Grand Uila.

Horiz. Dist.	Ht. Diff. + or -	RL of Inst.	RL Centre Reading	m	RL Object	Remarks
						BM 262067
						GPS Level: 17.830
						BM Level: 17.781
						+0.089
						7BM 1 / 7BM 3623
						GPS Level: 17.356
						constant: 0.089
						17.267