

JE 486 Kayangan Heights

Rajah di muka

No. Fall

Datum Danjarda

51 1962737 61 4

32.028

12/7/19

32.028

51 1962737 16 2737 3575731 51 3575731 70 4 37.708

37.708

51

70 3575731 1775731

pk.B

51 1775731 3575731 1383091 70 1383091 71 4 22.527

22.527

70

71 1383091 3183091

pk.H

51 Sept Di Atas 171216 70 171216 72 4 26.713

26.713

70

72 171216 1971216

pk.H

70 1971216 171216 1172799 72 1172799 73 4 37.667

37.667

72

73 1172799 2972799

pk.H

72 2972799 1172799 76 5096 73 76 5096 74 4 32.952

32.952

73

74 76 5096 256 5096

pk.B

73 256 5096 76 5096 202 0812 74 202 0812 75 4 31.179

31.179

74

75 202 0812 22 0812

pk.B

No. Earl

Kajonchunaka

Date

No.

Address

No.

Full Name

No. of

No. of

Date

No.

Dancing Master

No.

No. of

No. of

28

79 22 08/12 202 08/12 2853309 75 2853309 71 H 76.875 76.875
 75
 71 2853309 853309

08

75 853309 2853309 318309/ 71 318309/ 70 S/A Liket m/s 35 R3
 71
 70 318309/ 188309/

27

Demarcate.

70-76 1659909

70 1659909 76

H

19.889

pk.B

19.889

70-77 1602006

70 1602006 77

H

13.819

PB

13.819

70-78 562659

70 562659 78

H

3.229

PB

3.229

70-79 15792

70 15792 79

H

8.935

pk.L

8.935

73-80 2173800

73 2173800 80

H

2.899

PB

2.899

79-81 2321803

79 2321803 81

H

11.517

PK

11.517

75-82 2992921

75 2992921 82

H

3.182

PB

3.182

75-83 2109830

75 2109830 83


H

6.353

pk.B

6.353

DAERAH DETAKUNG.
MUKIM BUKIT RAYA
TANPA SKALA

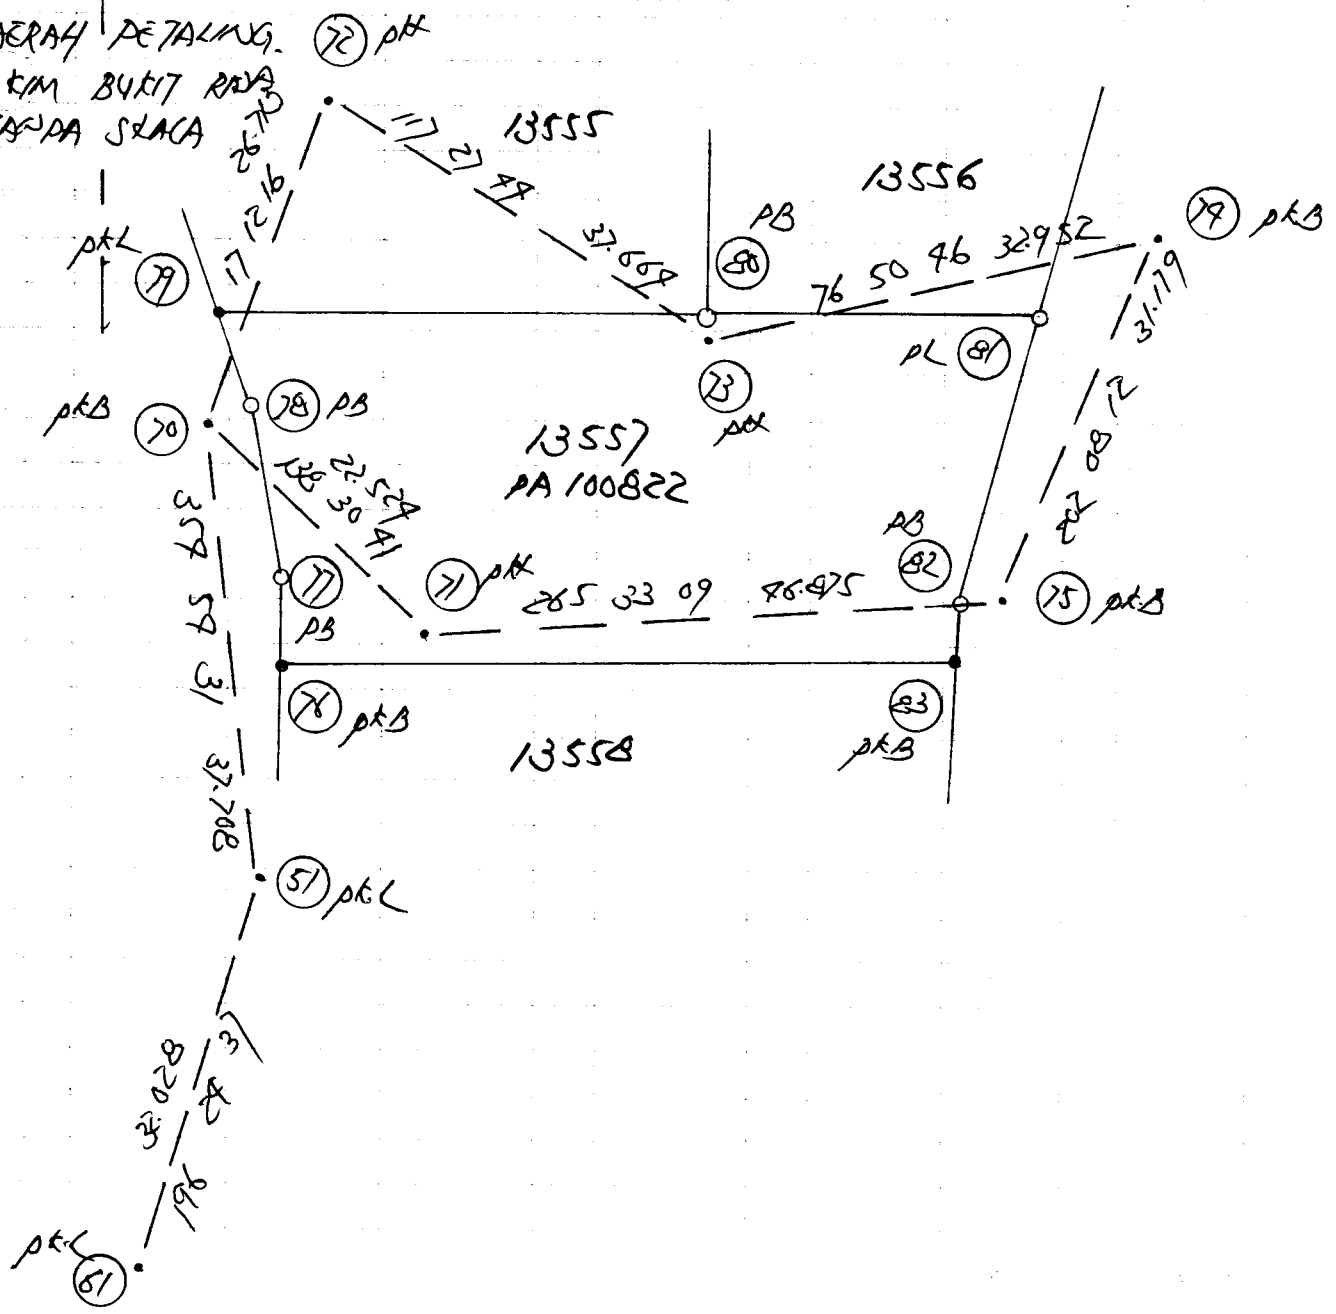

Location JE 986 Kayangan Heights.

Purpose

Gen. No.	Horiz. Dist.	Ht. Diff. + or -	RL of Inst.	RL Centre Reading	m	RL Object	Remarks
		1.563				72.315	J2098 LA 19 m/s 29
		1.589				72.289	F70 (F2008)
	0.156		7.506			69.372	78m F3282
	0.155		7.716			65.112	
	0.255		7.156			61.111	
	0.198		7.513			56.853	
	1.526		7.128			52.873	
			1.056			53.393	78m F2276