

No. Fail JF 510 AJ Sec 9. SA

No. Fail	Subj	Year	Score	Rank	Grade	Remarks
	Datym Sanjeck	1	22/2309	2	H	75.162
	Aj Ak.					
	Ajn MY					
1	9/2309	22/2309	133 9935	2	133 9935	3 H 77.610
2						
3	133 9935	3/13 9935				
	pks					
3-7	329359		3 329359	7	H	15.229
3-5	3593838		3 3593838	5	H	12.791
3-6	319195		3 319195	6	H	31.957
3-7	1702818		3 1702818	7	H	19.295
1-8	1729932		1 1729932	8	H	9.891
2	22/2309	9/2309	1091835	1	1091835	9 H 33.832
1						
9	1091835	2891835				
	pks					
2	Sepet Aj Ak	1992730	1	1992730	10	H 72.382
1						
10	1992730	3292730				
	pks					
1	3292730	1992730	571118	10	571118	11 H 22.611
10						
11	571118	2391118				
	pks					

No. Lail

Kabupaten

STASIS

STASIS

10 287 1118 59 1118 321 9050 11 321 9050 9 4 16.932 16.932

11
9 321 9050 141 9050

11 141 9050 321 9050 287 1835 9 287 1835 1 Sika Lihet m/s 21 R9.
9
1 287 1835 109 1835
Bring
Tutup.

Bring 7-1 Dibaca 287 1835
Spanday 9 Dibaca 287 1835
Tikain N/)
Ambokun N/)

Demarate

11-20	553252	11 553252 20	4	13.576	BKL	13.576
10-21	173 1115	10 173 1115 21	4	1.769	PB	1.769
1-22	100 5396	1 100 5396 22	4	10.792	PB	10.792

DAERAH PETALUNG
SEKSYEN 9

Rajah di bawah

TAJUDA SKACA

No. Fail

Stesen

Pemegang Kiri

REAR HS - SUDUT

Pemegang Kanan

Potato

Das

Stn

GABISAN

Bearing Mukamat

Ke

Stn

Sudut Pagar

(°)


Jarak

Sipit

Antara

Tupang

Jarak Mukamat

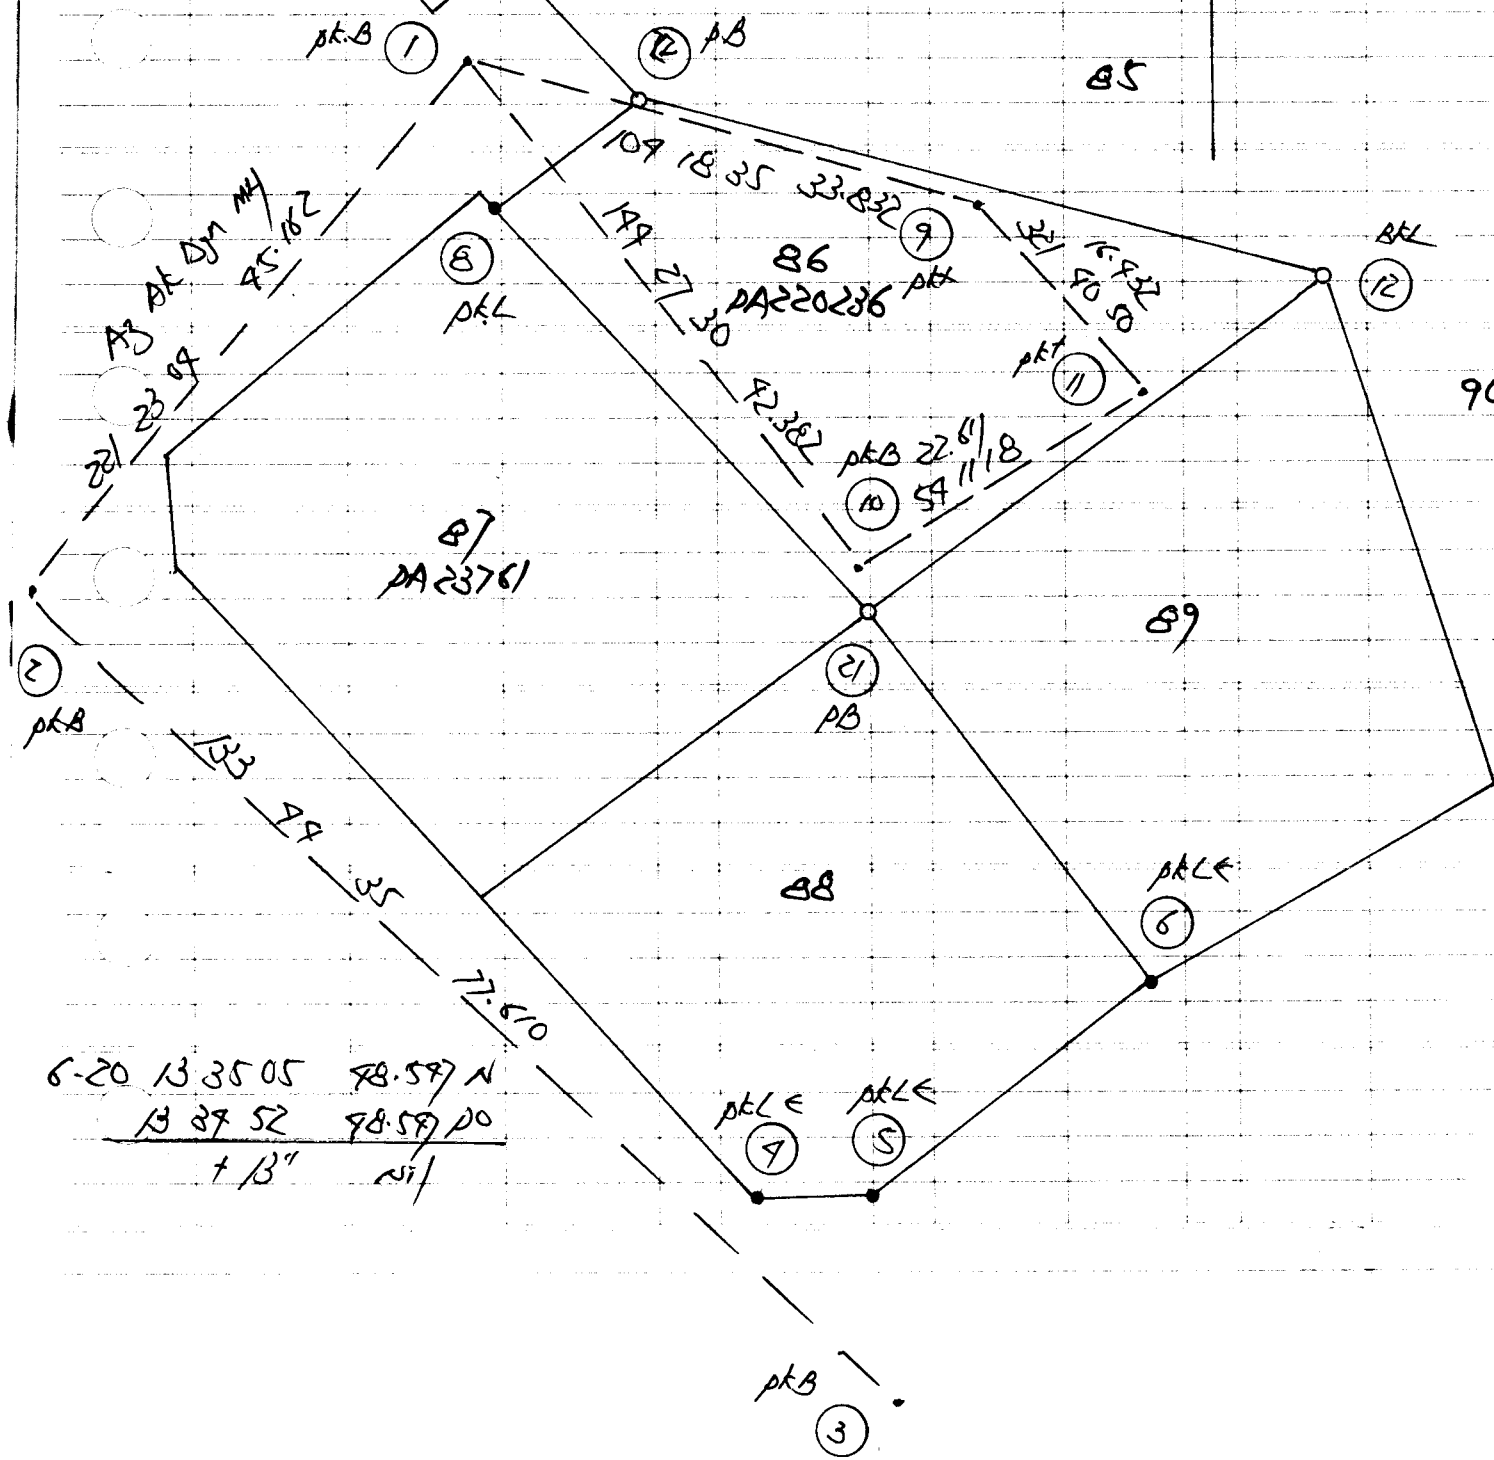

Date .

From

Level Book

[illegible]